



	1	2	3	4	5	6	7
A	<div><div>ABB</div><div>POWER SYSTEMS NETWORK MANAGEMENT PROTECTION AND SUBSTATION AUTOMATION SYSTEMS WBS NO: S-13656</div></div>						
B							
C	CONTRACTOR : ABB Contracting Company						
D	CLIENT : National Gridsa						
E	PROJECT : CONSTRUCTION OF NEW 132/13.8kV SS 8						
F	SUBSTATION : S/S 8709						
	CONTRACT NO. : 11131113/00						
	TITLE : Assembly Drawing – +R01.1 [GT-2]						

G	AS-BUILT BY _____ DATE _____		CONTRACT NO. 11131113/00	JOB ORDER NO. S-13656	COVER SHEET	
	01	13 49	FACTORY ASBUILT	DRAWN BY RIZ CHECKED BY JKR	132/13.8kV GT-2 RELAY PANEL-1 +R01.1	
	00	13 04	FOR APPROVAL	DATE STARTED 24.01.2013 DATE COMPLETED _____	S/S 8709-132/13.8KV IN AL-KHARJ CITY	
	REV. NO.	DATE	DESCRIPTION	OPRG. DEPT. CTPD ENG. DEPT. AUT-PSAC	RIYADH SAUDI ARABIA	

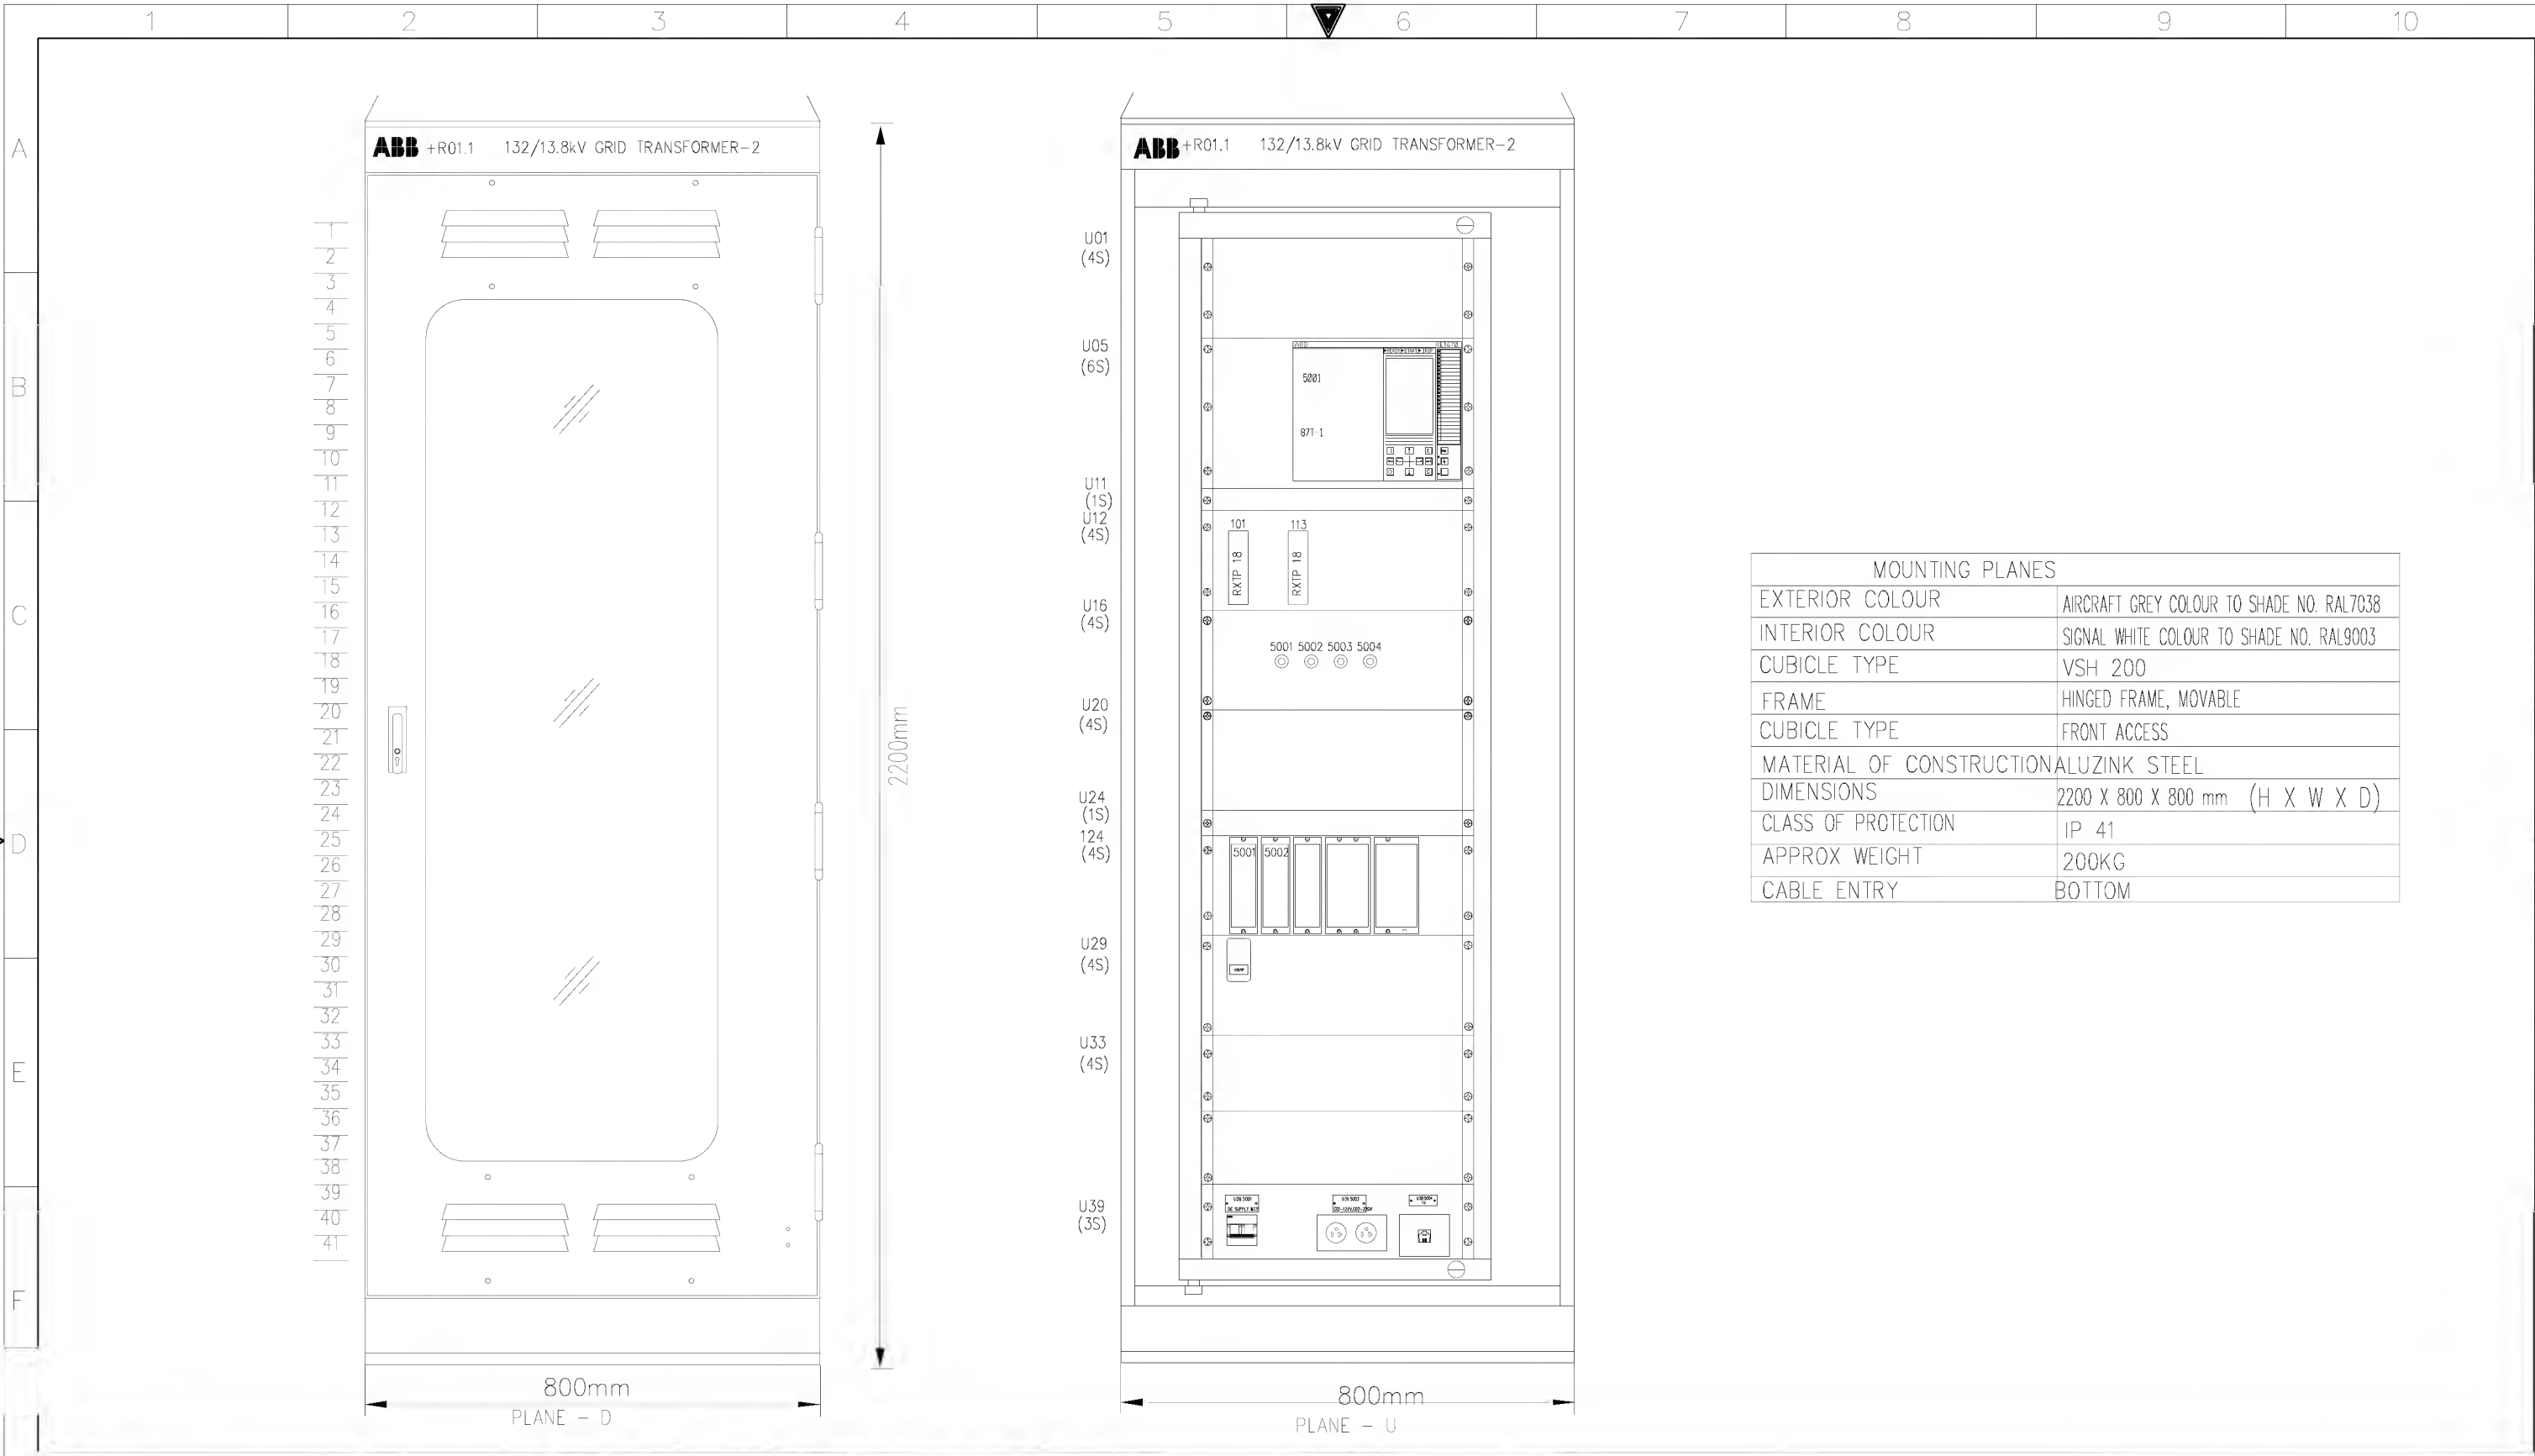

AS-BUILT BY _____ DATE _____			CONTRACT NO. 11131113/00		JOB ORDER NO. S-13656		ASSEMBLY DRAWING		الشركة الوطنية لنقل الكهرباء		نقل الكهرباء	
01 13 49 FACTORY ASBUILT			DRAWN BY RIZ		CHECKED BY JKR		132/13.8kV GT-2 RELAY PANEL-1 +R01.1		National Grid sa			
00 13 04 FOR APPROVAL			DATE STARTED 24.01.2013		DATE COMPLETED _____		S/S 8709-132/13.8KV IN AL-KHARJ CITY		INDEX		SHEET NO.	
REV. NO. DATE DESCRIPTION			OPRG. DEPT. CTPD		ENG. DEPT. AUT-PSAC		RIYADH SAUDI ARABIA		PLANT NO.		DRAWING NUMBER	
									- C421		CD-322929	
											SHT CONT.	
											G01 G02	
											01	

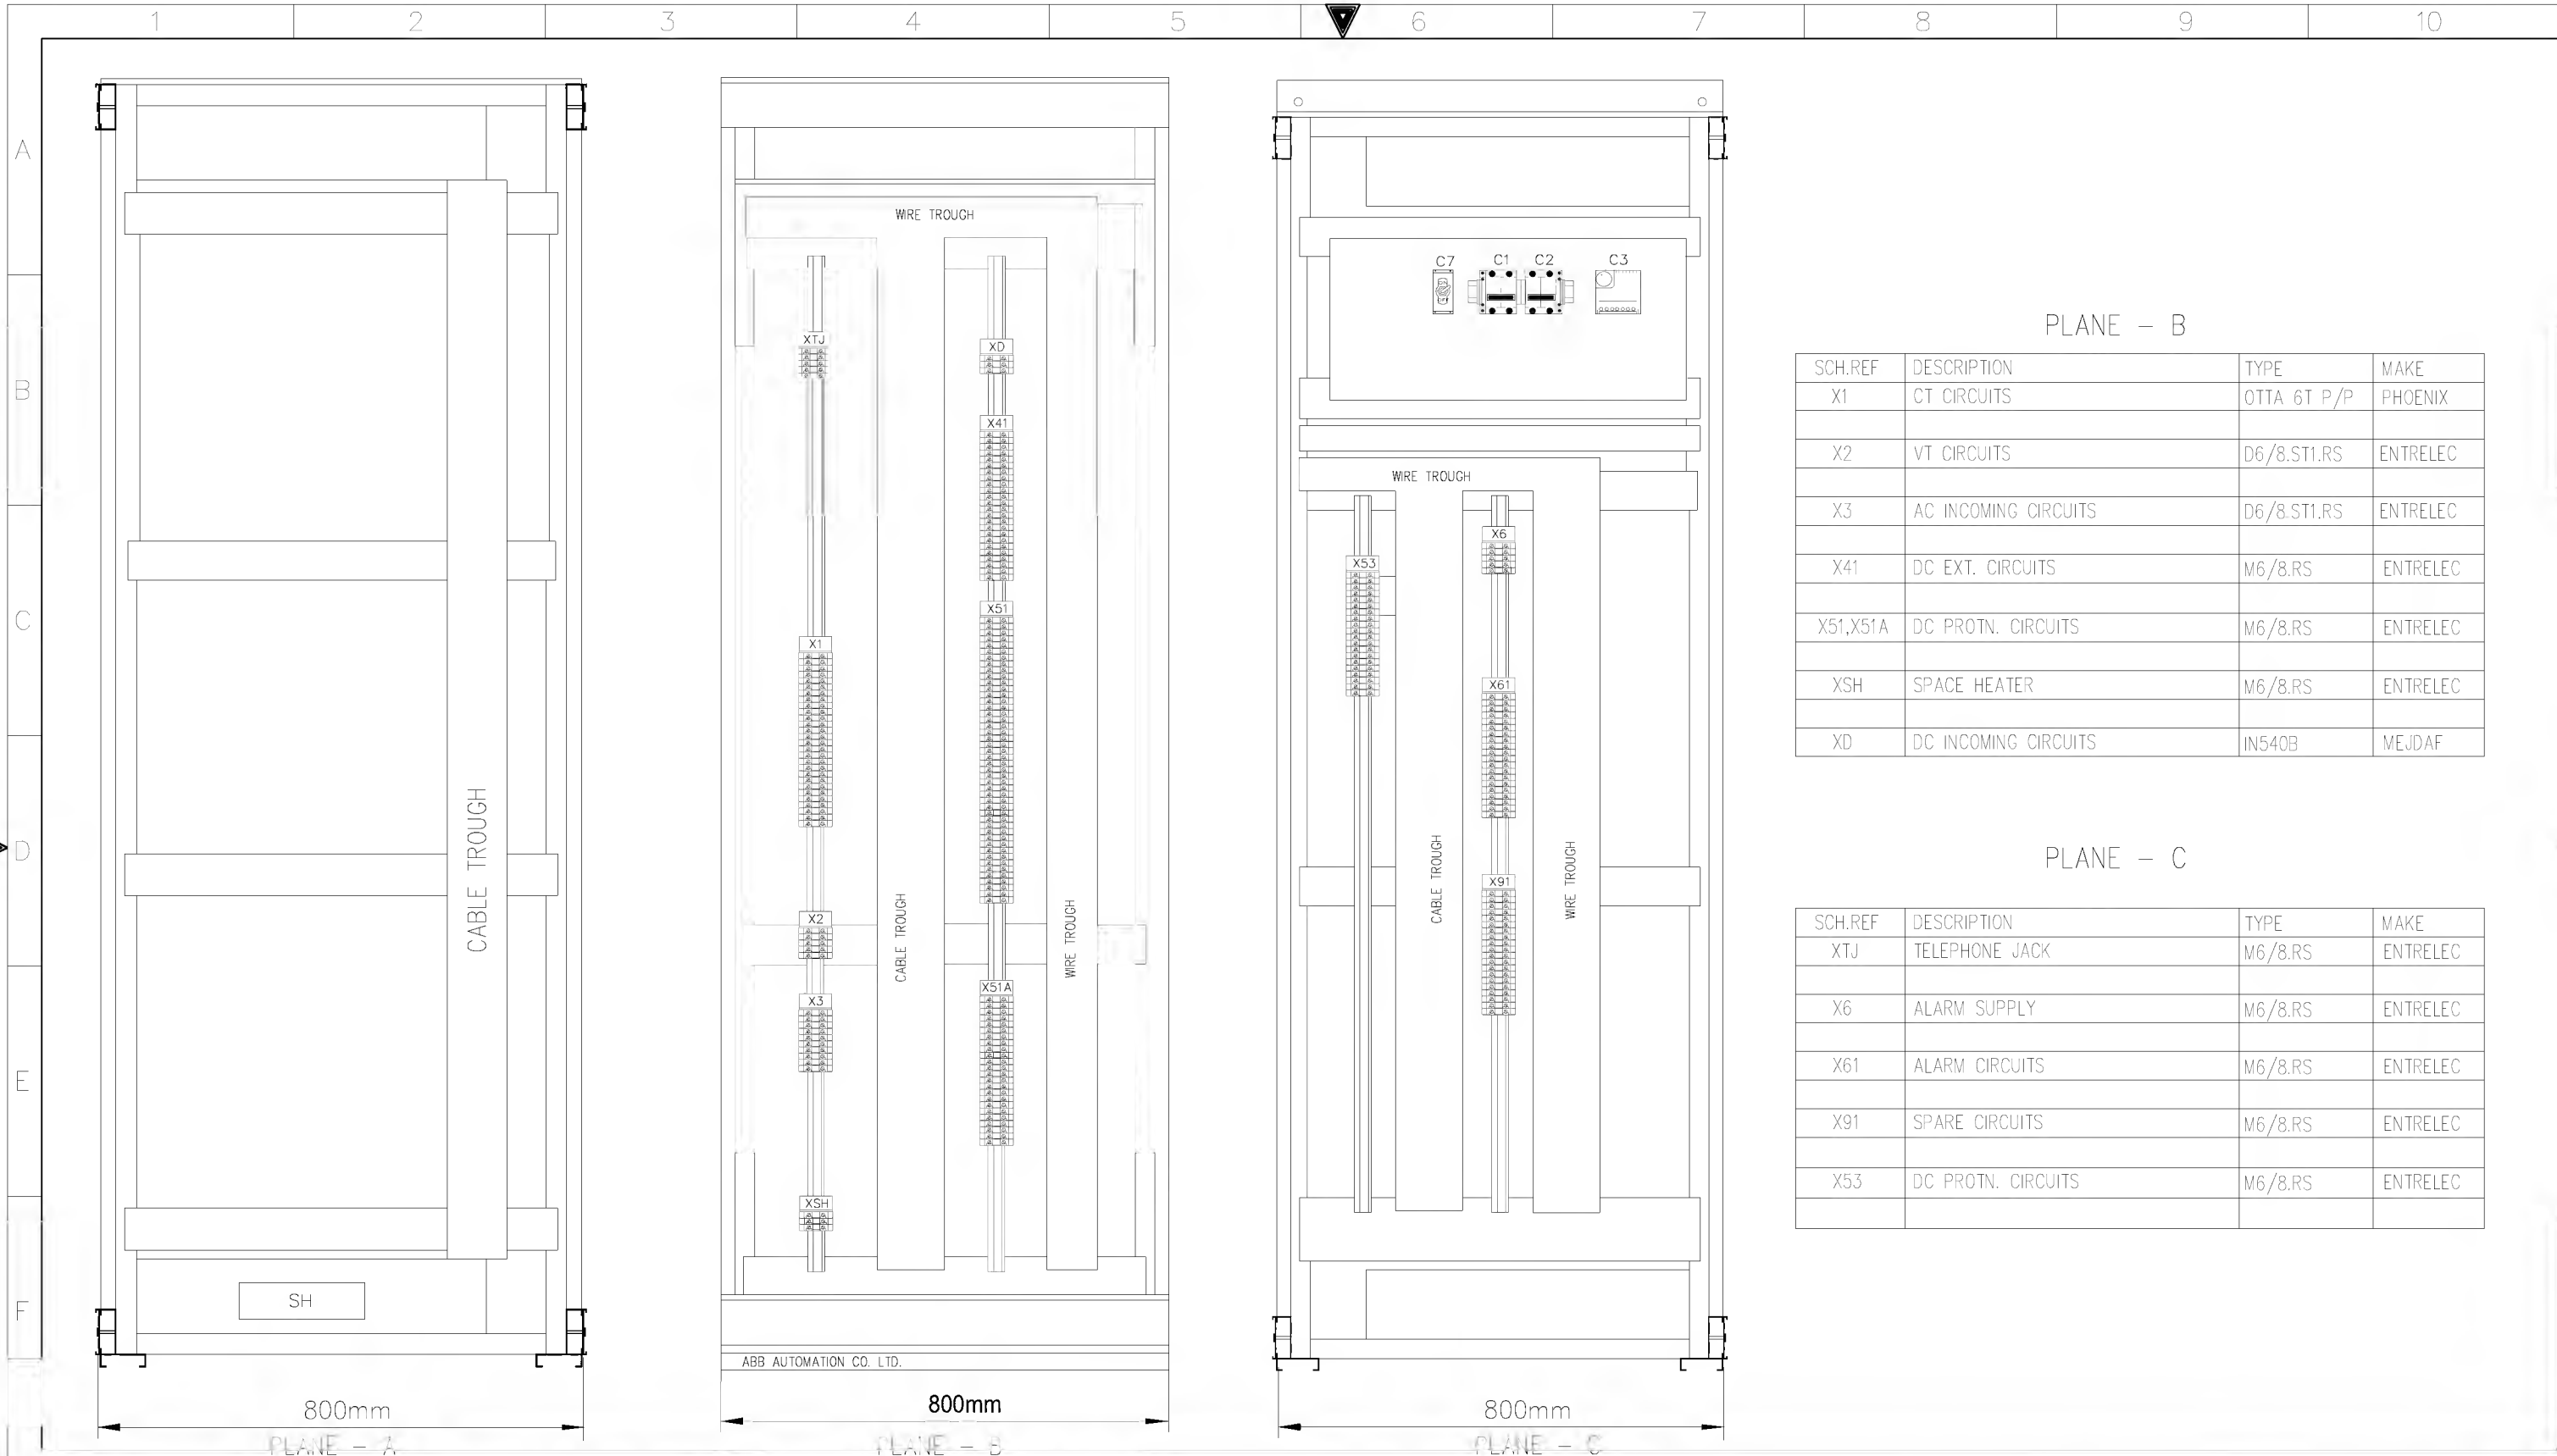


PLANE – B

SCH.REF	DESCRIPTION	TYPE	MAKE
X1	CT CIRCUITS	OTTA 6T P/P	PHOENIX
X2	VT CIRCUITS	D6/8.ST1.RS	ENTRELEC
X3	AC INCOMING CIRCUITS	D6/8.ST1.RS	ENTRELEC
X41	DC EXT. CIRCUITS	M6/8.RS	ENTRELEC
X51,X51A	DC PROTN. CIRCUITS	M6/8.RS	ENTRELEC
XSH	SPACE HEATER	M6/8.RS	ENTRELEC
XD	DC INCOMING CIRCUITS	IN540B	MEJDAF

PLANE – C

SCH.REF	DESCRIPTION	TYPE	MAKE
XTJ	TELEPHONE JACK	M6/8.RS	ENTRELEC
X6	ALARM SUPPLY	M6/8.RS	ENTRELEC
X61	ALARM CIRCUITS	M6/8.RS	ENTRELEC
X91	SPARE CIRCUITS	M6/8.RS	ENTRELEC
X53	DC PROTN. CIRCUITS	M6/8.RS	ENTRELEC

AS-BUILT BY _____ DATE _____			CONTRACT NO. 11131113/00		JOB ORDER NO. S-13656	
G	01	13 49	FACTORY ASBUILT		DRAWN BY RIZ CHECKED BY JKR	
	00	13 04	FOR APPROVAL		DATE STARTED 24.01.2013 DATE COMPLETED _____	
	REV. NO.	DATE	DESCRIPTION		OPRG. DEPT. CTPD ENG. DEPT. AUT-PSAC	
ASSEMBLY DRAWING						الشركة الوطنية لنقل الكهرباء National Grid sa
132/13.8kV GT-2 RELAY PANEL-1 +R01.1						
S/S 8709-132/13.8KV IN AL-KHARJ CITY						
RIYADH SAUDI ARABIA						INDEX - C421
						PLANT NO. CD-322929
						DRAWING NUMBER
						SHEET NO. SHT CONT.
						REV. NO. 01

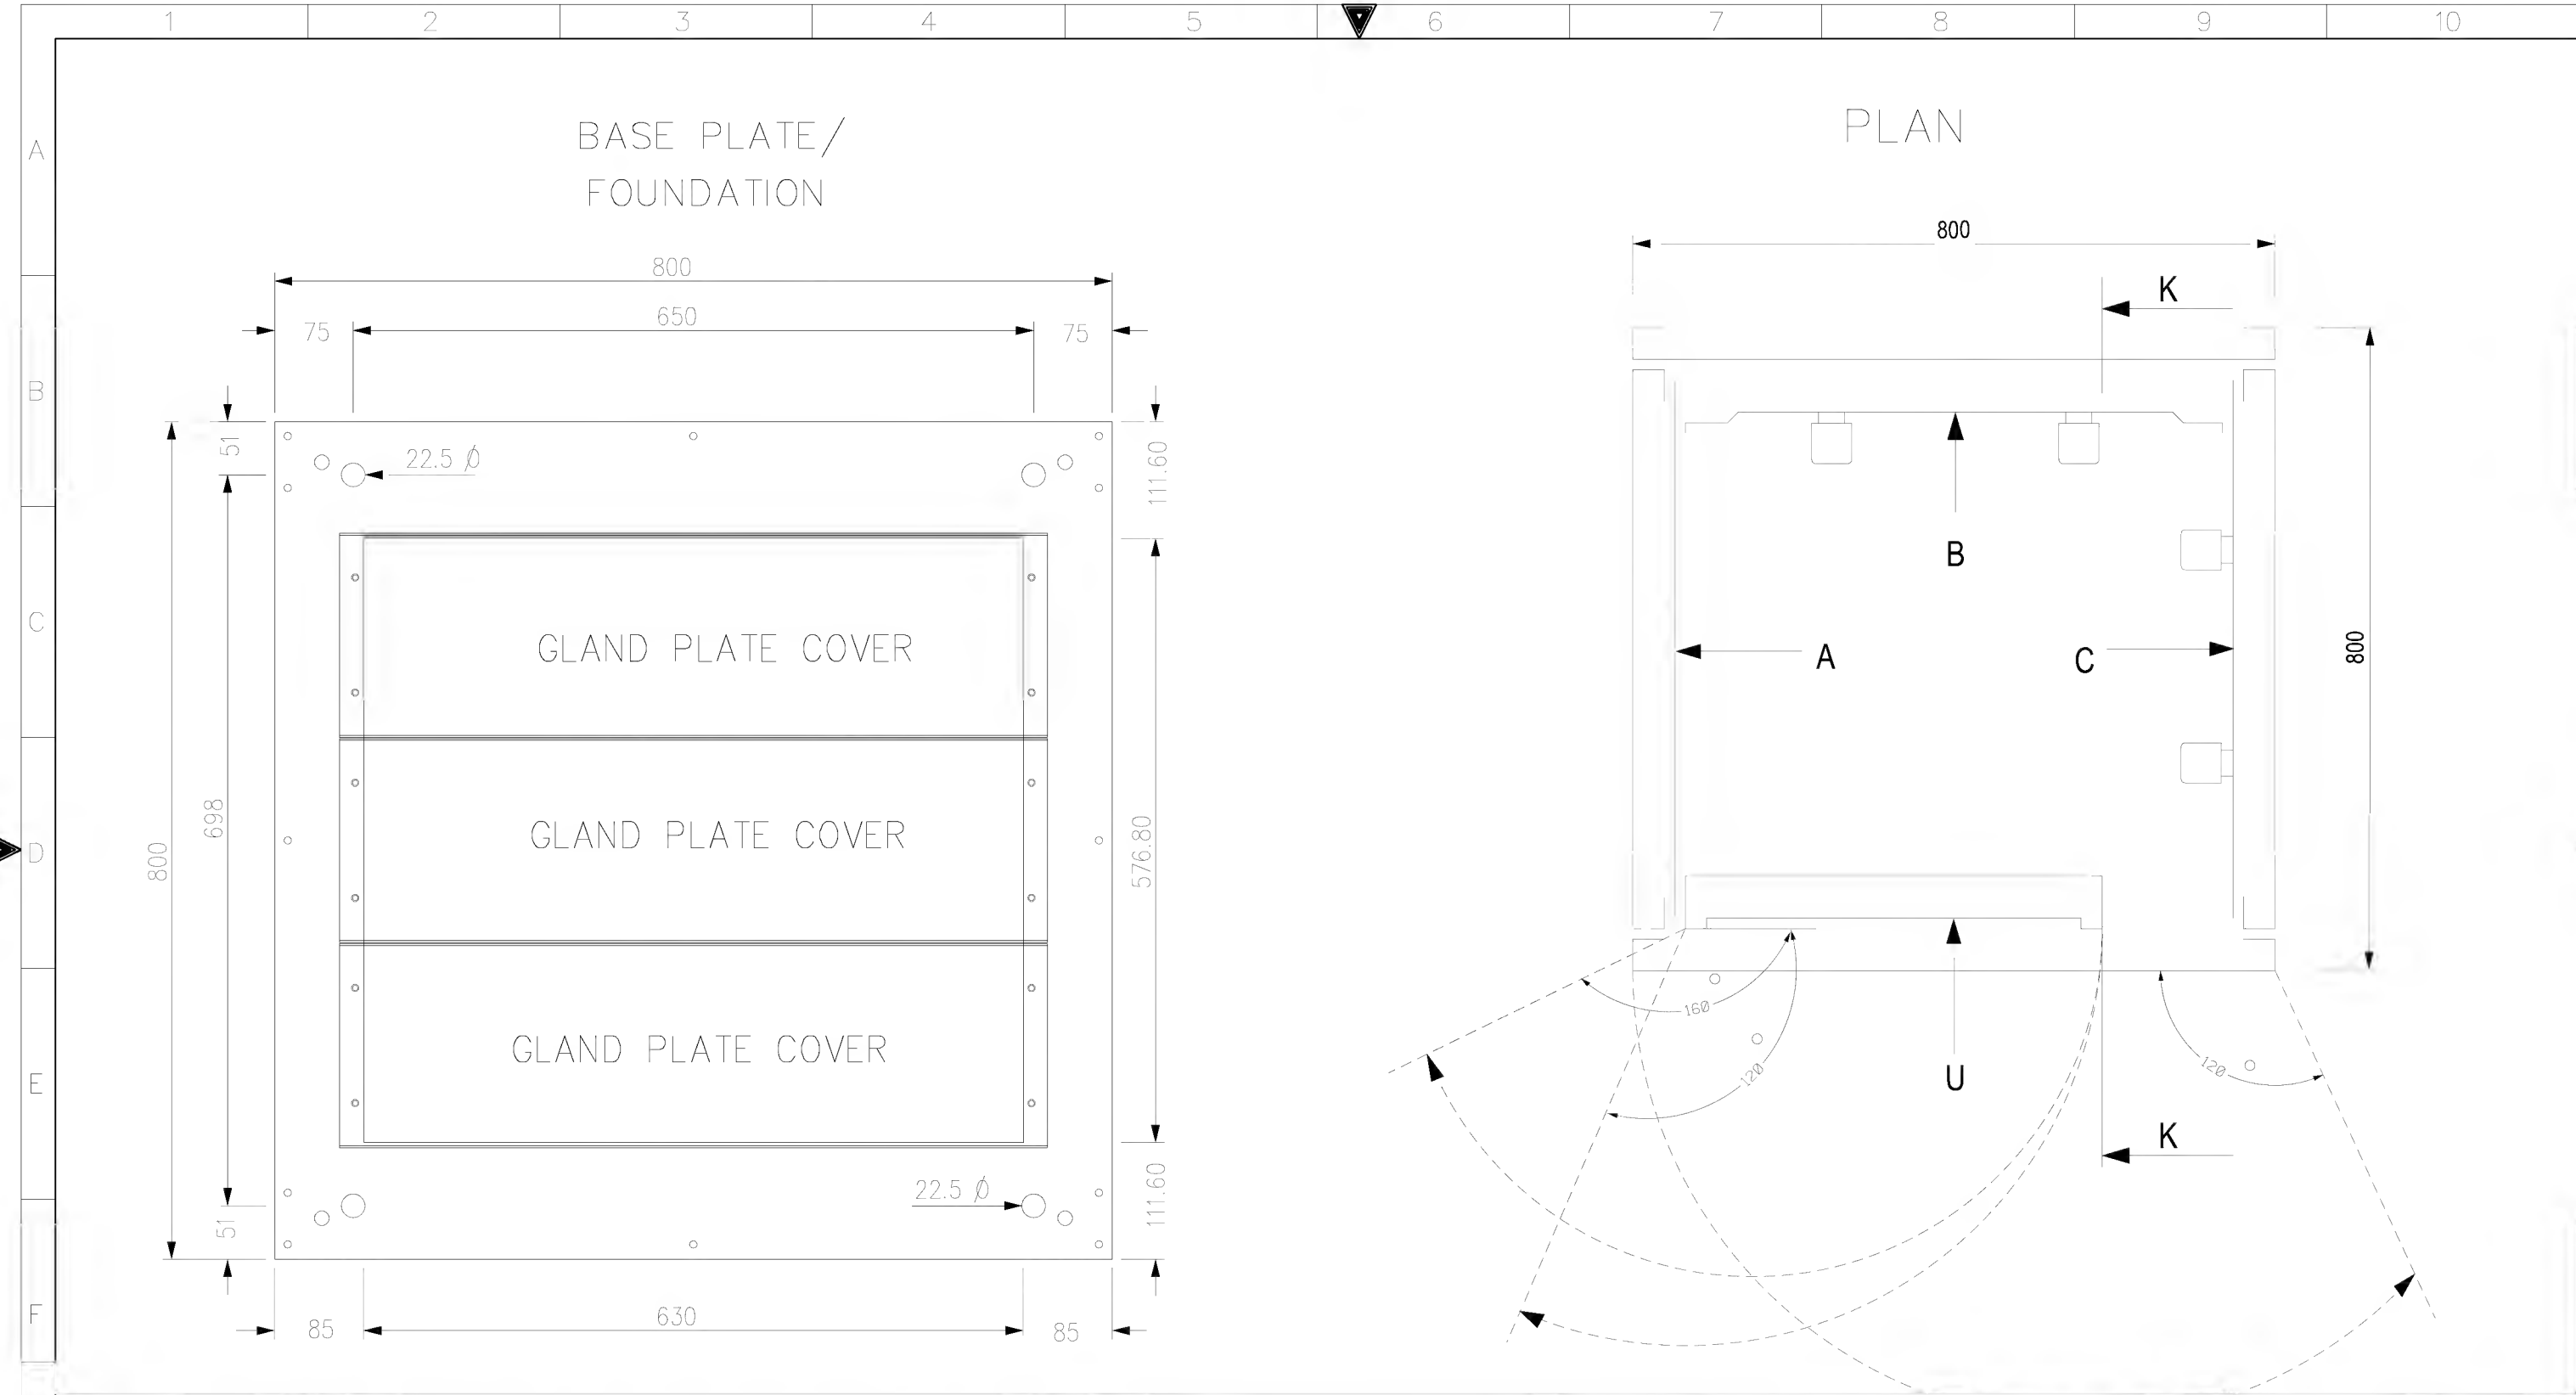

AS-BUILT BY _____ DATE _____ CONTRACT NO. 11131113/00 JOB ORDER NO. S-13656

01	13 49	FACTORY ASBUILT
00	13 04	FOR APPROVAL
REV. NO.	DATE	DESCRIPTION

DRAWN BY RIZ CHECKED BY JKR
DATE STARTED 24.01.2013 DATE COMPLETED _____
OPRG. DEPT. CTPD ENG. DEPT. AUT-PSAC

ASSEMBLY DRAWING
132/13.8kV GT-2 RELAY PANEL-1 +R01.1
S/S 8709-132/13.8KV IN AL-KHARJ CITY
RIYADH SAUDI ARABIA

الشركة الوطنية لنقل الكهرباء		نقل الكهرباء		National Grid sa	
INDEX	PLANT NO.	DRAWING NUMBER		SHEET NO.	
-	C421	CD-322929		SHT	CONT.
				G03	G04
				REV. NO.	
				01	

A

B

C

D


E

F



TOP VIEW FOR EARTHING BAR

U PLANE TOP LABEL

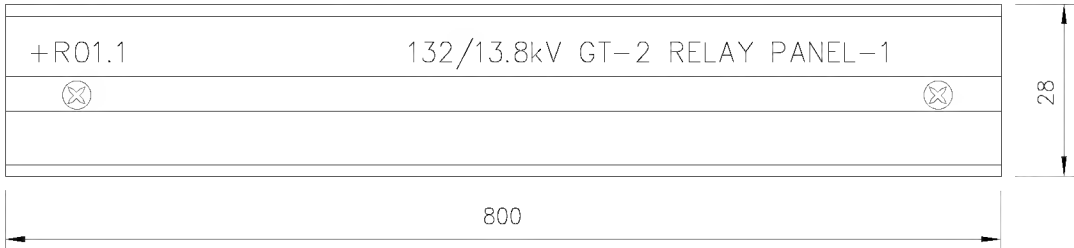

U PLANE BOTTOM LABEL



MANUFACTURING LABEL

ABB
ABB Automation Co.Ltd.

PROJECT : National Grid SA
S/S 8709

ORDER REFERENCE : 2875 RF S13656


YEAR OF MANUFACTURE: 2013


PANEL NO. : +R01.1


DRAWING NO. : S13656-CD-323931

MADE IN THE KINGDOM OF SAUDI ARABIA

G

AS-BUILT BY _____ DATE _____			CONTRACT NO. 11131113/00		JOB ORDER NO. S-13656		ASSEMBLY DRAWING			<div>الشركة الوطنية لنقل الكهرباء</div> <div> نقل الكهرباء National Grid sa</div>					
01	13 49	FACTORY ASBUILT	DRAWN BY RIZ		CHECKED BY JKR		132/13.8kV GT-2 RELAY PANEL-1 +R01.1			INDEX	PLANT NO.	DRAWING NUMBER	SHEET NO.		REV. NO.
00	13 04	FOR APPROVAL	DATE STARTED 24.01.2013		DATE COMPLETED _____		S/S 8709-132/13.8KV IN AL-KHARJ CITY						SHT	CONT.	
REV. NO.	DATE	DESCRIPTION	OPRG. DEPT. CTPD		ENG. DEPT. AUT-PSAC		RIYADH SAUDI ARABIA			-	C421	CD-322929	G04	L00	01

	1	2	3	4	5	6	7	8	9	10
A			POWER SYSTEMS NETWORK MANAGEMENT PROTECTION AND SUBSTATION AUTOMATION SYSTEMS WBS NO: S-13656					ABB AUTOMATION COMPANY LTD., 414, AL-KHARJ ROAD SECOND INDUSTRIAL CITY RIYADH-11383 K.S.A		
B										
C										
D	CONTRACTOR : ABB Contracting Company									
	CLIENT : National Gridsa									
	PROJECT : CONSTRUCTION OF NEW 132/13.8kV SS 8709 IN AL-KHARJ CITY									
	SUBSTATION : S/S 8709									
E	CONTRACT NO. : 11131113/00									
F	TITLE : LIST OF APPARATUS +R01.1 [GT-2]									

G	AS-BUILT BY _____ DATE _____		CONTRACT NO. 11131113/00	JOB ORDER NO. S-13656	COVER SHEET		 نقل الكهرباء الشركة الوطنية لنقل الكهرباء National Grid sa				
	01	13 49	FACTORY ASBUILT	DRAWN BY RIZ	CHECKED BY JKR	132/13.8kV GT-2 RELAY PANEL-1 +R01.1	INDEX	PLANT NO.	DRAWING NUMBER	SHEET NO.	REV. NO.
	00	13 04	FOR APPROVAL	DATE STARTED 24.01.2013	DATE COMPLETED	S/S 8709-132/13.8KV IN AL-KHARJ CITY	-	C421	CD-322929	SHT L00	CONT. L01
	REV. NO.	DATE	DESCRIPTION	OPRG. DEPT. CTPD	ENG. DEPT. AUT-PSAC	RIYADH					01

	1	2	3	4	5	6	7	8	9	10
A										
B										
C										
D										
E										
F										

AS-BUILT BY _____ DATE _____ CONTRACT NO. 11131113/00 JOB ORDER NO. S-13656

01	13 49	FACTORY ASBUILT	DRAWN BY RIZ	CHECKED BY JKR
00	13 04	FOR APPROVAL	DATE STARTED 24.01.2013	DATE COMPLETED _____
REV. NO.	DATE	DESCRIPTION	OPRG. DEPT. CTPD	ENG. DEPT. AUT-PSAC

LIST OF APPARATUS
132/13.8kV GT-2 RELAY PANEL-1 +R01.1
S/S 8709-132/13.8KV IN AL-KHARJ CITY
RIYADH SAUDI ARABIA

الشركة الوطنية لنقل الكهرباء		نقل الكهرباء		National Grid sa	
INDEX	PLANT NO.	DRAWING NUMBER		SHEET NO.	
-	C421	CD-322929		SHT	CONT.
				L04	L05
				01	


	1	2	3	4	5	6	7	8	9	10
A										
B										
C										
D										
E										
F										


LABEL REF.	LABEL ENGRAVING	MATERIALS	ENGRAVING	LABEL SIZE	LETTER SIZE
U05.5001	U05.5001 87T1	TRAFOLITE	BLACK LETTERS ON WHITE BACKGROUND	50X15mm	4mm
U12.101	U12.101 TS-1	ALUMINUM PAPER FOIL	BLACK LETTERS	50X10mm	3mm
U12.113	U12.113 TS-2	ALUMINUM PAPER FOIL	BLACK LETTERS	50X10mm	3mm
U16.5001	U16.5001 S86T1	TRAFOLITE	BLACK LETTERS ON WHITE BACKGROUND	50X15mm	4mm
U16.5002	U16.5002 S86CBF	TRAFOLITE	BLACK LETTERS ON WHITE BACKGROUND	50X15mm	4mm
U16.5003	U16.5003 S86B-1	TRAFOLITE	BLACK LETTERS ON WHITE BACKGROUND	50X15mm	4mm
U16.5004	U16.5004 S86B-2	TRAFOLITE	BLACK LETTERS ON WHITE BACKGROUND	50X15mm	4mm
U25.5001	U25.5001 86T1	TRAFOLITE	BLACK LETTERS ON WHITE BACKGROUND	50X15mm	4mm
U25.5002	U25.5002 94T1	TRAFOLITE	BLACK LETTERS ON WHITE BACKGROUND	50X15mm	4mm
U25.5003	U25.5003 86CBF	TRAFOLITE	BLACK LETTERS ON WHITE BACKGROUND	50X15mm	4mm
U25.5004	U25.5004 86B-1	TRAFOLITE	BLACK LETTERS ON WHITE BACKGROUND	50X15mm	4mm
U25.5005	U25.5005 86B-2	TRAFOLITE	BLACK LETTERS ON WHITE BACKGROUND	50X15mm	4mm
U29.101	U29.101 74R1	ALUMINUM PAPER FOIL	BLACK LETTERS	50X10mm	3mm
U29.107	U29.107 TMR/86B-1	ALUMINUM PAPER FOIL	BLACK LETTERS	50X10mm	3mm
U29.301	U29.301 TMR/86B-2	ALUMINUM PAPER FOIL	BLACK LETTERS	50X10mm	3mm
U29.307	U29.307 R2	ALUMINUM PAPER FOIL	BLACK LETTERS	50X10mm	3mm
U29.113	U29.113 R1	ALUMINUM PAPER FOIL	BLACK LETTERS	50X10mm	3mm
U39.5001	U39.5001 Q1	ALUMINUM PAPER FOIL	BLACK LETTERS	50X10mm	3mm
U39.5002	U39.5002 Q2	ALUMINUM PAPER FOIL	BLACK LETTERS	50X10mm	3mm
U36.5001	U36.5001 Q3	ALUMINUM PAPER FOIL	BLACK LETTERS	50X10mm	3mm


	1	2	3	4	5	6	7	8	9	10
A										
B										
C										
D										
E										
F										

LABEL REF.	LABEL ENGRAVING	MATERIALS	ENGRAVING	LABEL SIZE	LETTER SIZE
C1	C1 127V AC SUPPLY MCB	TRAFOLITE	BLACK LETTERS ON WHITE BACKGROUND	50X15mm	4mm
C2	C2 220V AC SUPPLY MCB	TRAFOLITE	BLACK LETTERS ON WHITE BACKGROUND	50X15mm	4mm
C3	C3 THERMOSTAT	TRAFOLITE	BLACK LETTERS ON WHITE BACKGROUND	50X15mm	4mm
C7	C7 ON/OFF SWITCH	TRAFOLITE	BLACK LETTERS ON WHITE BACKGROUND	50X15mm	4mm
DS	DS DOOR SWITCH	TRAFOLITE	BLACK LETTERS ON WHITE BACKGROUND	50X15mm	4mm
IL	IL ILLUMINATION LAMP	TRAFOLITE	BLACK LETTERS ON WHITE BACKGROUND	50X15mm	4mm
SH	SH SPACE HEATER	TRAFOLITE	BLACK LETTERS ON WHITE BACKGROUND	50X15mm	4mm

AS-BUILT BY _____ DATE _____			CONTRACT NO. 11131113/00		JOB ORDER NO. S-13656		LIST OF APPARATUS		<div>الشركة الوطنية لنقل الكهرباء</div> <div>نقل الكهرباء</div> <div>National Grid sa</div>							
			DRAWN BY RIZ		CHECKED BY JKR		132/13.8kV GT-2 RELAY PANEL-1 +R01.1									
01	13 49	FACTORY ASBUILT		DATE STARTED 24.01.2013		DATE COMPLETED _____		S/S 8709-132/13.8KV IN AL-KHARJ CITY		INDEX	PLANT NO.	DRAWING NUMBER		SHEET NO.		REV. NO.
00	13 04	FOR APPROVAL		OPRG. DEPT. CTFD		ENG. DEPT. AUT-PSAC		RIYADH SAUDI ARABIA		-	C421	CD-322929		SHT CONT.		01
REV. NO.	DATE	DESCRIPTION												L07G00		


	1	2	3	4	5	6	7	8	9	10
A			POWER SYSTEMS NETWORK MANAGEMENT PROTECTION AND SUBSTATION AUTOMATION SYSTEMS WBS NO: S-13656					ABB AUTOMATION COMPANY LTD., 414, AL-KHARJ ROAD SECOND INDUSTRIAL CITY RIYADH-11383 K.S.A		
B										
C	CONTRACTOR : ABB Contracting Company									
	CLIENT : National Gridsa									
D	PROJECT : CONSTRUCTION OF NEW 132/13.8kV SS 8709 IN AL-KHARJ CITY									
	SUBSTATION : S/S 8709									
E	CONTRACT NO. : 11131113/00									
F	TITLE : Assembly Drawing +R01.2 [GT-2]									

G	AS-BUILT BY _____ DATE _____		CONTRACT NO. 11131113/00	JOB ORDER NO. S-13656	COVER SHEET		 نقل الكهرباء الشركة الوطنية لنقل الكهرباء National Grid sa								
	01	13 49	FACTORY ASBUILT	DRAWN BY RIZ	CHECKED BY JKR	132/13.8kV GT-2 RELAY PANEL-2 +R01.2	INDEX	PLANT NO.	DRAWING NUMBER	SHEET NO.	REV. NO.				
	00	13 04	FOR APPROVAL	DATE STARTED 24.01.2013	DATE COMPLETED	S/S 8709-132/13.8KV IN AL-KHARJ CITY	-	C421	CD-322930	SHT	CONT.				
	REV. NO.	DATE	DESCRIPTION	OPRG. DEPT. CTPD	ENG. DEPT. AUT-PSAC	RIYADH SAUDI ARABIA				G00	G01				
											NG/D2-D (2012/01)		DMS VECTOR		NGD200

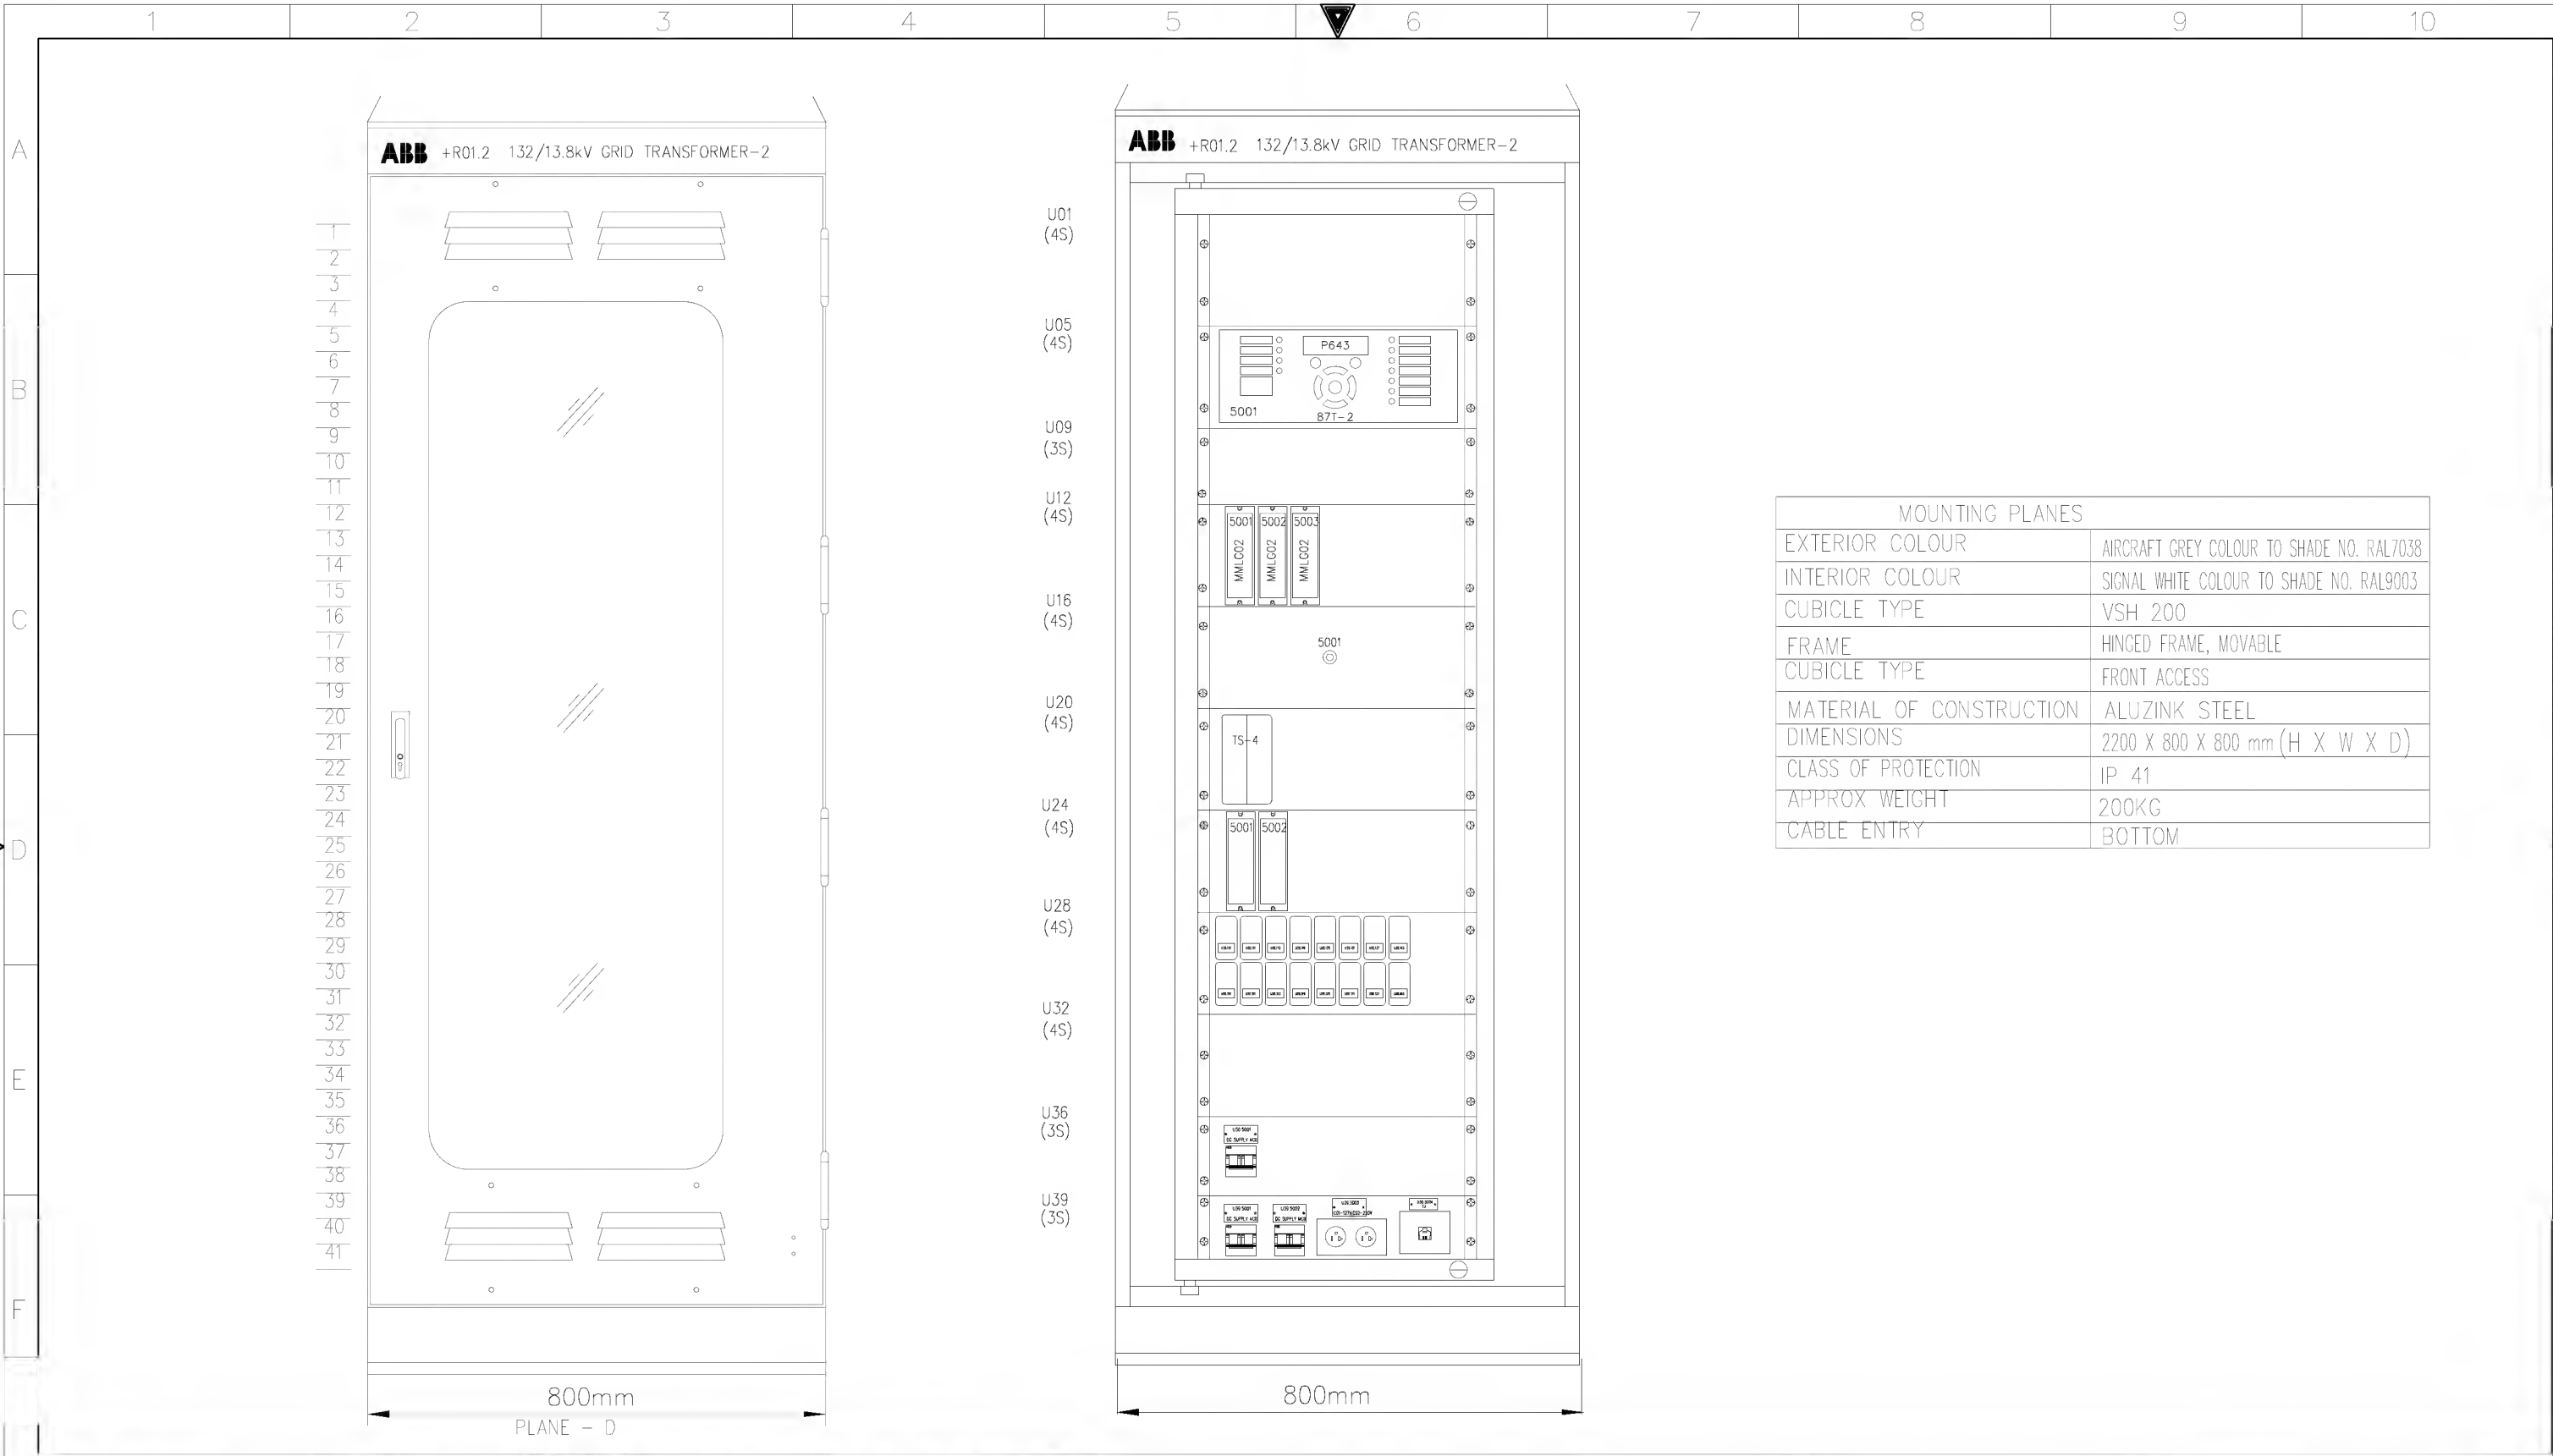

MOUNTING PLANES	
EXTERIOR COLOUR	AIRCRAFT GREY COLOUR TO SHADE NO. RAL7038
INTERIOR COLOUR	SIGNAL WHITE COLOUR TO SHADE NO. RAL9003
CUBICLE TYPE	VSH 200
FRAME	HINGED FRAME, MOVABLE
CUBICLE TYPE	FRONT ACCESS
MATERIAL OF CONSTRUCTION	ALUZINK STEEL
DIMENSIONS	2200 X 800 X 800 mm (H X W X D)
CLASS OF PROTECTION	IP 41
APPROX WEIGHT	200KG
CABLE ENTRY	BOTTOM

AS-BUILT BY _____ DATE _____			CONTRACT NO. 11131113/00		JOB ORDER NO. S-13656		ASSEMBLY DRAWING		الشركة الوطنية لنقل الكهرباء		نقل الكهرباء	
01 13 49 FACTORY ASBUILT			DRAWN BY RIZ		CHECKED BY JKR		132/13.8kV GT-2 RELAY PANEL-2 +R01.2		National Grid sa			
00 13 04 FOR APPROVAL			DATE STARTED 24.01.2013		DATE COMPLETED _____		S/S 8709-132/13.8KV IN AL-KHARJ CITY		INDEX		SHEET NO.	
REV. NO. DATE DESCRIPTION			OPRG. DEPT. CTPD		ENG. DEPT. AUT-PSAC		RIYADH SAUDI ARABIA		PLANT NO. C421		DRAWING NUMBER CD-322930	
									-		SHT CONT.	
											G01 G02	
											01	

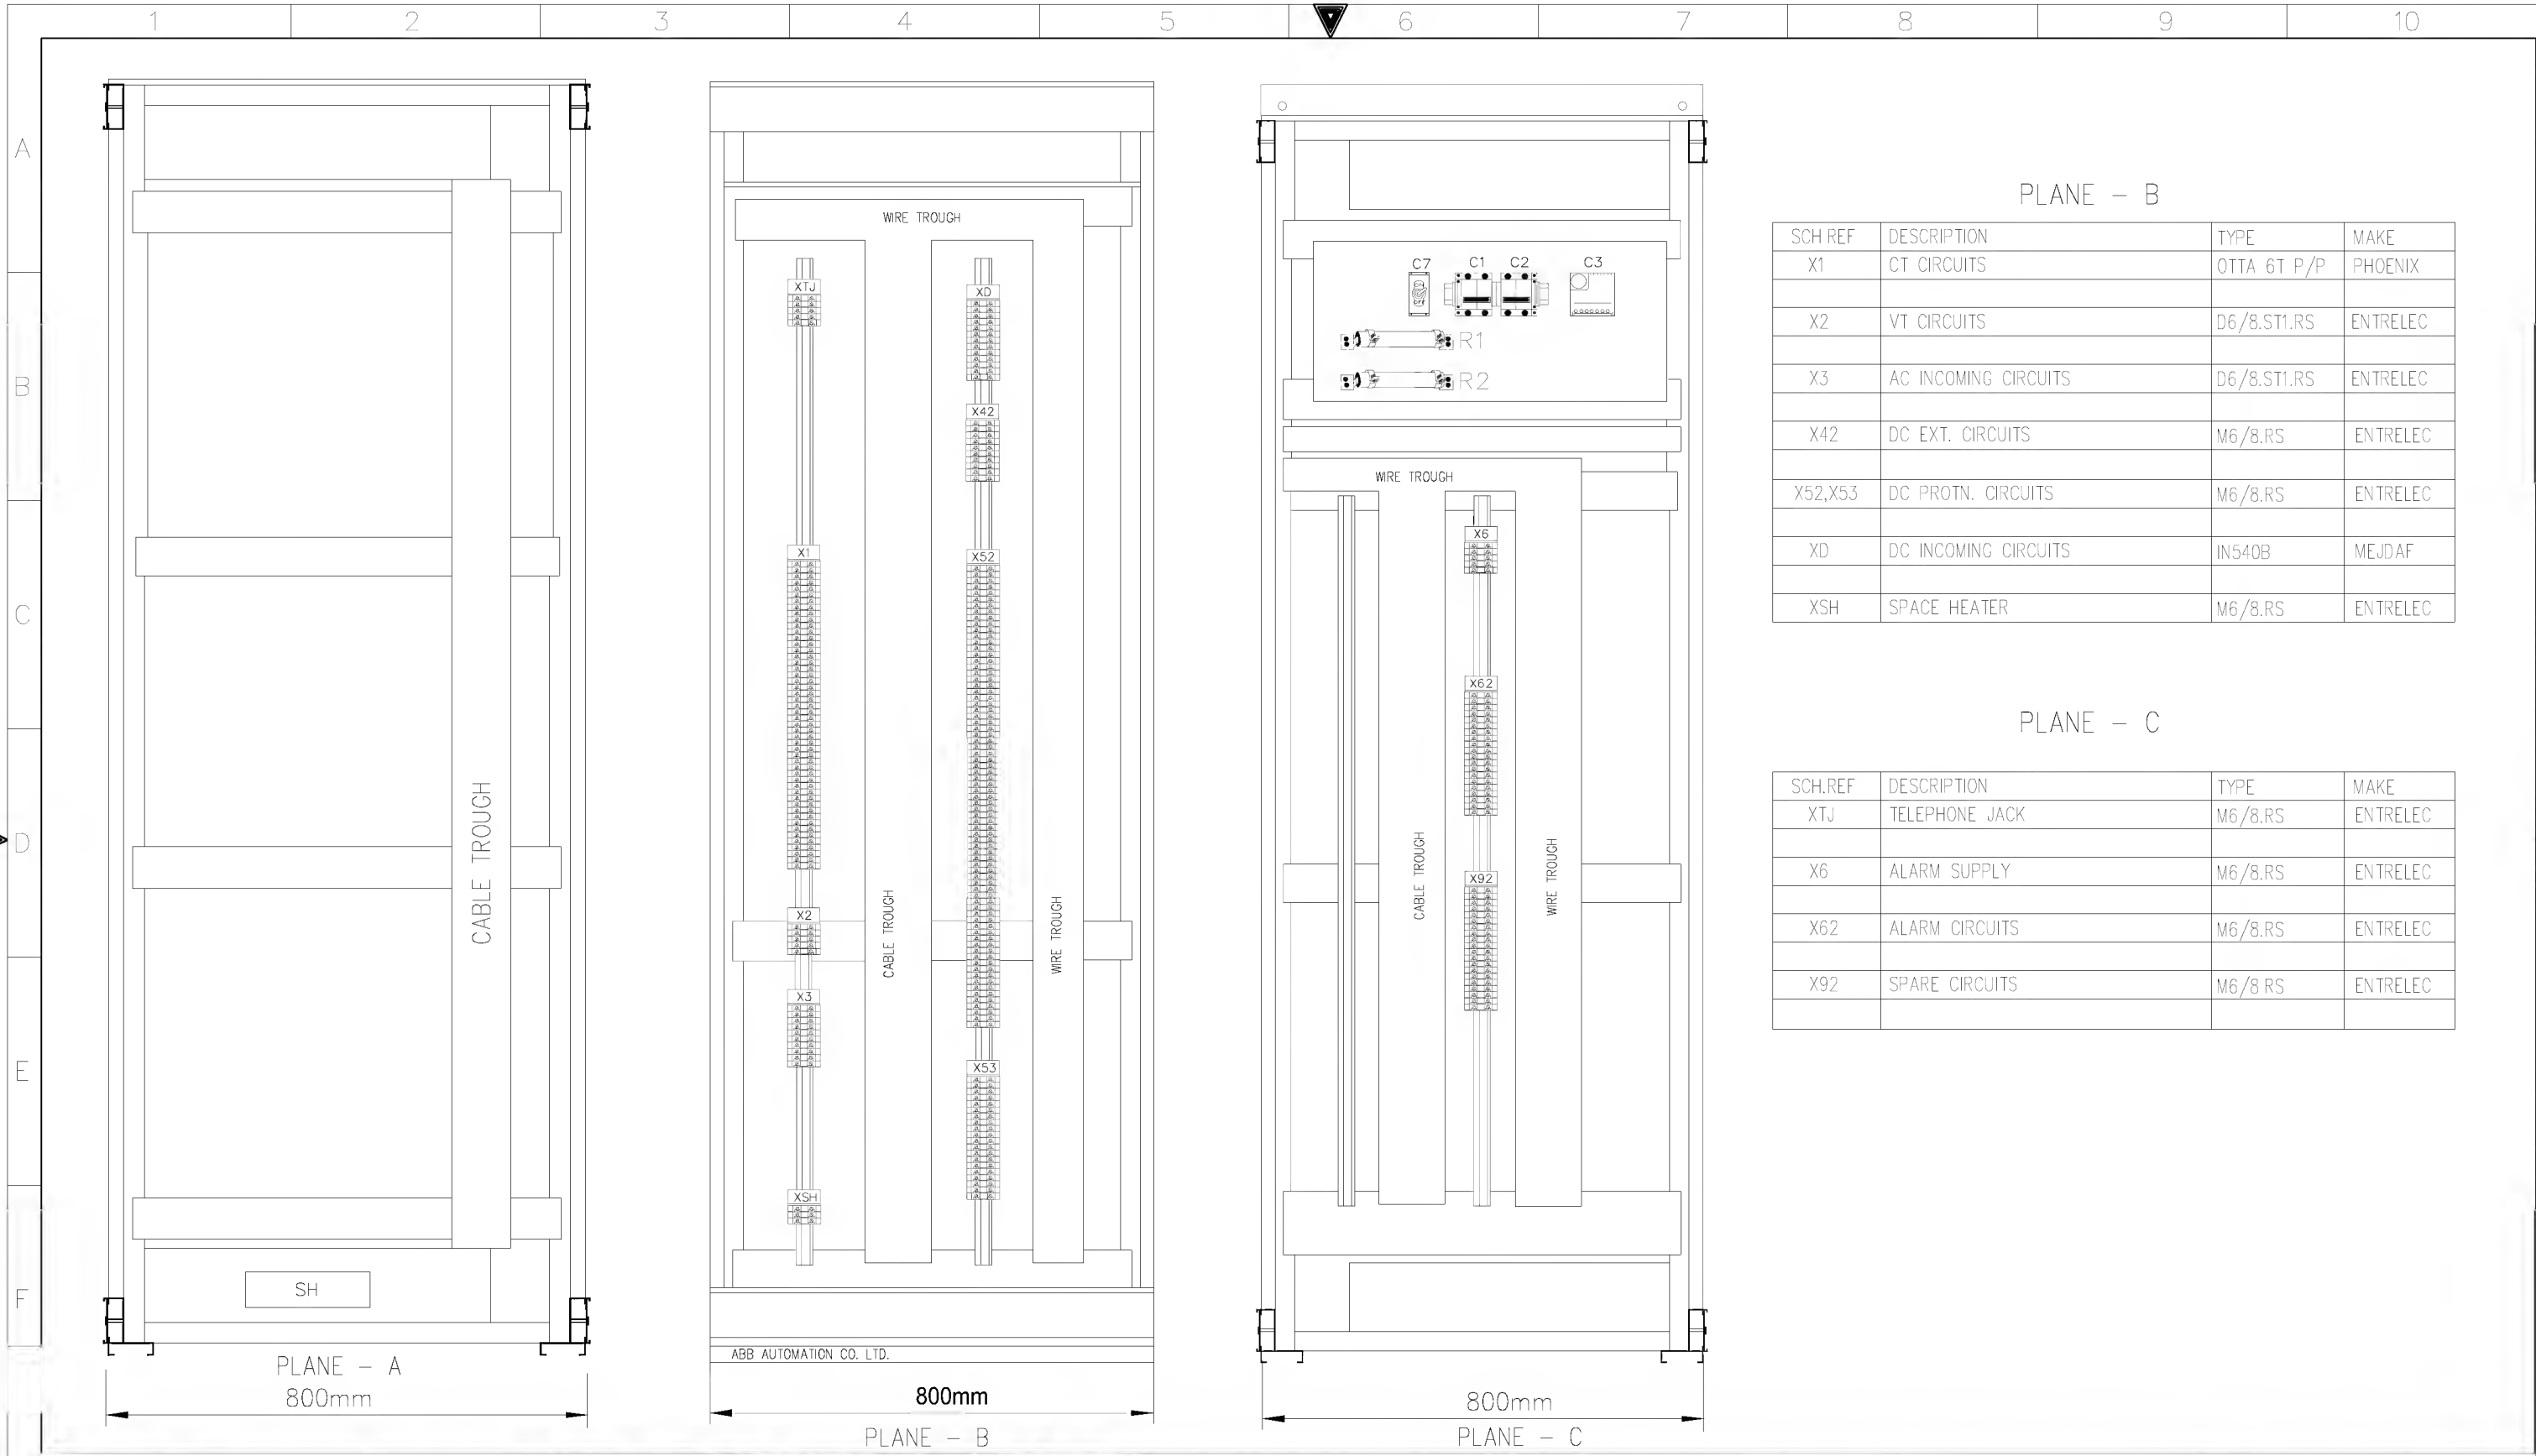

PLANE – B

SCH REF	DESCRIPTION	TYPE	MAKE
X1	CT CIRCUITS	OTTA 6T P/P	PHOENIX
X2	VT CIRCUITS	D6/8.ST1.RS	ENTRELEC
X3	AC INCOMING CIRCUITS	D6/8.ST1.RS	ENTRELEC
X42	DC EXT. CIRCUITS	M6/8.RS	ENTRELEC
X52,X53	DC PROTN. CIRCUITS	M6/8.RS	ENTRELEC
XD	DC INCOMING CIRCUITS	IN540B	MEJDAF
XSH	SPACE HEATER	M6/8.RS	ENTRELEC

PLANE – C

SCH.REF	DESCRIPTION	TYPE	MAKE
XTJ	TELEPHONE JACK	M6/8.RS	ENTRELEC
X6	ALARM SUPPLY	M6/8.RS	ENTRELEC
X62	ALARM CIRCUITS	M6/8.RS	ENTRELEC
X92	SPARE CIRCUITS	M6/8 RS	ENTRELEC

AS-BUILT BY _____ DATE _____ CONTRACT NO. 11131113/00 JOB ORDER NO. S-13656


01	13 49	FACTORY ASBUILT
00	13 04	FOR APPROVAL
REV. NO.	DATE	DESCRIPTION

DRAWN BY RIZ CHECKED BY JKR
DATE STARTED 24.01.2013 DATE COMPLETED _____
OPRG. DEPT. CTPD ENG. DEPT. AUT-PSAC

ASSEMBLY DRAWING
132/13.8kV GT-2 RELAY PANEL-2 +R01.2
S/S 8709-132/13.8KV IN AL-KHARJ CITY
RIYADH SAUDI ARABIA

الشركة الوطنية لنقل الكهرباء
National Grid sa

INDEX	PLANT NO.	DRAWING NUMBER	SHEET NO.	REV. NO.
-	C421	CD-322930	G02 G03	01

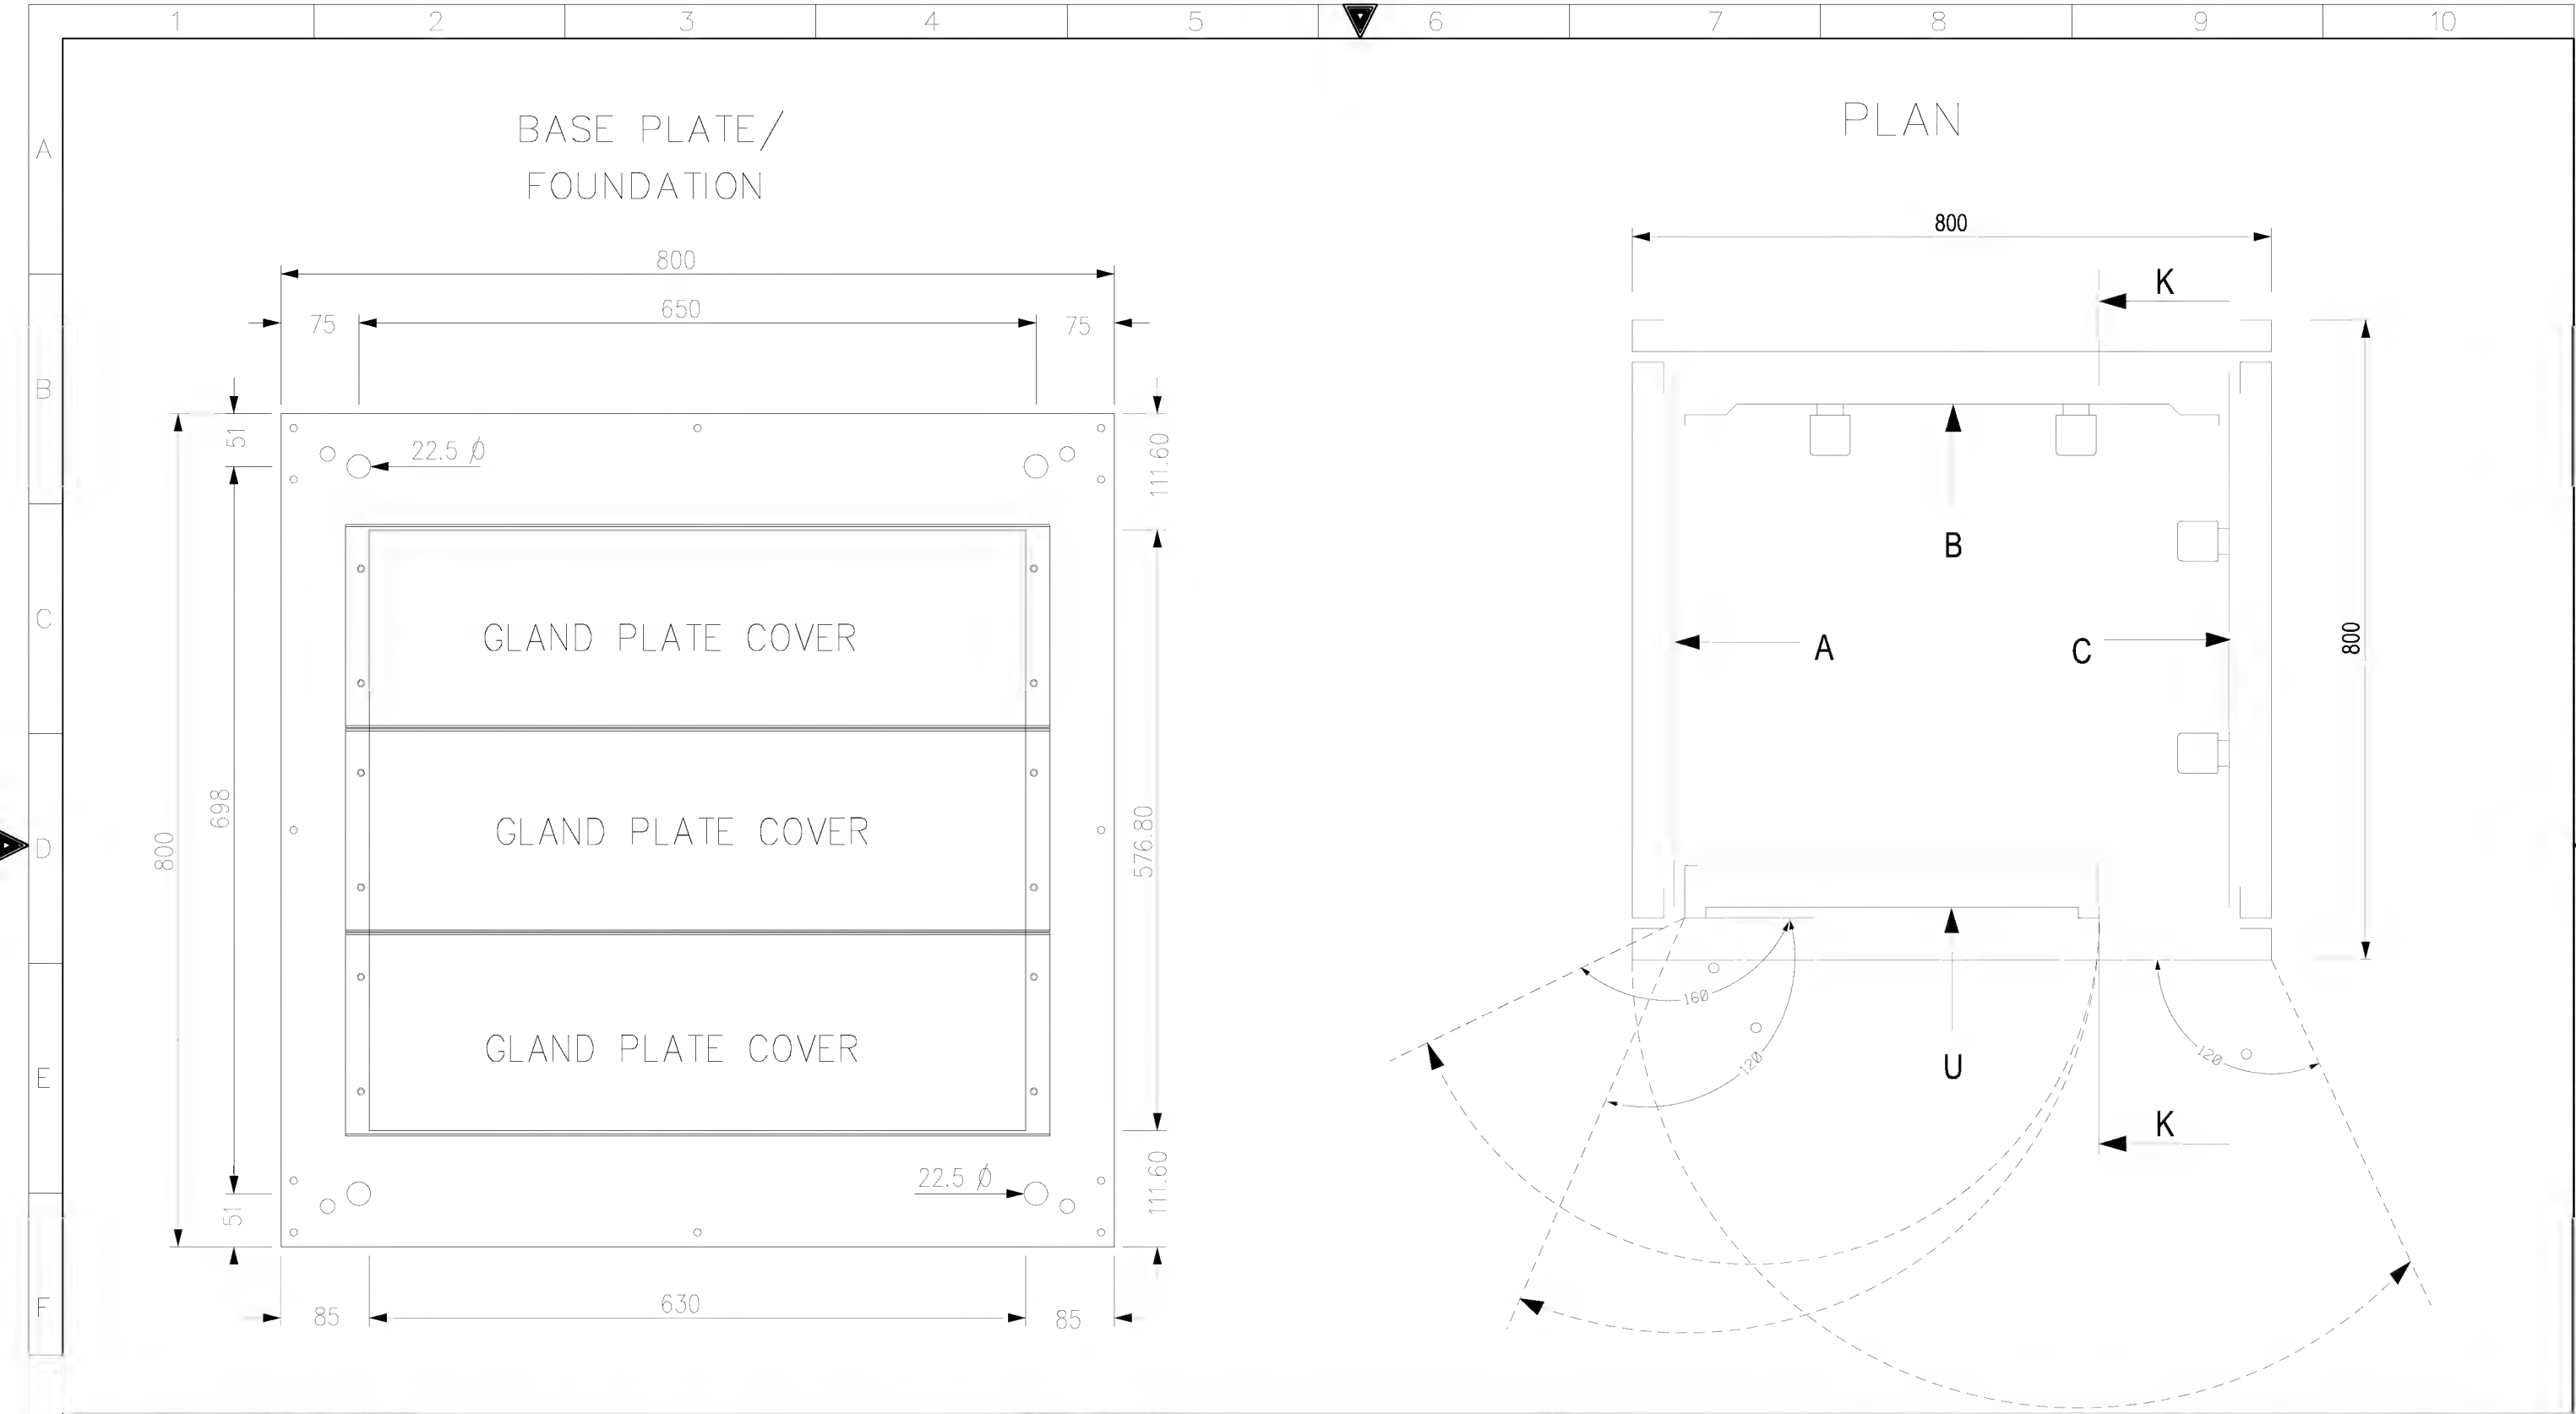

AS-BUILT BY _____ DATE _____			CONTRACT NO. 11131113/00		JOB ORDER NO. S-13656	
01	13 49	FACTORY ASBUILT	DRAWN BY RIZ		CHECKED BY JKR	
00	13 04	FOR APPROVAL	DATE STARTED 24.01.2013		DATE COMPLETED _____	
REV. NO.	DATE	DESCRIPTION	OPRG. DEPT. CTPD		ENG. DEPT. AUT-PSAC	


ASSEMBLY DRAWING	
132/13.8kV GT-2 RELAY PANEL-2 +R01.2	
S/S 8709-132/13.8KV IN AL-KHARJ CITY	
RIYADH	SAUDI ARABIA

الشركة الوطنية لنقل الكهرباء				نقل الكهرباء	
				National Grid sa	
INDEX	PLANT NO.	DRAWING NUMBER	SHEET NO.		REV. NO.
-	C421	CD-322930	SHT	CONT.	01
			G03	G04	



TOP VIEW FOR EARTHING BAR

U PLANE TOP LABEL

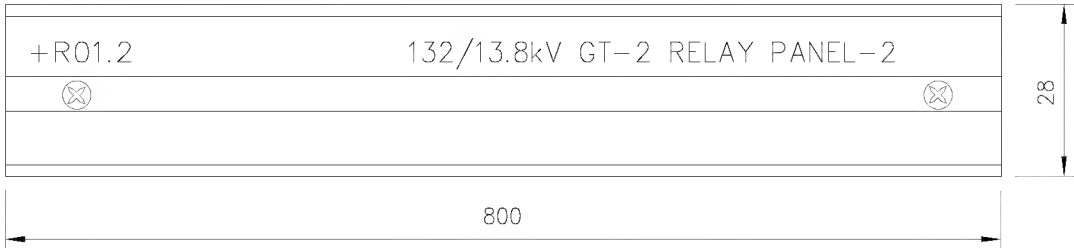

U PLANE BOTTOM LABEL



MANUFACTURING LABEL

ABB

ABB Automation Co.Ltd.

PROJECT :

National Grid SA
S/S 8709

ORDER REFERENCE :

2875 RF S13656

YEAR OF MANUFACTURE:

2013

PANEL NO. :

+R01.2

DRAWING NO. :

S13656-CD-323931

MADE IN THE KINGDOM OF SAUDI ARABIA


AS-BUILT BY _____ DATE _____ CONTRACT NO. 11131113/00 JOB ORDER NO. S-13656


01	13 49	FACTORY ASBUILT	DRAWN BY RIZ	CHECKED BY JKR
00	13 04	FOR APPROVAL	DATE STARTED 24.01.2013	DATE COMPLETED
REV. NO.	DATE	DESCRIPTION	OPRG. DEPT. CTPD	ENG. DEPT. AUT-PSAC

ASSEMBLY DRAWING
132/13.8kV GT-2 RELAY PANEL-2 +R01.2
S/S 8709-132/13.8KV IN AL-KHARJ CITY
RIYADH SAUDI ARABIA


الشركة الوطنية لنقل الكهرباء
National Grid sa

INDEX	PLANT NO.	DRAWING NUMBER	SHEET NO.	REV. NO.
-	C421	CD-322930	SHT CONT.	01
			G04 L00	


	1	2	3	4	5	6	7	8	9	10
A			POWER SYSTEMS NETWORK MANAGEMENT PROTECTION AND SUBSTATION AUTOMATION SYSTEMS WBS NO: S-13656					ABB AUTOMATION COMPANY LTD., 414, AL-KHARJ ROAD SECOND INDUSTRIAL CITY RIYADH-11383 K.S.A		
B										
C										
D	CONTRACTOR : ABB Contracting Company									
	CLIENT : National Gridsa									
	PROJECT : CONSTRUCTION OF NEW 132/13.8kV SS 8709 IN AL-KHARJ CITY									
	SUBSTATION : S/S 8709									
E	CONTRACT NO. : 11131113/00									
F	TITLE : LIST OF APPARATUS +R01.2 [GT-2]									

G	AS-BUILT BY _____ DATE _____		CONTRACT NO. 11131113/00	JOB ORDER NO. S-13656	LIST OF APPARATUS		 نقل الكهرباء الشركة الوطنية لنقل الكهرباء National Grid sa				
	01	13 49	FACTORY ASBUILT	DRAWN BY RIZ	CHECKED BY JKR	132/13.8kV GT-2 RELAY PANEL-2 +R01.2	INDEX	PLANT NO.	DRAWING NUMBER	SHEET NO.	REV. NO.
	00	13 04	FOR APPROVAL	DATE STARTED 24.01.2013	DATE COMPLETED	S/S 8709-132/13.8KV IN AL-KHARJ CITY	-	C421	CD-322930	SHT L00	CONT. L01
	REV. NO.	DATE	DESCRIPTION	OPRG. DEPT. CTPD	ENG. DEPT. AUT-PSAC	RIYADH SAUDI ARABIA					01

	1	2	3	4	5	6	7	8	9	10
A										
B										
C										
D										
E										
F										

G	AS-BUILT BY _____ DATE _____		CONTRACT NO. 11131113/00		JOB ORDER NO. S-13656		LIST OF APPARATUS		الشركة الوطنية لنقل الكهرباء		نقل الكهرباء National Grid sa				
	01	13 49	FACTORY ASBUILT		DRAWN BY RIZ CHECKED BY JKR		132/13.8kV GT-2 RELAY PANEL-2 +R01.2								
	00	13 04	FOR APPROVAL		DATE STARTED 24.01.2013 DATE COMPLETED _____		S/S 8709-132/13.8KV IN AL-KHARJ CITY								
	REV. NO.	DATE	DESCRIPTION		OPRG. DEPT. CTPD ENG. DEPT. AUT-PSAC		RIYADH SAUDI ARABIA		INDEX	PLANT NO.	DRAWING NUMBER		SHEET NO.		REV. NO.
									-	C421	CD-322930		SHT	CONT.	01
											L01	L02			

[illegible]

AS-BUILT BY _____ DATE _____			CONTRACT NO. 11131113/00		JOB ORDER NO. S-13656		LIST OF APPARATUS			 نقل الكهرباء الشركة الوطنية لنقل الكهرباء National Grid sa	
G	01	13 49	FACTORY ASBUILT		DRAWN BY RIZ CHECKED BY JKR		132/13.8kV GT-2 RELAY PANEL-2 +R01.2				
	00	13 04	FOR APPROVAL		DATE STARTED 24.01.2013 DATE COMPLETED _____		S/S 8709-132/13.8KV IN AL-KHARJ CITY				
	REV. NO.	DATE	DESCRIPTION		OPRG. DEPT. CTPD ENG. DEPT. AUT-PSAC		RIYADH SAUDI ARABIA				
							INDEX	PLANT NO.	DRAWING NUMBER	SHEET NO.	REV. NO.
							-	C421	CD-322930	SHT L04 CONT. L05	01
NG/D2-D (2012/01)											
<div style="display: flex; justify-content: space-between;"> DMS VECTOR NGD200 </div>											

	1	2	3	4	5	6	7	8	9	10
A										
B										
C										
D										
E										
F										

LABEL REF.	LABEL ENGRAVING	MATERIALS	ENGRAVING	LABEL SIZE	LETTER SIZE
U05.5001	U05.5001 871-2	TRAFOLITE	BLACK LETTERS ON WHITE BACKGROUND	50X15mm	4mm
U12.5001	U12.5001 TS-1	ALUMINUM PAPER FOIL	BLACK LETTERS	50X10mm	3mm
U12.5002	U12.5002 TS-2	ALUMINUM PAPER FOIL	BLACK LETTERS	50X10mm	3mm
U12.5003	U12.5003 TS-3	ALUMINUM PAPER FOIL	BLACK LETTERS	50X10mm	3mm
U12.5004	U12.5004 TS-4	ALUMINUM PAPER FOIL	BLACK LETTERS	50X10mm	3mm
U16.5001	U16.5001 S86T2	TRAFOLITE	BLACK LETTERS ON WHITE BACKGROUND	50X15mm	4mm
U20.101	U20.101 TS-4	ALUMINUM PAPER FOIL	BLACK LETTERS	50X10mm	3mm
U24.5001	U29.5001 86T2	ALUMINUM PAPER FOIL	BLACK LETTERS	50X10mm	3mm
U24.5002	U29.5002 94T2	ALUMINUM PAPER FOIL	BLACK LETTERS	50X10mm	3mm
U28.101	U28.101 23X 63QL-1X	ALUMINUM PAPER FOIL	BLACK LETTERS	50X10mm	3mm
U28.107	U28.107 63QH-1X 63QL-2X	ALUMINUM PAPER FOIL	BLACK LETTERS	50X10mm	3mm
U28.301	U28.301 63QH-2X 96D-1X	ALUMINUM PAPER FOIL	BLACK LETTERS	50X10mm	3mm
U28.307	U28.307 96D-2X 96-1X	ALUMINUM PAPER FOIL	BLACK LETTERS	50X10mm	3mm
U28.113	U28.113 63QP-1X 63GD-1X	ALUMINUM PAPER FOIL	BLACK LETTERS	50X10mm	3mm
U28.313	U28.313 26D-1X 26D-2X	ALUMINUM PAPER FOIL	BLACK LETTERS	50X10mm	3mm
U28.119	U28.119 49W1-5X 49W1-6X	ALUMINUM PAPER FOIL	BLACK LETTERS	50X10mm	3mm
U28.319	U28.319 630-SX 96-2X	ALUMINUM PAPER FOIL	BLACK LETTERS	50X10mm	3mm
U28.125	U28.125 63QP-2X 49W2-5X	ALUMINUM PAPER FOIL	BLACK LETTERS	50X10mm	3mm
U28.325	U28.325 49W2-6X SPARE	ALUMINUM PAPER FOIL	BLACK LETTERS	50X10mm	3mm
U28.131	U28.131 74R2	ALUMINUM PAPER FOIL	BLACK LETTERS	50X10mm	3mm
U28.331	U28.331 74R3	ALUMINUM PAPER FOIL	BLACK LETTERS	50X10mm	3mm
U28.137	U28.137 63/49/96x	ALUMINUM PAPER FOIL	BLACK LETTERS	50X10mm	3mm
U28.337	U28.337 T1	ALUMINUM PAPER FOIL	BLACK LETTERS	50X10mm	3mm
U28.149	U28.149 49X	ALUMINUM PAPER FOIL	BLACK LETTERS	50X10mm	3mm
U28.349	U28.349 96-3/96-4	ALUMINUM PAPER FOIL	BLACK LETTERS	50X10mm	3mm
U28.143	U28.143 R1	ALUMINUM PAPER FOIL	BLACK LETTERS	50X10mm	3mm
U28.343	U28.343 R2	ALUMINUM PAPER FOIL	BLACK LETTERS	50X10mm	3mm

G	AS-BUILT BY _____ DATE _____			CONTRACT NO. 11131113/00		JOB ORDER NO. S-13656		LIST OF APPARATUS		<div>الشركة الوطنية لنقل الكهرباء</div> <div>National Grid sa</div>															
	01		13 49	FACTORY ASBUILT	DRAWN BY RIZ		CHECKED BY JKR		132/13.8kV GT-2 RELAY PANEL-2 +R01.2		INDEX	PLANT NO.	DRAWING NUMBER		SHEET NO.		REV. NO.								
	00		13 04	FOR APPROVAL	DATE STARTED 24.01.2013		DATE COMPLETED		S/S 8709-132/13.8KV IN AL-KHARJ CITY		-	C421	CD-322930		SHT		CONT.								
	REV. NO.		DATE		DESCRIPTION		OPRG. DEPT. CTPD		ENG. DEPT. AUT-PSAC						RIYADH		SAUDI ARABIA		01						
																		NG/D2-D (2012/01)		DMS		VECTOR		NGD200	

A

B

C

D


E


F

LABEL REF.	LABEL ENGRAVING	MATERIALS	ENGRAVING	LABEL SIZE	LETTER SIZE
C1	C1 127V AC SUPPLY MCB	TRAFOLITE	BLACK LETTERS ON WHITE BACKGROUND	50X15mm	4mm
C2	C2 220V AC SUPPLY MCB	TRAFOLITE	BLACK LETTERS ON WHITE BACKGROUND	50X15mm	4mm
C3	C3 THERMOSTAT	TRAFOLITE	BLACK LETTERS ON WHITE BACKGROUND	50X15mm	4mm
C7	C7 ON/OFF SWITCH	TRAFOLITE	BLACK LETTERS ON WHITE BACKGROUND	50X15mm	4mm
DS	DS DOOR SWITCH	TRAFOLITE	BLACK LETTERS ON WHITE BACKGROUND	50X15mm	4mm
IL	IL ILLUMINATION LAMP	TRAFOLITE	BLACK LETTERS ON WHITE BACKGROUND	50X15mm	4mm
SH	SH SPACE HEATER	TRAFOLITE	BLACK LETTERS ON WHITE BACKGROUND	50X15mm	4mm
U39.5001	Q1 R2+SUPPLY	TRAFOLITE	BLACK LETTERS ON WHITE BACKGROUND	50X15mm	4mm
U39.5002	Q2 R3+SUPPLY	TRAFOLITE	BLACK LETTERS ON WHITE BACKGROUND	50X15mm	4mm
U39.5003	C01,C02 OUTLET	TRAFOLITE	BLACK LETTERS ON WHITE BACKGROUND	50X15mm	4mm
U39.5004	TJ TELEPHONE JACK	TRAFOLITE	BLACK LETTERS ON WHITE BACKGROUND	50X15mm	4mm
U36.5001	Q3 TC- 2+SUPPLY	TRAFOLITE	BLACK LETTERS ON WHITE BACKGROUND	50X15mm	4mm

G

AS-BUILT BY _____ DATE _____			CONTRACT NO. 11131113/00		JOB ORDER NO. S-13656		LIST OF APPARATUS		<div>الشركة الوطنية لنقل الكهرباء</div> <div> نقل الكهرباء National Grid sa</div>										
01		13 49		FACTORY ASBUILT		DRAWN BY RIZ CHECKED BY JKR		132/13.8kV GT-2 RELAY PANEL-2 +R01.2		INDEX		PLANT NO.		DRAWING NUMBER		SHEET NO.		REV. NO.	
00		13 04		FOR APPROVAL		DATE STARTED 24.01.2013 DATE COMPLETED _____		S/S 8709-132/13.8KV IN AL-KHARJ CITY		-		C421		CD-322930		SHT		CONT.	
REV. NO.		DATE		DESCRIPTION		OPRG. DEPT. CTPD ENG. DEPT. AUT-PSAC		RIYADH SAUDI ARABIA								L06000		01	

	1	2	3	4	5	6	7	8	9	10
A			POWER SYSTEMS NETWORK MANAGEMENT PROTECTION AND SUBSTATION AUTOMATION SYSTEMS WBS NO: S-13656					ABB AUTOMATION COMPANY LTD. 414, AL-KHARJ ROAD SECOND INDUSTRIAL CITY RIYADH-11383 K.S.A		
B										
C										
D	CONTRACTOR : ABB Contracting Company									
	CLIENT : National Gridsa									
	PROJECT : CONSTRUCTION OF NEW 132/13.8kV SS 8709 IN AL-KHARJ CITY									
	SUBSTATION : S/S 8709									
E	CONTRACT NO. : 11131113/00									
F	TITLE : SCHEMATICS DRAWINGS (+R01.1,+R01.2)									

G	AS-BUILT BY _____ DATE _____		CONTRACT NO. 11131113/00	JOB ORDER NO. S-13656	COVER SHEET		 نقل الكهرباء الشركة الوطنية لنقل الكهرباء National Grid sa				
	01	13 49	FACTORY ASBUILT	DRAWN BY RIZ	CHECKED BY JKR	132/13.8KV GT-2 RELAY PANEL -+R01.1/+R01.2	INDEX	PLANT NO.	DRAWING NUMBER	SHEET NO.	REV. NO.
	00	13 04	FOR APPROVAL	DATE STARTED 24.01.2013	DATE COMPLETED	S/S 8709-132/13.8KV IN AL-KHARJ CITY	-	C421	CD-322931	SHT 000	CONT. 001
	REV. NO.	DATE	DESCRIPTION	OPRG. DEPT. CTPD	ENG. DEPT. AUT-PSAC	RIYADH SAUDI ARABIA					01

A

B

C

D

E

F

CONTENTS	ABB SHT.NO.	REV.00	REV.01	REV.02
AC SUPPLY FOR ILLUMINATION & POWER SOCKET	411	X	X	
CUB. LIGHTING, HEATER & SOCKET ALARM CKT.	412	X	X	
DC SUPPLY DISTRIBUTION FOR SYSTEM SYNCHRONISER	416	X	X	
CT CIRCUIT 87T-2 RELAY	421-422	X	X	
CT CIRCUIT 87T-2 RELAY	423	X	X	
CT & VT CIRCUITS 87T-2 RELAY	424	X	X	
87T-2 BINARY INPUTS	429	X	X	
87T-2 BINARY INPUTS	430	X	X	
MAIN-2 DIFF. PROTECTION TRIP RELAY CKT.	432	X	X	
TRANS.MECH.PROTN.CONTACT MULTI.CKT	433	X	X	
TRANS.MECH.PROTN.CONTACT MULTI.CKT	434	X	X	
TRANS.MECH.PROTN.CONTACT MULTI.CKT	435	X	X	
TRANS.MECH.PROTN.CONTACT MULTI.CKT	436	X	X	
CB K305 TRIP CIRCUIT-2 SUPERVISION CIRCUIT	491	X	X	
BF INI & CLOSE BLOCK CIRCUIT	492	X	X	
TRANSFORMER MECHANICAL.PROTN.	493	X	X	
CONTACTS FOR TRIP AND CLOSE BLOCK	494	X	X	
CONTACTS FOR U/F LOAD SHEDDING	496	X	X	
MECH PROTN. ALARM CIRCUIT	498	X	X	
STN COMMON ALARM CIRCUIT	499	X	X	
BLOCK REFERENCE	501	X	X	
BLOCK REFERENCE	502	X	X	
TERMINAL BLOCKS REFERENCE +R01.2	106	X	X	
TERMINAL BLOCKS REFERENCE +R01.2	507	X	X	

G

AS-BUILT BY _____ DATE _____			CONTRACT NO. 11131113/00		JOB ORDER NO. S-13656		CONTENTS SHEET		<div>الشركة الوطنية لنقل الكهرباء National Grid sa</div>															
01 13 49 FACTORY ASBUILT			DRAWN BY RIZ CHECKED BY JKR		132/13.8KV GT-2 RELAY PANEL-1/2				<table><tr><td>INDEX</td><td>PLANT NO.</td><td>DRAWING NUMBER</td><td colspan="2">SHEET NO.</td><td>REV. NO.</td></tr><tr><td></td><td></td><td></td><td>SHT</td><td>CCNT.</td><td></td></tr></table>				INDEX	PLANT NO.	DRAWING NUMBER	SHEET NO.		REV. NO.				SHT	CCNT.	
INDEX	PLANT NO.	DRAWING NUMBER	SHEET NO.		REV. NO.																			
			SHT	CCNT.																				
00 13 04 FOR APPROVAL			DATE STARTED 24.01.2013 DATE COMPLETED _____		S/S 8709-132/13.8KV IN AL-KHARJ CITY																			
REV. NO. DATE DESCRIPTION			OPRG. DEPT. CTPD ENG. DEPT. AUT-PSAC		RIYADH SAUDI ARABIA				- C421 CD-322931 002 011 01															

	1	2	3	4	5	6	7	8	9	10
A										
B										
C										
D										
E										
F										

LEGENDS

±R1	DC SUPPLY – MAIN PROTECTION
±R2	DC SUPPLY – SECONDARY PROTECTION
±R3	DC SUPPLY – BACK UP PROTECTION
±IT	DC SUPPLY – INTER TRIP
FL	DC SUPPLY – FLASHING CIRCUIT
BB RS±	DC SUPPLY – BUS BAR – PROTECTION RESET
BB CBF±/CBF±	DC SUPPLY – CBF PROTECTION
R	RESET BUS – ALARM SYSTEM
CR	CONTROL ROOM
ECC	ENERGY CONTROL CENTRE
LOCAL	THE LOCATION OF CONTROLLED DEVICE
REMOTE	ANY OTHER LOCATION NOT LOCAL
ON	CB NORMALLY OPEN AUXILIARY CONTACT
OFF	CB NORMALLY CLOSED AUXILIARY CONTACT
A	COMMON
T	TEST POSITION
S	SERVICE POSITION
CS	CLOSE IN SERVICE POSITION
CT	CLOSE IN TEST POSITION
LS	LOCAL SERVICE
LT	LOCAL TEST
LC	LOCAL CLOSE
LO	LOCAL OPEN
RO	REMOTE OPEN
OP	OPERATE
RE	RESET

NOTES

LABELS

WHITE LABEL WITH BLACK LETTERING WILL BE PROVIDED FOR ALL MOUNTED APPARATUS EQUIPMENT IDENTIFICATION AND FUNCTION REFERENCE LABEL WILL BE PROVIDED FOR FRONT MOUNTED EQUIPMENTS OF THE PANEL AND EQUIPMENT IDENTIFICATION LABEL WILL BE PROVIDED FOR INTERNALLY MOUNTED EQUIPMENTS

WIRING

PVC INSULATED 600V GRADE
2.5 SQ.mm. YELLOW COLOURED FOR CT CIRCUITS
2.5 SQ.mm. RE COLOURED FOR VT CIRCUITS
1.5 SQ.mm. GREY COLOURED FOR DC SUPPLY, SCADA AND CONTROL CIRCUITS
2.5 SQ.mm. BLACK COLOURED FOR AVC AND AC CIRCUITS
2.5 SQ.mm. YELLOW/GREEN COLOURED FOR EARTHING CONNECTIONS
FOLLOWING MARKERS SHALL BE PROVIDED ON FOLLOWING WIRES:
+ SIGN FOR DC + WIRE
– SIGN FOR DC – WIRE

LUGS

A. CT CIRCUITS– RING TYPE
B. OTHER CIRCUITS – SPADE TYPE

FERULLING

YELLO TUBE 3.2 mm FOR 1.5SQ mm WIRES AND 4.2 FOR 2.5 SQ mm WIRES (AS PER 31 – TMSS–1, RE.0)

AS-BUILT BY _____ DATE _____ CONTRACT NO. 11131113/00 JOB ORDER NO. S-13656

01	13 49	FACTORY ASBUILT	DRAWN BY RIZ	CHECKED BY JKR
00	13 04	FOR APPROVAL	DATE STARTED 24.01.2013	DATE COMPLETED
REV. NO.	DATE	DESCRIPTION	OPRG. DEPT. CTPD	ENG. DEPT. AUT-PSAC

COMMON LEGEND

132/13.8KV GT-2 RELAY PANEL-1/2
S/S 8709-132/13.8KV IN AL-KHARJ CITY
RIYADH SAUDI ARABIA

الشركة الوطنية لنقل الكهرباء
National Grid sa

INDEX	PLANT NO.	DRAWING NUMBER	SHEET NO.	REV. NO.
-	C421	CD-322931	SHT 013	CONT. 014
				01

A

B


C



D

E

F

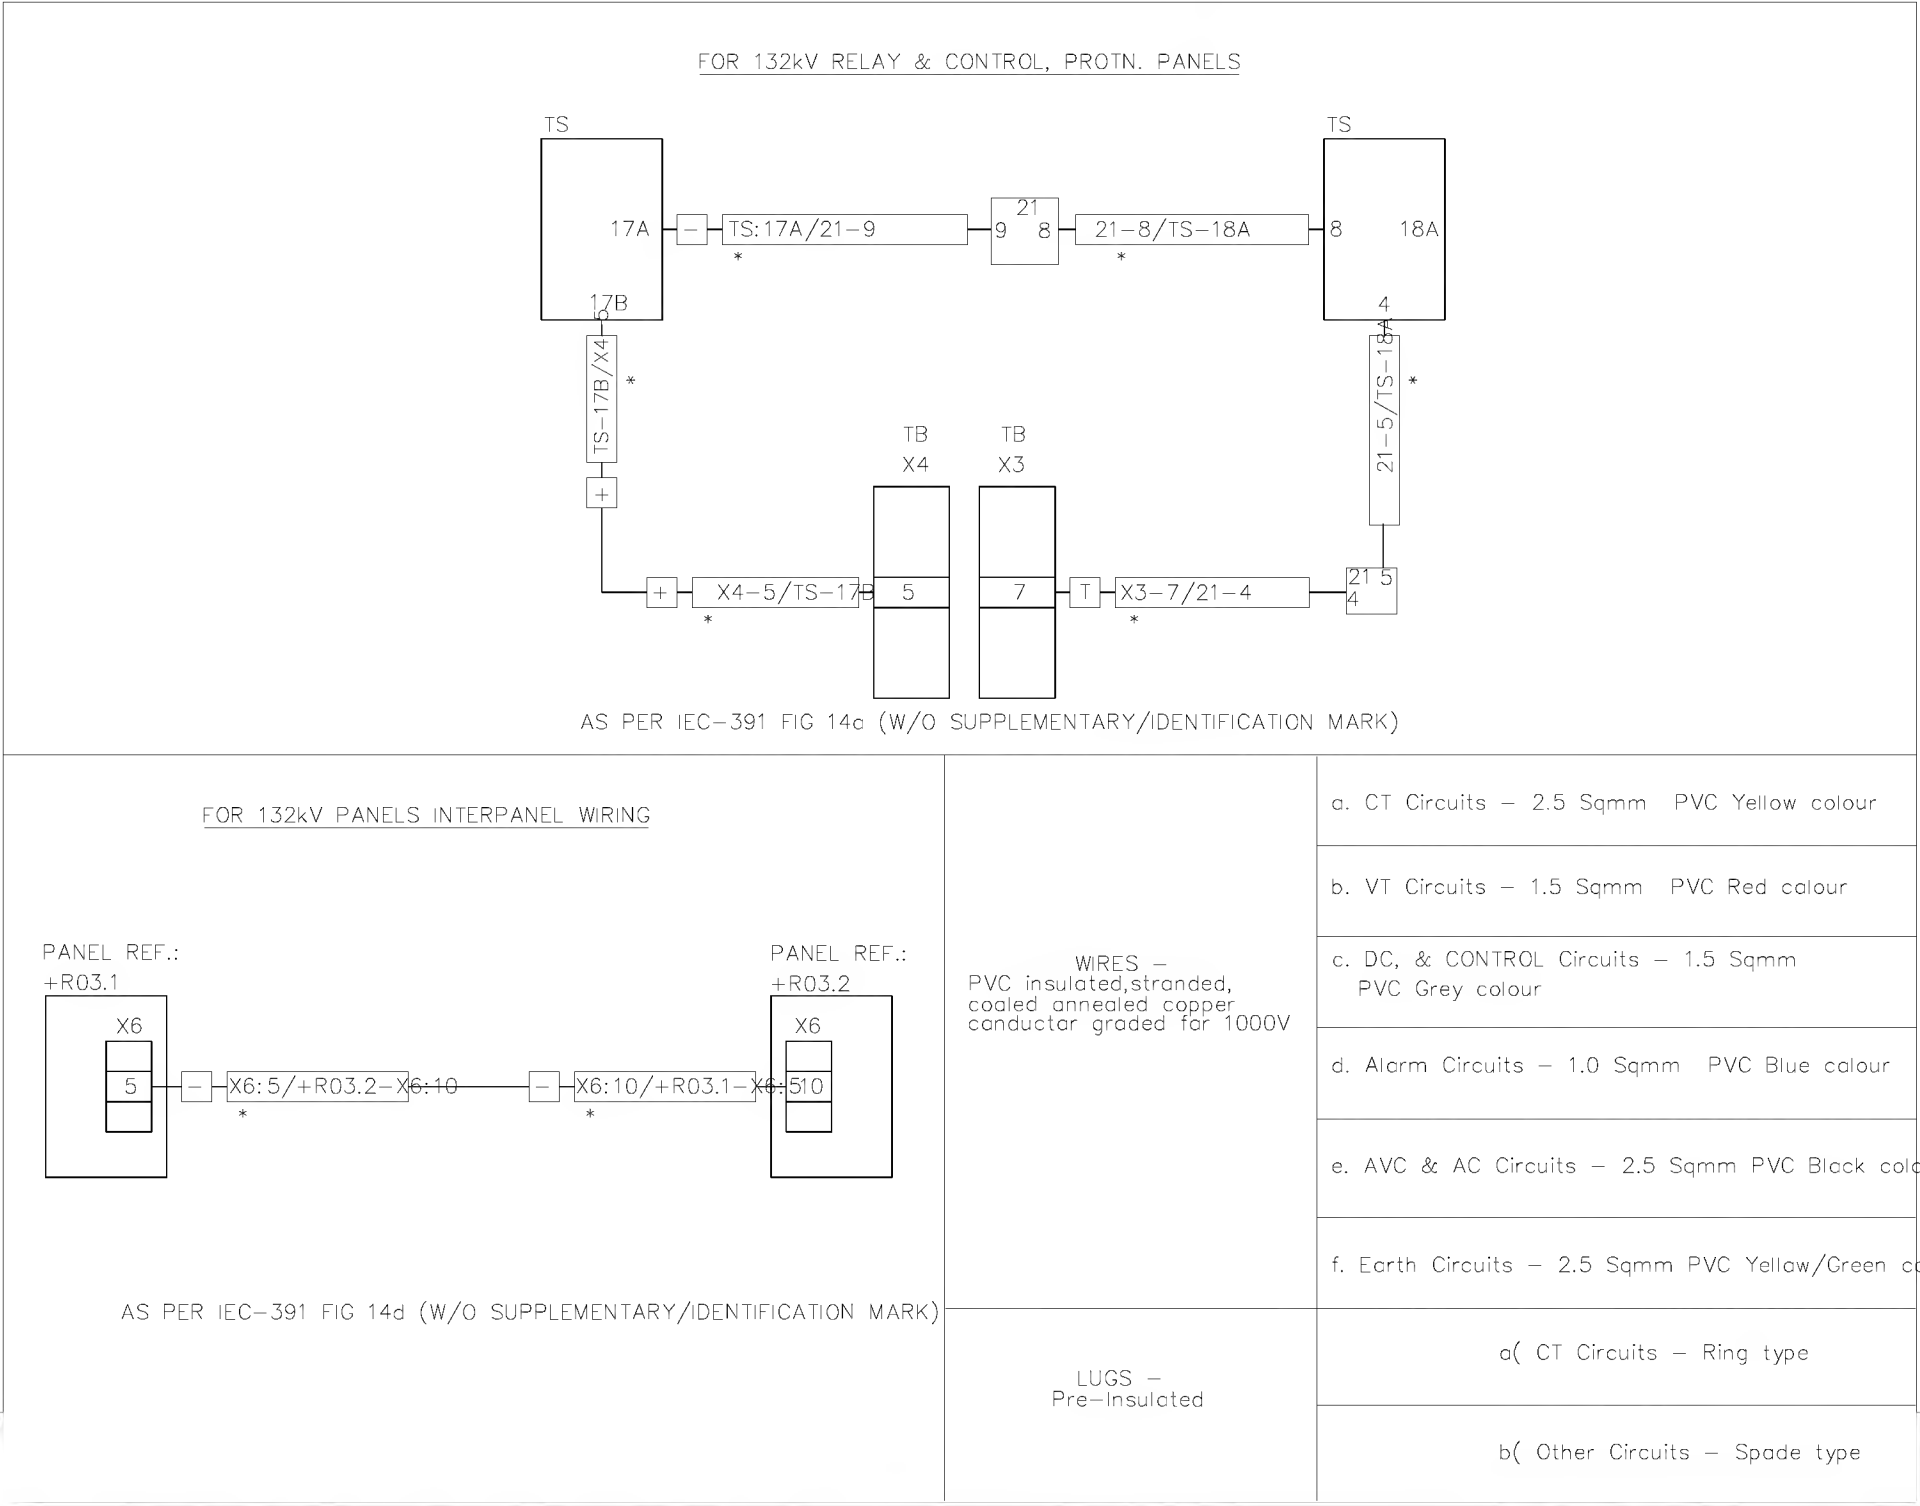

NOTE:1 ADDITIONAL MARKING AS APPLICABLE

NOTE:2 FERRULE NUMBERING WILL BE BLACK LETTERS ON YELLOW TUBE

3.2 mm for 1.5 sq mm wires and

4.2 mm for 2.5 sq mm wires


(As per 31-TMSS-1, REV 0)

NOTE:3 STARTING POINT OF THE FERRULE LEFT TO RIGHT

G

AS-BUILT BY _____ DATE _____			CONTRACT NO. 11131113/00		JOB ORDER NO. S-13656		FERRULE AND WIRING DETAILS		الشركة الوطنية لنقل الكهرباء National Grid sa	
01	13 49	FACTORY ASBUILT	DRAWN BY RIZ		CHECKED BY JKR		132/13.8KV GT-2 RELAY PANEL-1/2			
00	13 04	FOR APPROVAL	DATE STARTED 24.01.2013		DATE COMPLETED _____		S/S 8709-132/13.8KV IN AL-KHARJ CITY		INDEX	PLANT NO.
REV. NO.	DATE	DESCRIPTION	OPRG. DEPT. CTPD		ENG. DEPT. AUT-PSAC		RIYADH SAUDI ARABIA		-	C421
									CD-322931	
									SHEET NO.	
									SHT CONT.	
									014 015 01	

	1	2	3	4	5	6	7	8	9	10
A										
B										
C										
D										
E										
F										


MANUFACTURER	SCHEMATICS DWG.NO	PANEL DESCRIPTION	PANEL REFERENCE
 PROTECTION & SUBSTATION AUTOMATION		SS 8709 132kV RELAY PANELS	
	CD-322931	132/13.8kV GT-2 RELAY PANEL -1	+R01.1
		132/13.8kV GT-2 RELAY PANEL -2	+R01.2
	CD-322931	132/13.8kV GT-2 RELAY PANEL -1	+R01.1
		132/13.8kV GT-2 RELAY PANEL -2	+R01.2
	CD-322934	132/13.8kV GT-3 RELAY PANEL -1	+R04.1
		132/13.8kV GT-3 RELAY PANEL -2	+R04.2
	CD-322936	132/13.8kV TRANSFORMER-1,2& 3 AVC PANEL	+AVC
	CD-322922	132KV SPARE-1 UGF RELAY PANEL -1	+R07.1
		132KV SPARE-1 UGF RELAY PANEL -2	+R07.2
	CD-322916	132KV 8020 UGF RELAY PANEL -1	+R02.1
		132KV 8020 UGF RELAY PANEL -2	+R02.2
	CD-322919	132KV 8710 UGF RELAY PANEL -1	+R01.1
		132KV 8710 UGF RELAY PANEL -2	+R01.2
	CD-322925	132KV SPARE-2 UGF RELAY PANEL -1	+R06.1
		132KV SPARE-2 UGF RELAY PANEL -2	+R06.2
	CD-323012	132KV FOIP PANEL	+FOIP
	CD-322946	132kV BUS COUPLER-A	+R130
	CD-322948	132kV BUS COUPLER-B	+R230
	CD-322950	132kV BUS SECTION	+R120
	CD-322991	132kV BUSBAR PROTECTION MAIN-1 CENTRAL UNIT PANEL	+BB1-1
	CD-322993	132kV BUSBAR PROTECTION MAIN-1 BAY UNIT PANEL	+BB1-2
	CD-322995	132kV BUSBAR PROTECTION MAIN-1 BAY UNIT PANEL	+BB1-3
	CD-322997	132kV BUSBAR PROTECTION MAIN-1 BAY UNIT PANEL	+BB1-4
	CD-322999	132kV BUSBAR PROTECTION MAIN-1 BAY UNIT PANEL	+BB1-5
	CD-323001	132kV BUSBAR PROTECTION MAIN-2 CENTRAL UNIT PANEL	+BB2-1
	CD-323003	132kV BUSBAR PROTECTION MAIN-2 BAY UNIT PANEL	+BB2-2
	CD-323005	132kV BUSBAR PROTECTION MAIN-2 BAY UNIT PANEL	+BB2-3
	CD-323007	132kV BUSBAR PROTECTION MAIN-2 BAY UNIT PANEL	+BB2-4
	CD-323009	132kV BUSBAR PROTECTION MAIN-2 BAY UNIT PANEL	+BB2-5


AS-BUILT BY _____ DATE _____			CONTRACT NO. 11131113/00		JOB ORDER NO. S-13656	
			DRAWN BY _____ RIZ _____ CHECKED BY _____ JKR			
01	13 49	FACTORY ASBUILT	DATE STARTED 24.01.2013 DATE COMPLETED _____			
00	13 04	FOR APPROVAL	OPRG. DEPT. _____ CTPD _____ ENG. DEPT. _____ AUT-PSAC			
REV. NO.	DATE	DESCRIPTION				


DRAWING REFERENCES	
132/13.8KV GT-2 RELAY PANEL-1/2	
S/S 8709-132/13.8KV IN AL-KHARJ CITY	
RIYADH	SAUDI ARABIA

الشركة الوطنية لنقل الكهرباء			 نقل الكهرباء National Grid SA		
INDEX	PLANT NO.	DRAWING NUMBER	SHEET NO.		REV. NO.
-	C421	CD-322931	SHT	CONT.	01
			015	016	


	1	2	3	4	5	6	7	8	9	10
A										
B										
C										
D										
E										
F										

MANUFACTURER	SCHEMATICS DWG.NO	PANEL DESCRIPTION	PANEL REFERENCE
 PROTECTION & SUBSTATION AUTOMATION		SS 8709 13.8KV RELAY PANELS	
	CD-322952	13.8KV Capacitor Bank-1 Protection Panel	+CBP-1
	CD-322954	13.8KV Capacitor Bank-2 Protection Panel	+CBP-2
	CD-322956	13.8KV Capacitor Bank-2 Protection Panel	+CBP-3
	CD-322958	13.8 KV ACCS PANEL	+ACCS
	CD-322962	13.8KV ACSE PANEL	+ACSE
	CD-322968	13.8KV Under Voltage Load Shedding Panel	+UVLS
	CD-322964	13.8KV Under Frequency Load Shedding Panel-1	+UFLS01
	CD-322966	13.8KV Under Frequency Load Shedding Panel-2	+UFLS02

G	AS-BUILT BY _____ DATE _____		CONTRACT NO. 11131113/00		JOB ORDER NO. S-13656		DRAWING REFERENCES		<div><div></div><div>نقل الكهرباء</div><div>الشركة الوطنية لنقل الكهرباء</div><div>National Grid sa</div></div>					
	01	13 49	FACTORY ASBUILT		DRAWN BY RIZ CHECKED BY JKR		132/13.8KV GT-2 RELAY PANEL-1/2		INDEX	PLANT NO.	DRAWING NUMBER	SHEET NO.		REV. NO.
	00	13 04	FOR APPROVAL		DATE STARTED 24.01.2013 DATE COMPLETED _____		S/S 8709-132/13.8KV IN AL-KHARJ CITY					SHT	CONT.	
	REV. NO.	DATE	DESCRIPTION		OPRG. DEPT. CTPD ENG. DEPT. AUT-PSAC		RIYADH SAUDI ARABIA					016	051	

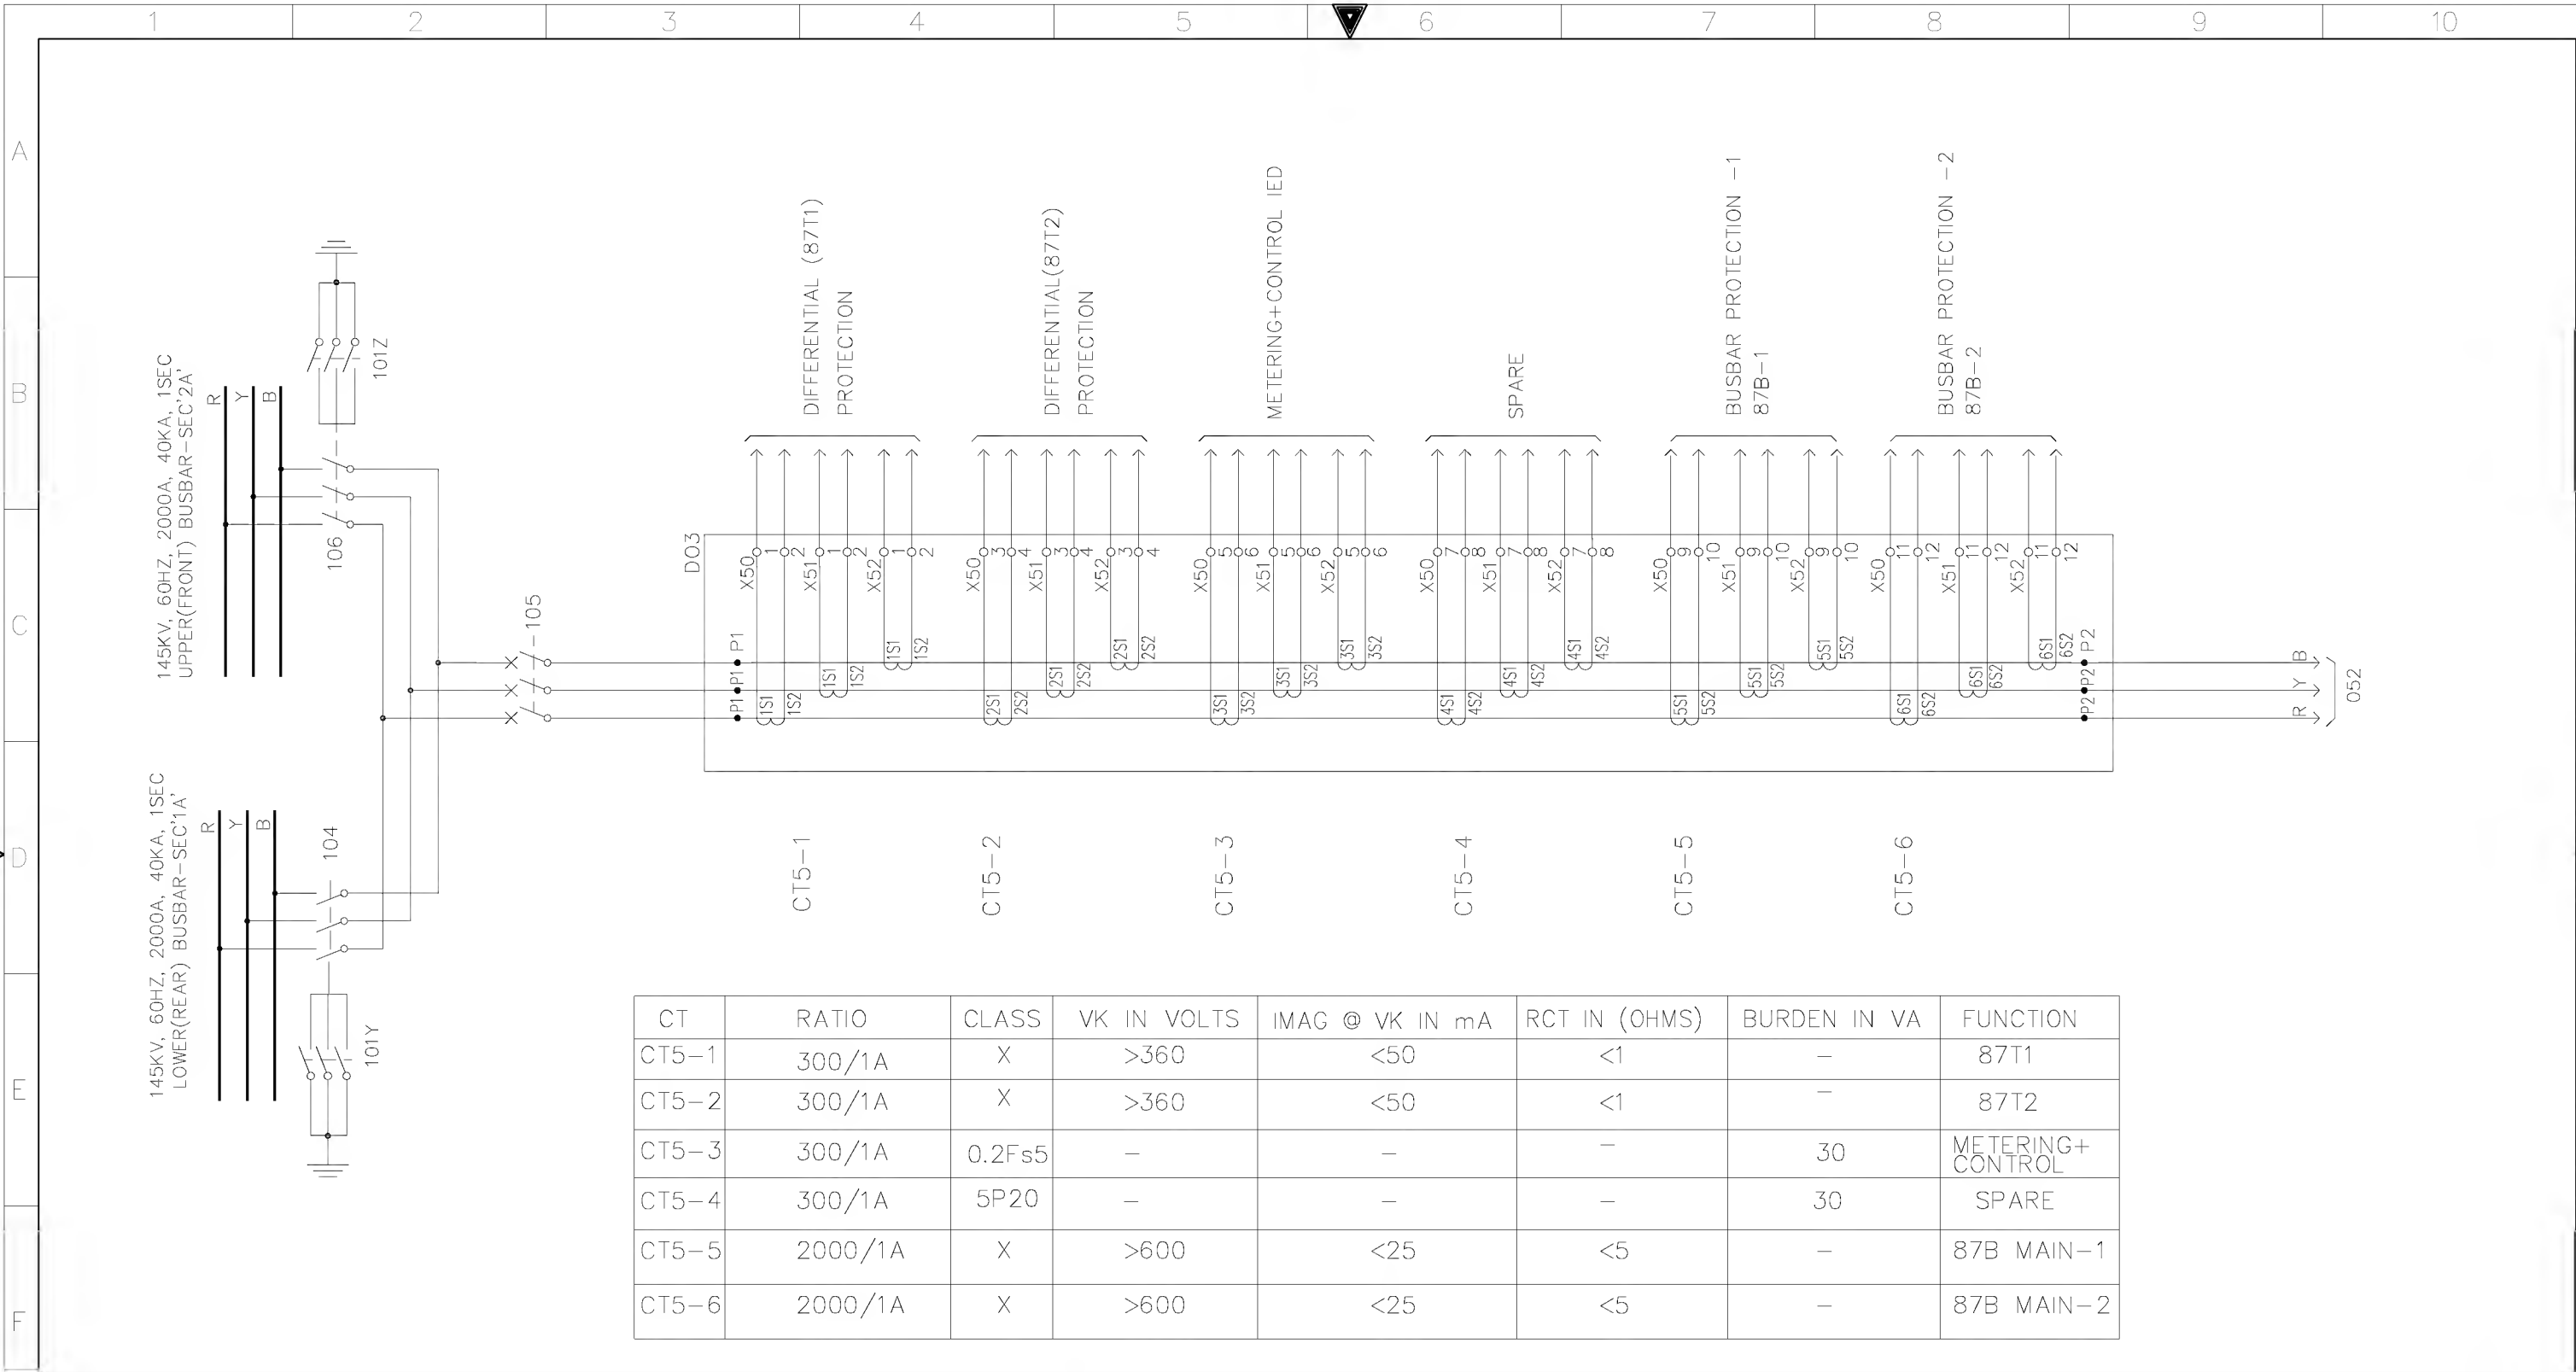

G	AS-BUILT BY _____ DATE _____		CONTRACT NO. 11131113/00		JOB ORDER NO. S-13656		PRIMARY SYSTEM (GT-2)		<div>الشركة الوطنية لنقل الكهرباء</div> <div>نقل الكهرباء</div> <div>National Grid sa</div>						
							132/13.8KV GT-2 RELAY PANEL-1/2								
	01	13 49	FACTORY ASBUILT		DRAWN BY RIZ CHECKED BY JKR		S/S 8709-132/13.8KV IN AL-KHARJ CITY		INDEX	PLANT NO.	DRAWING NUMBER		SHEET NO.		REV. NO.
	00	13 04	FOR APPROVAL		DATE STARTED 24.01.2013 DATE COMPLETED _____		RIYADH SAUDI ARABIA		-	C421	CD-322931		SHT 051	CONT. 052	01
	REV. NO.	DATE	DESCRIPTION		OPRG. DEPT. CTPD ENG. DEPT. AUT-PSAC										

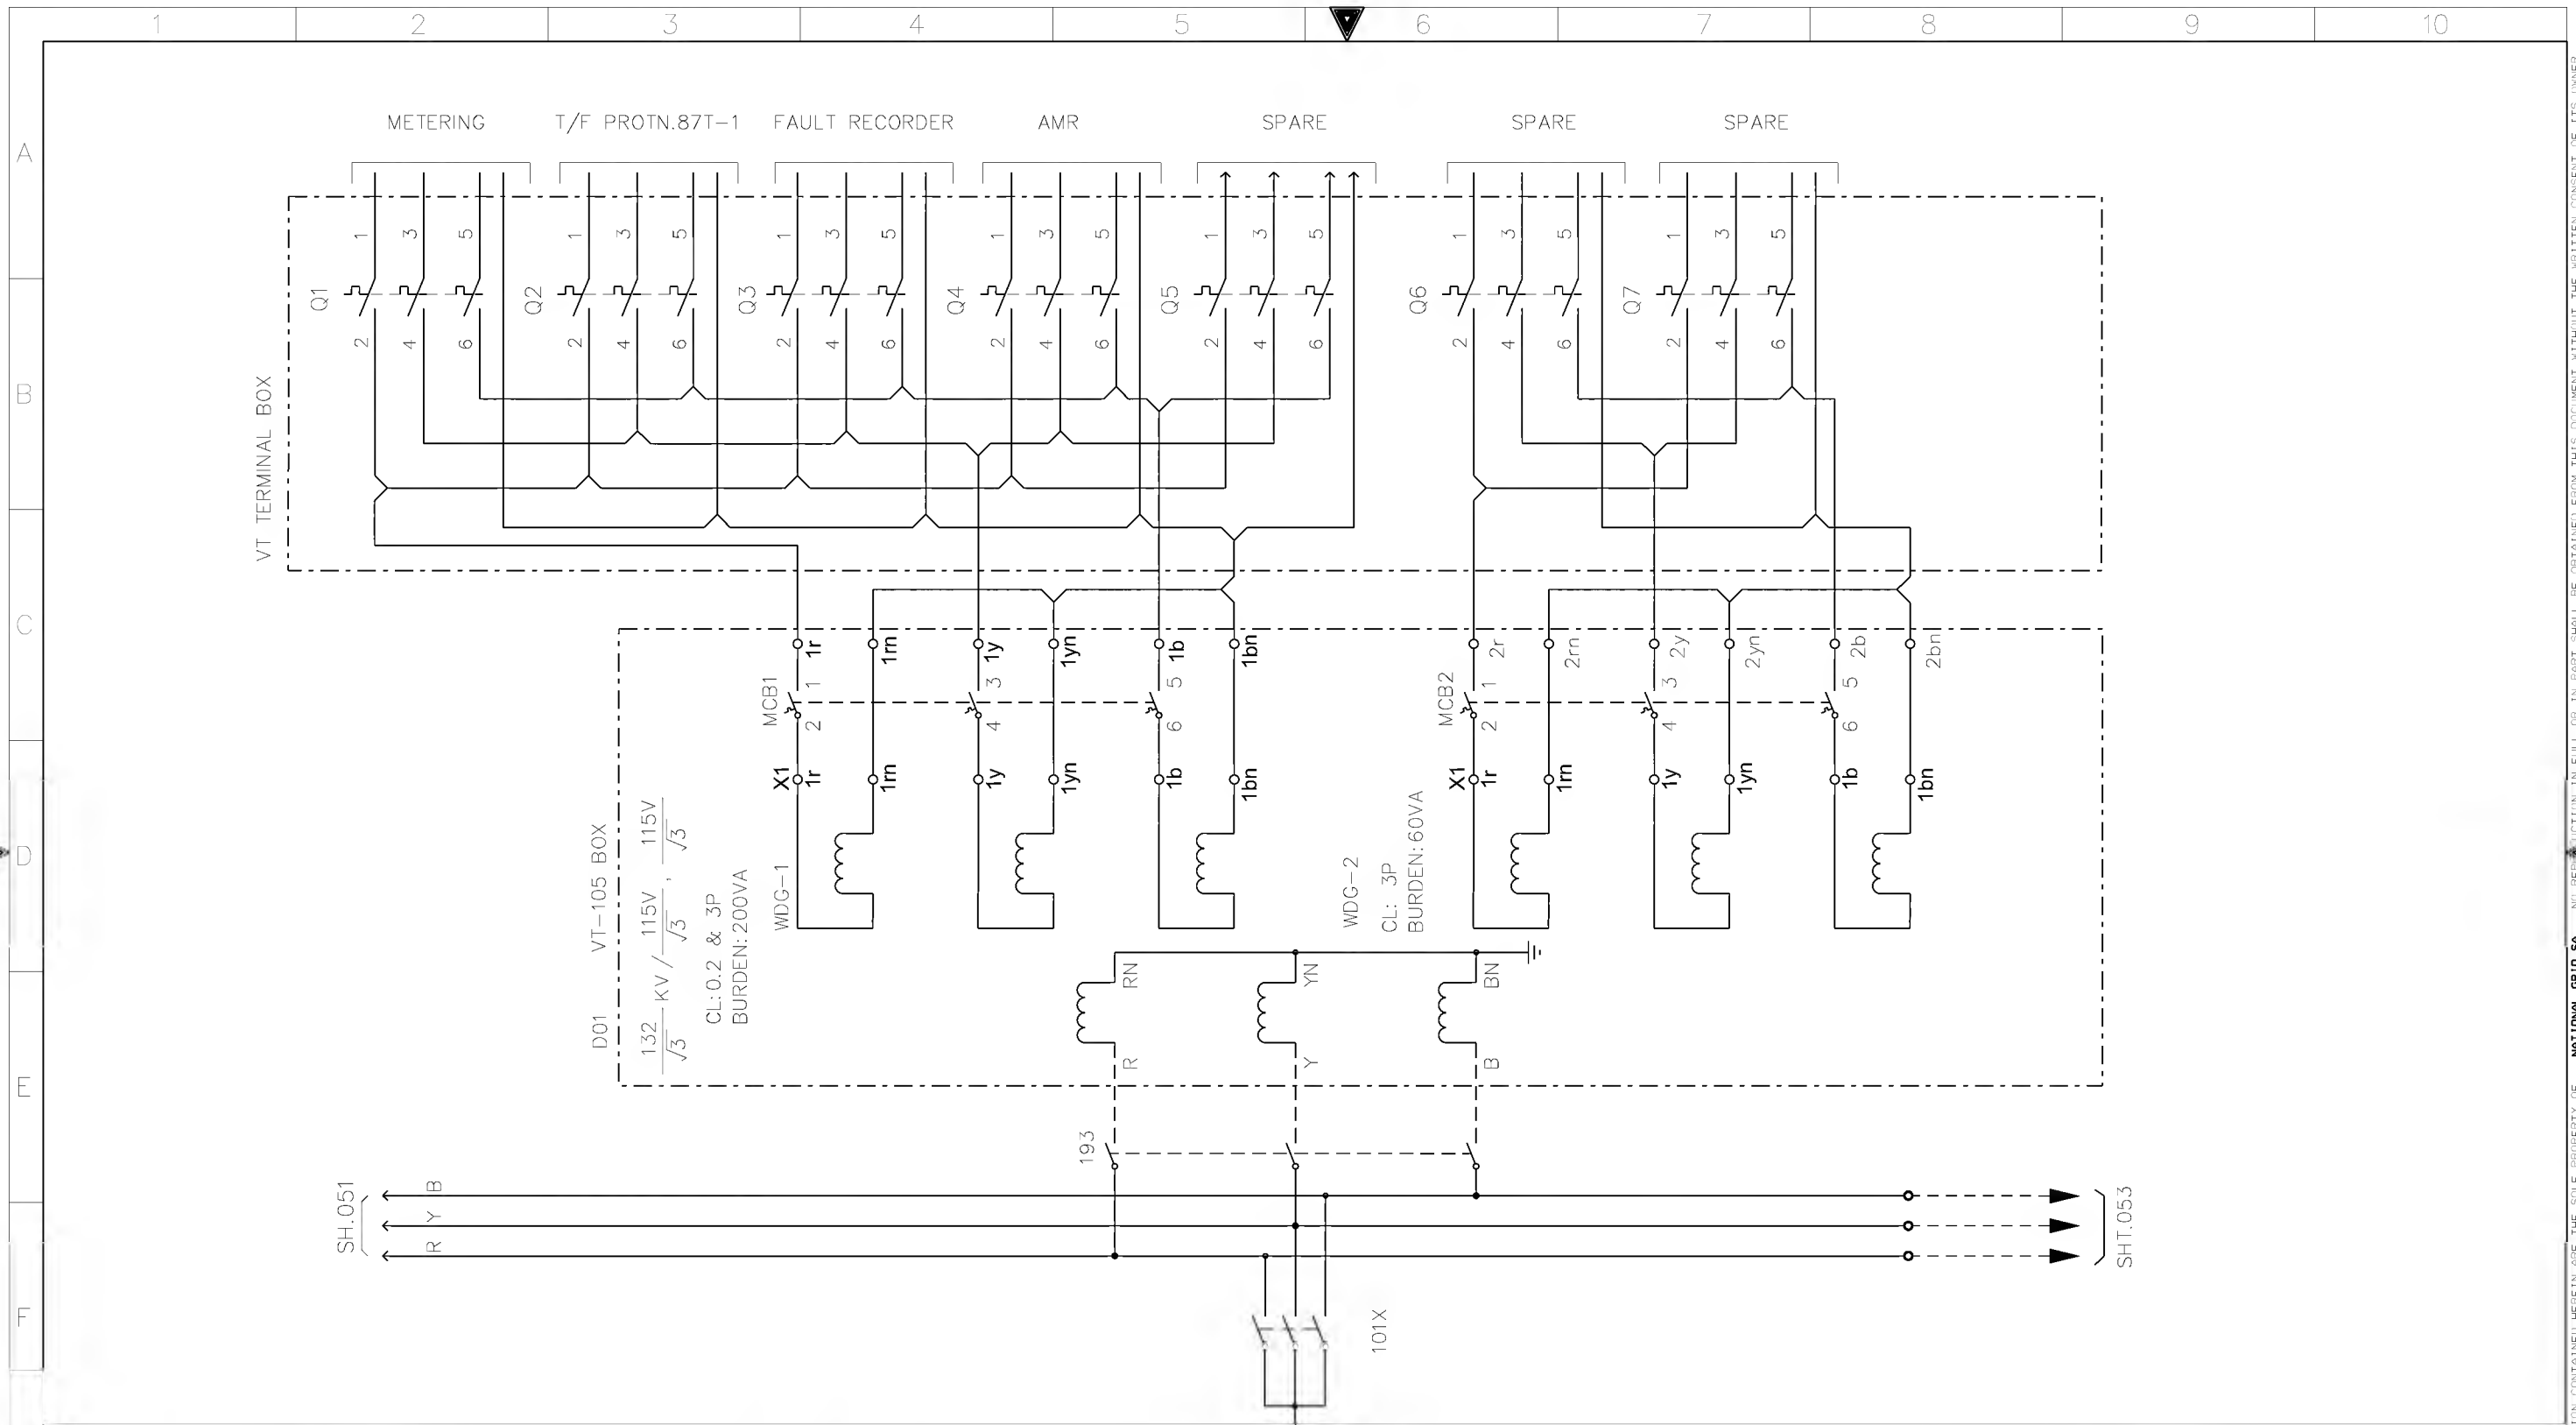


AS-BUILT BY _____ DATE _____ CONTRACT NO. 11131113/00 JOB ORDER NO. S-13656


Ø1	13 49	FACTORY ASBUILT
ØØ	13 04	FOR APPROVAL
REV. NO.	DATE	DESCRIPTION

DRAWN BY RIZ CHECKED BY JKR
DATE STARTED 24.01.2013 DATE COMPLETED _____
OPRG. DEPT. CTPD ENG. DEPT. AUT-PSAC

PRIMARY SYSTEM (GT-2)
132/13.8KV GT-2 RELAY PANEL-1/2
S/S 8709-132/13.8KV IN AL-KHARJ CITY
RIYADH SAUDI ARABIA

الشركة الوطنية لنقل الكهرباء		نقل الكهرباء		National Grid sa	
INDEX	PLANT NO.	DRAWING NUMBER	SHEET NO.	REV. NO.	
-	C421	CD-322931	SHT 052	CONT. 053	01

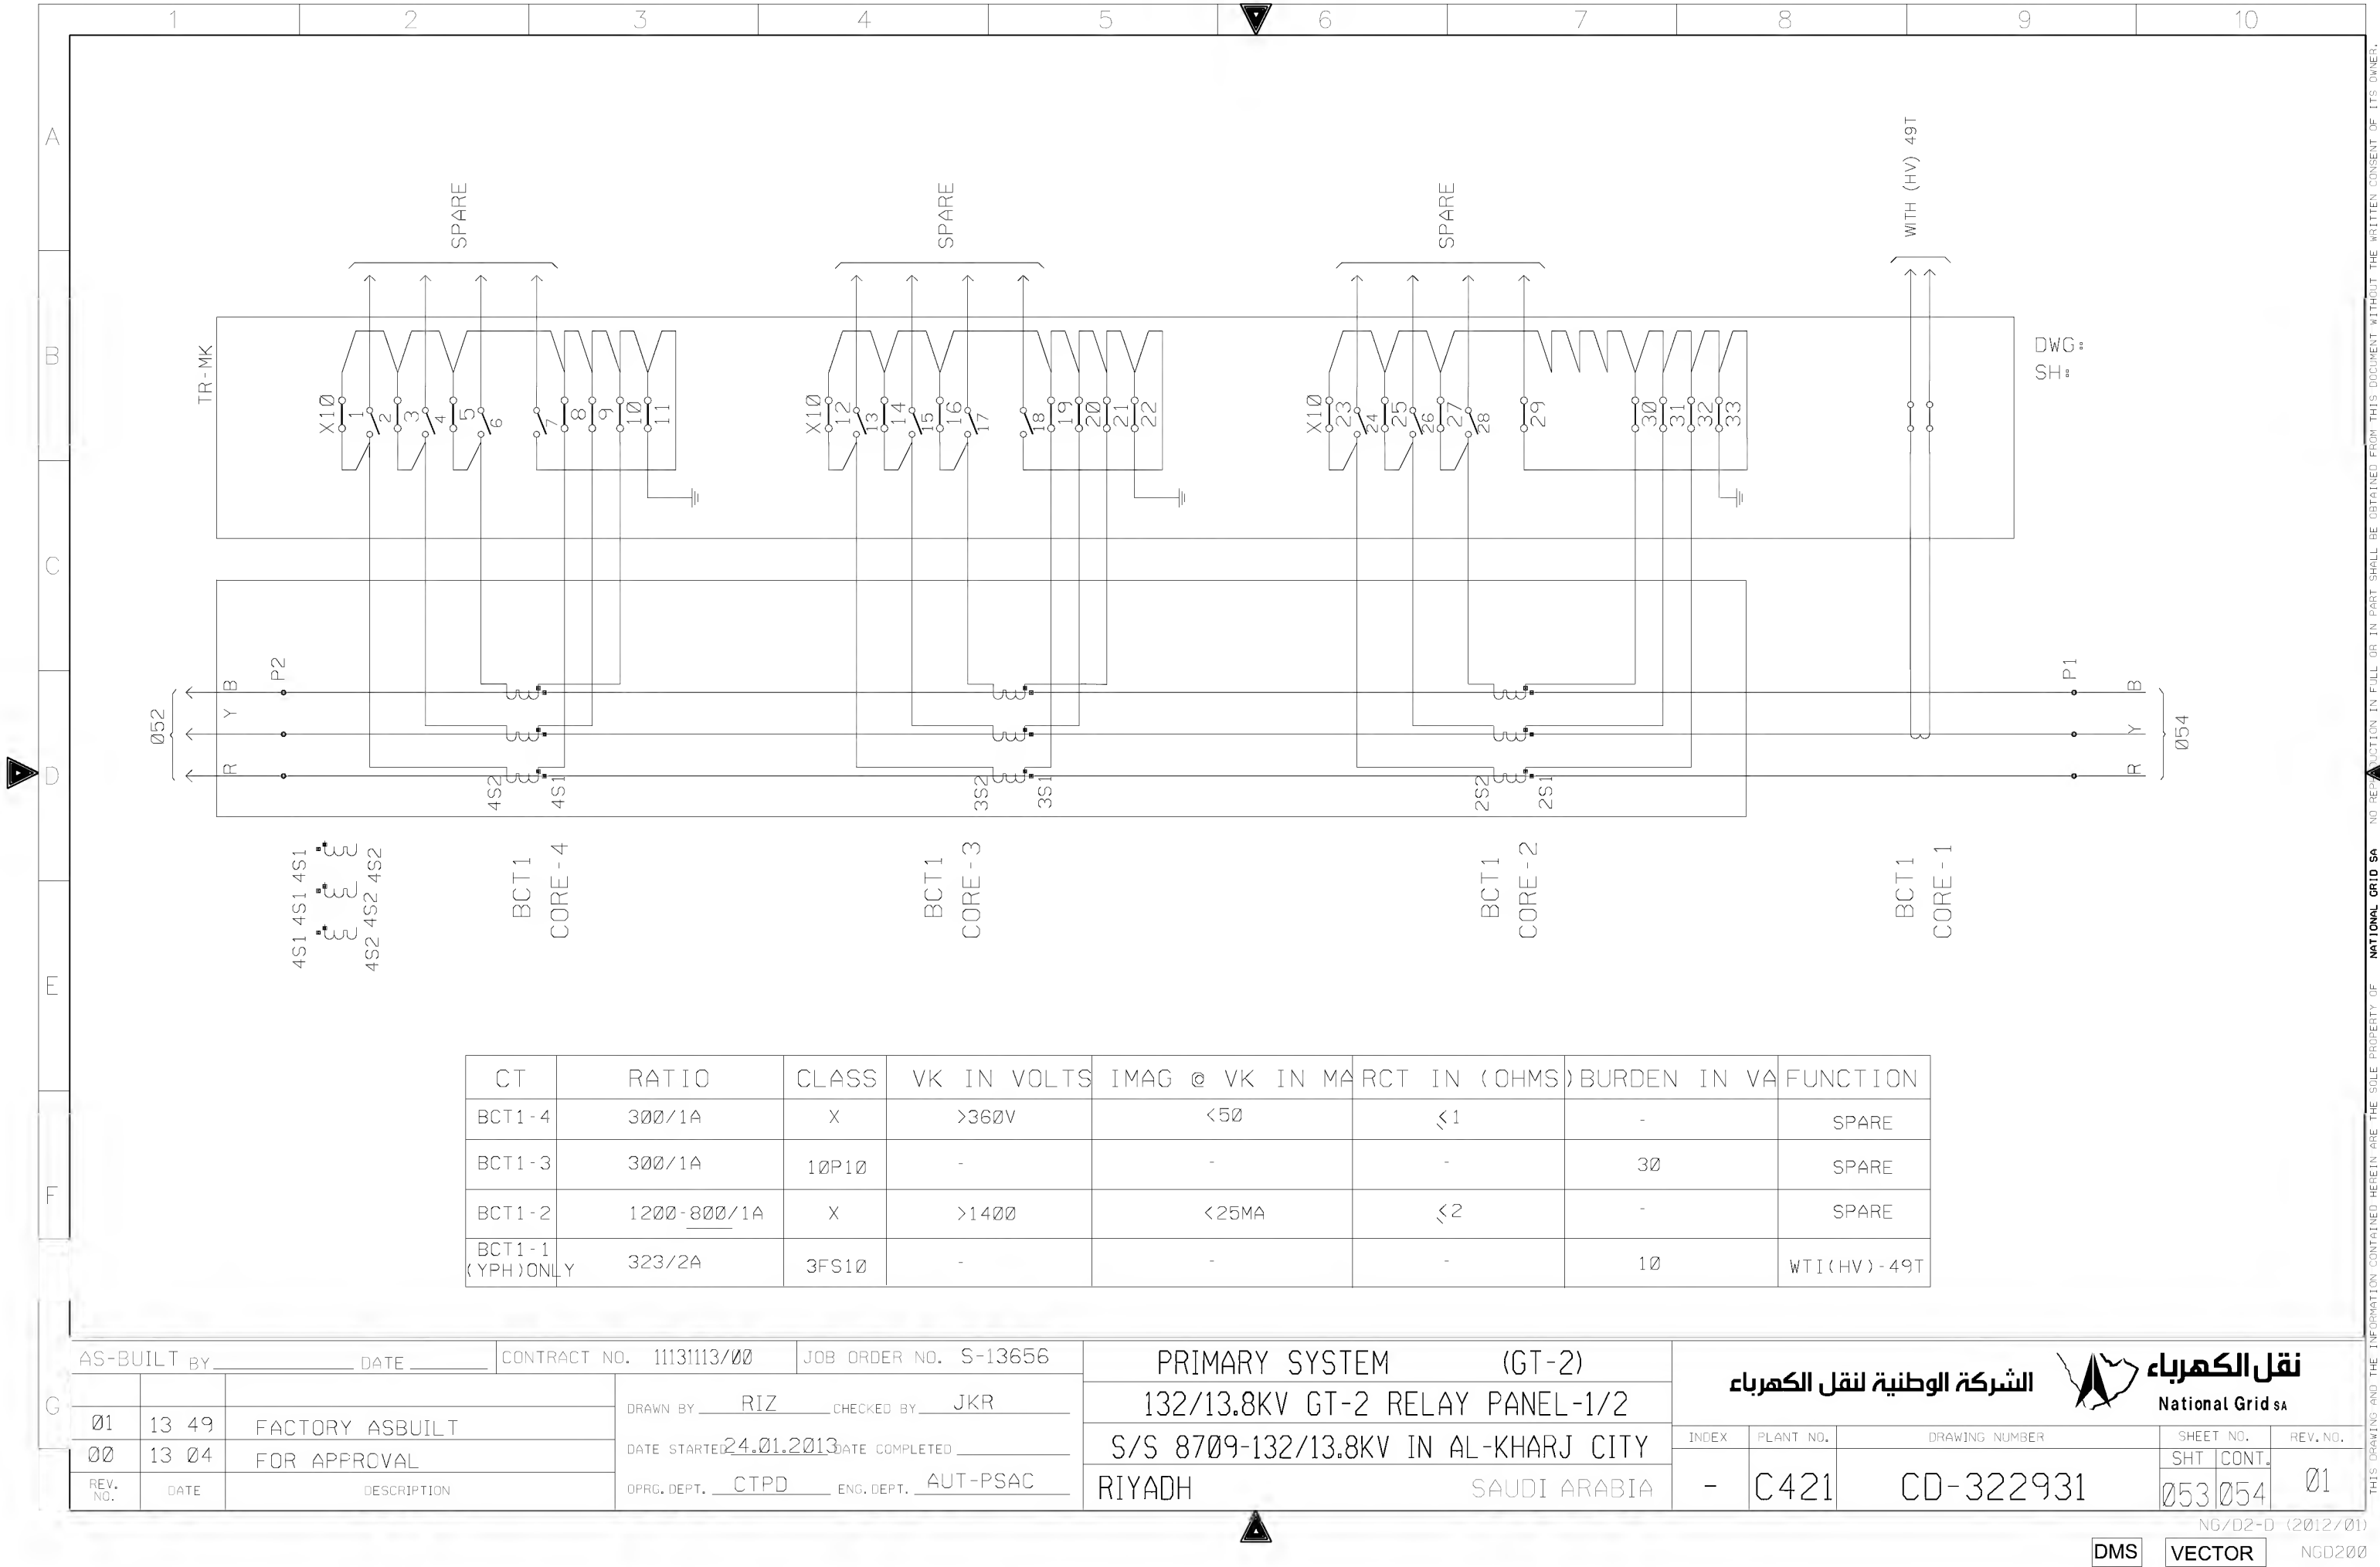


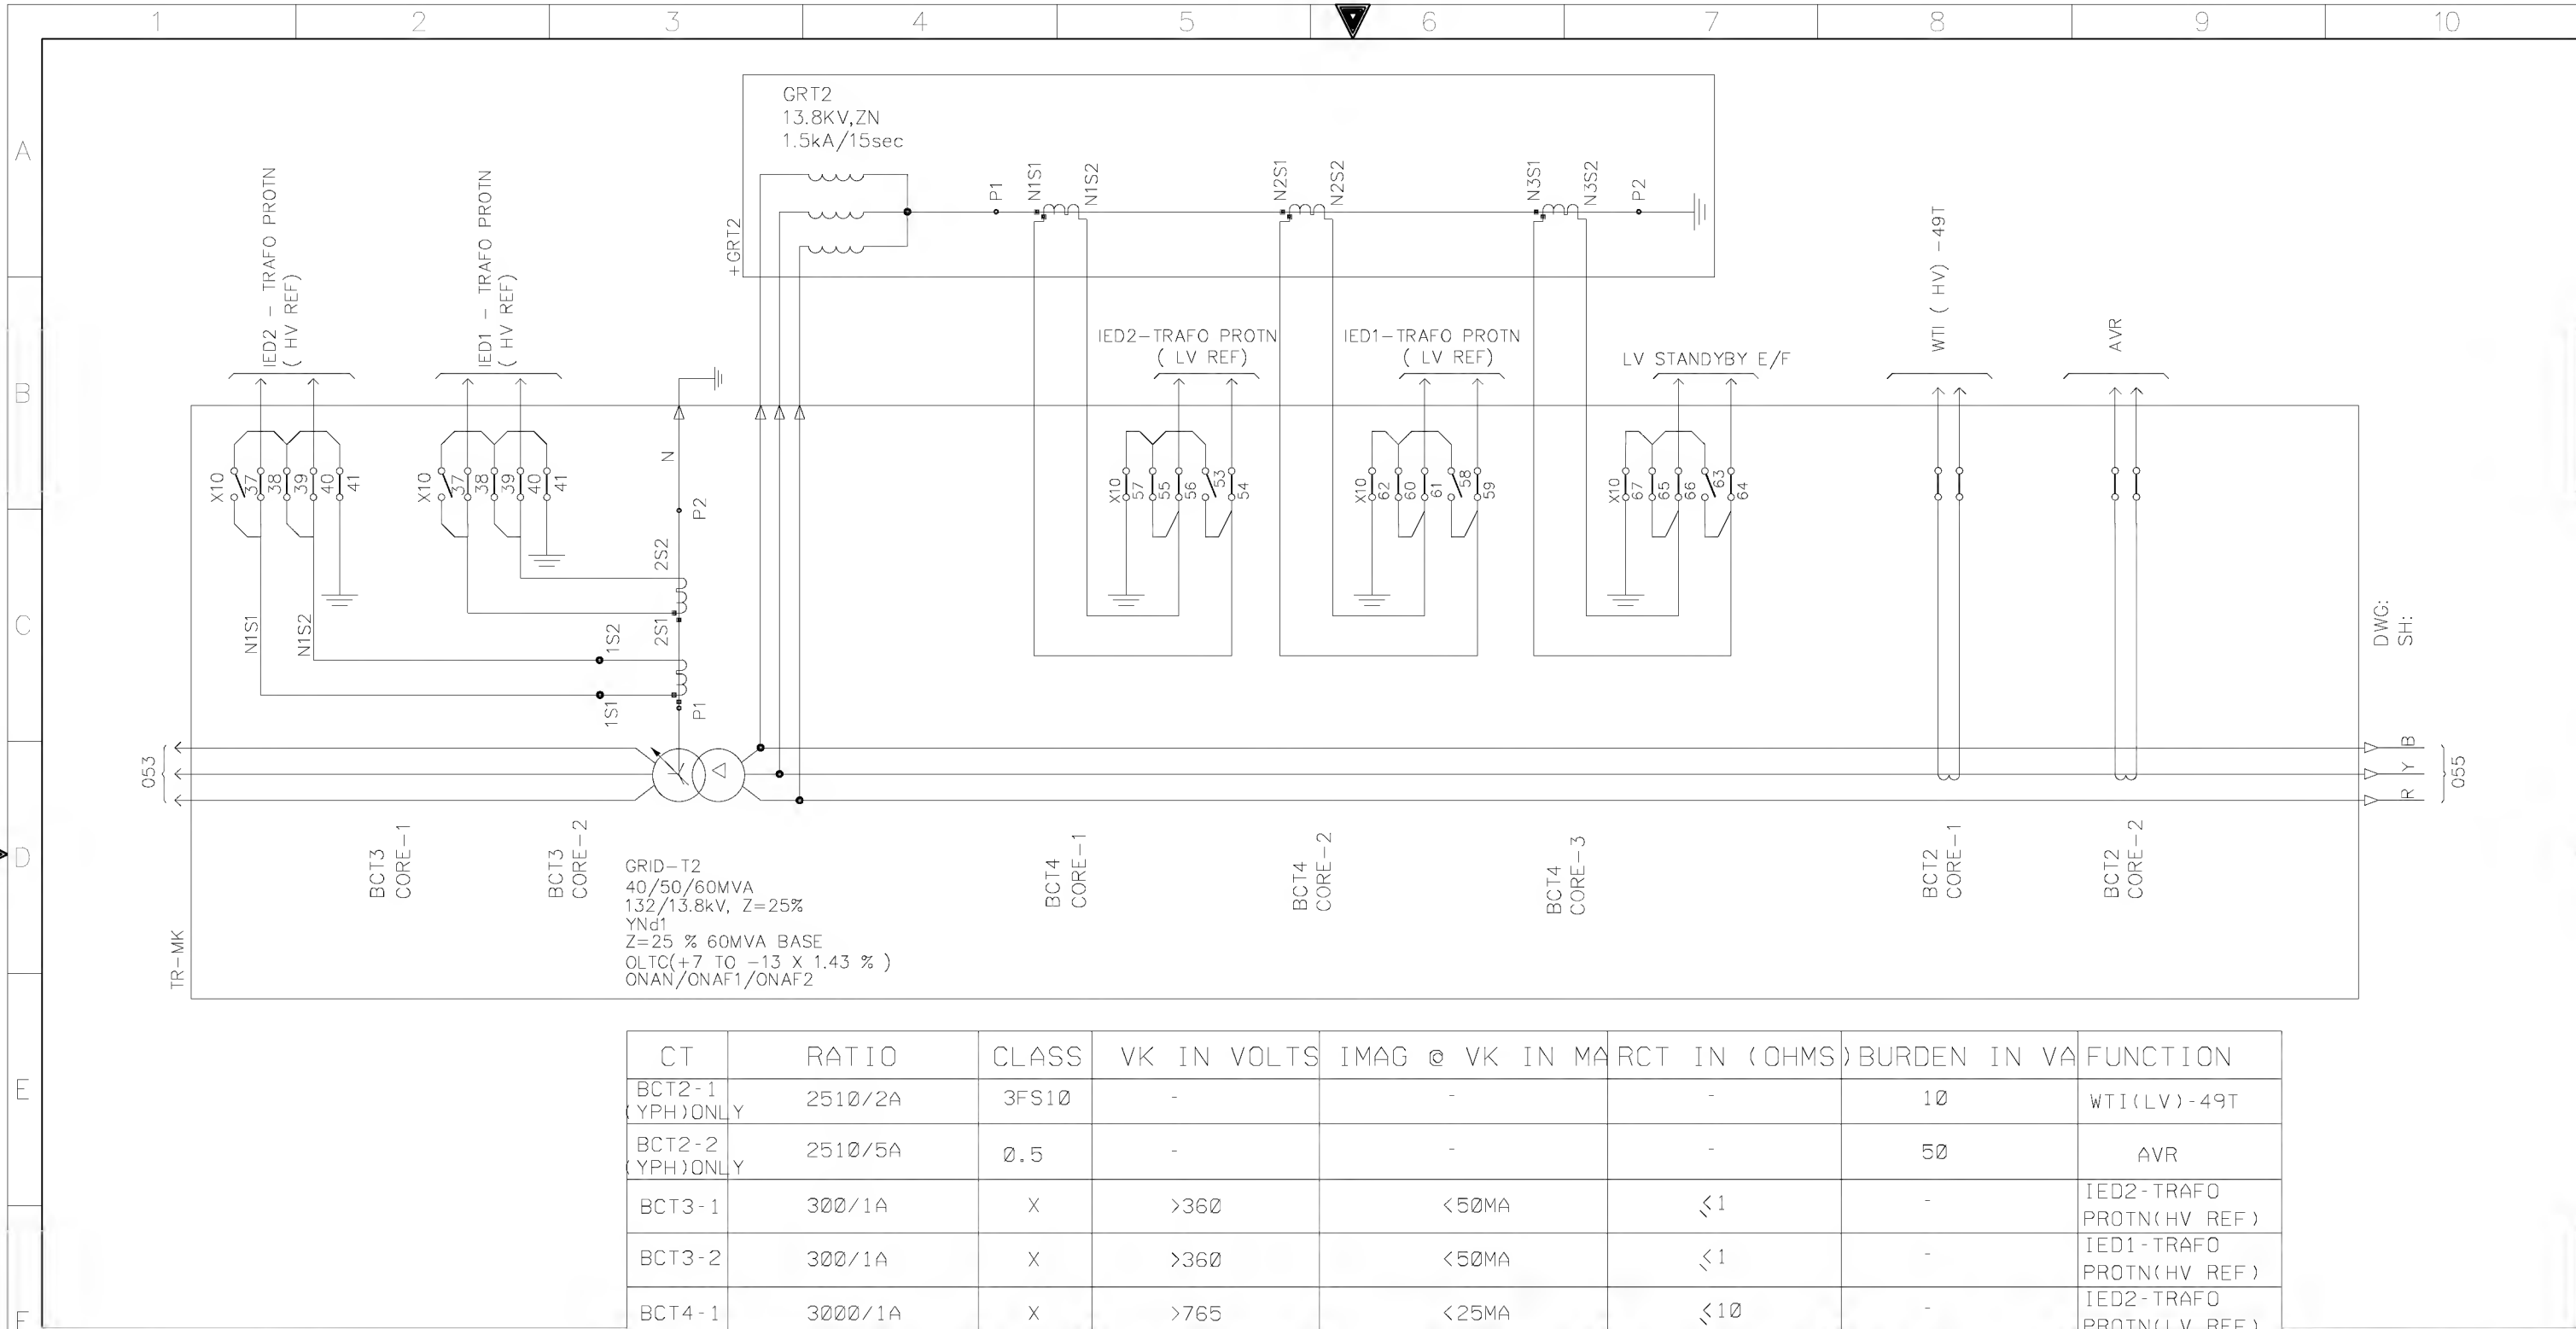

AS-BUILT BY _____ DATE _____			CONTRACT NO. 11131113/00		JOB ORDER NO. S-13656	
01	13 49	FACTORY ASBUILT	DRAWN BY RIZ		CHECKED BY JKR	
00	13 04	FOR APPROVAL	DATE STARTED 24.01.2013		DATE COMPLETED _____	
REV. NO.	DATE	DESCRIPTION	OPRG. DEPT. CTPD		ENG. DEPT. AUT-PSAC	

PRIMARY SYSTEM (GT-2)	
132/13.8KV GT-2 RELAY PANEL-1/2	
S/S 8709-132/13.8KV IN AL-KHARJ CITY	
RIYADH SAUDI ARABIA	

الشركة الوطنية لنقل الكهرباء				نقل الكهرباء		
				National Grid sa		
INDEX	PLANT NO.	DRAWING NUMBER		SHEET NO.		REV. NO.
-	C421	CD-322931		SHT	CONT.	01
				054	055	

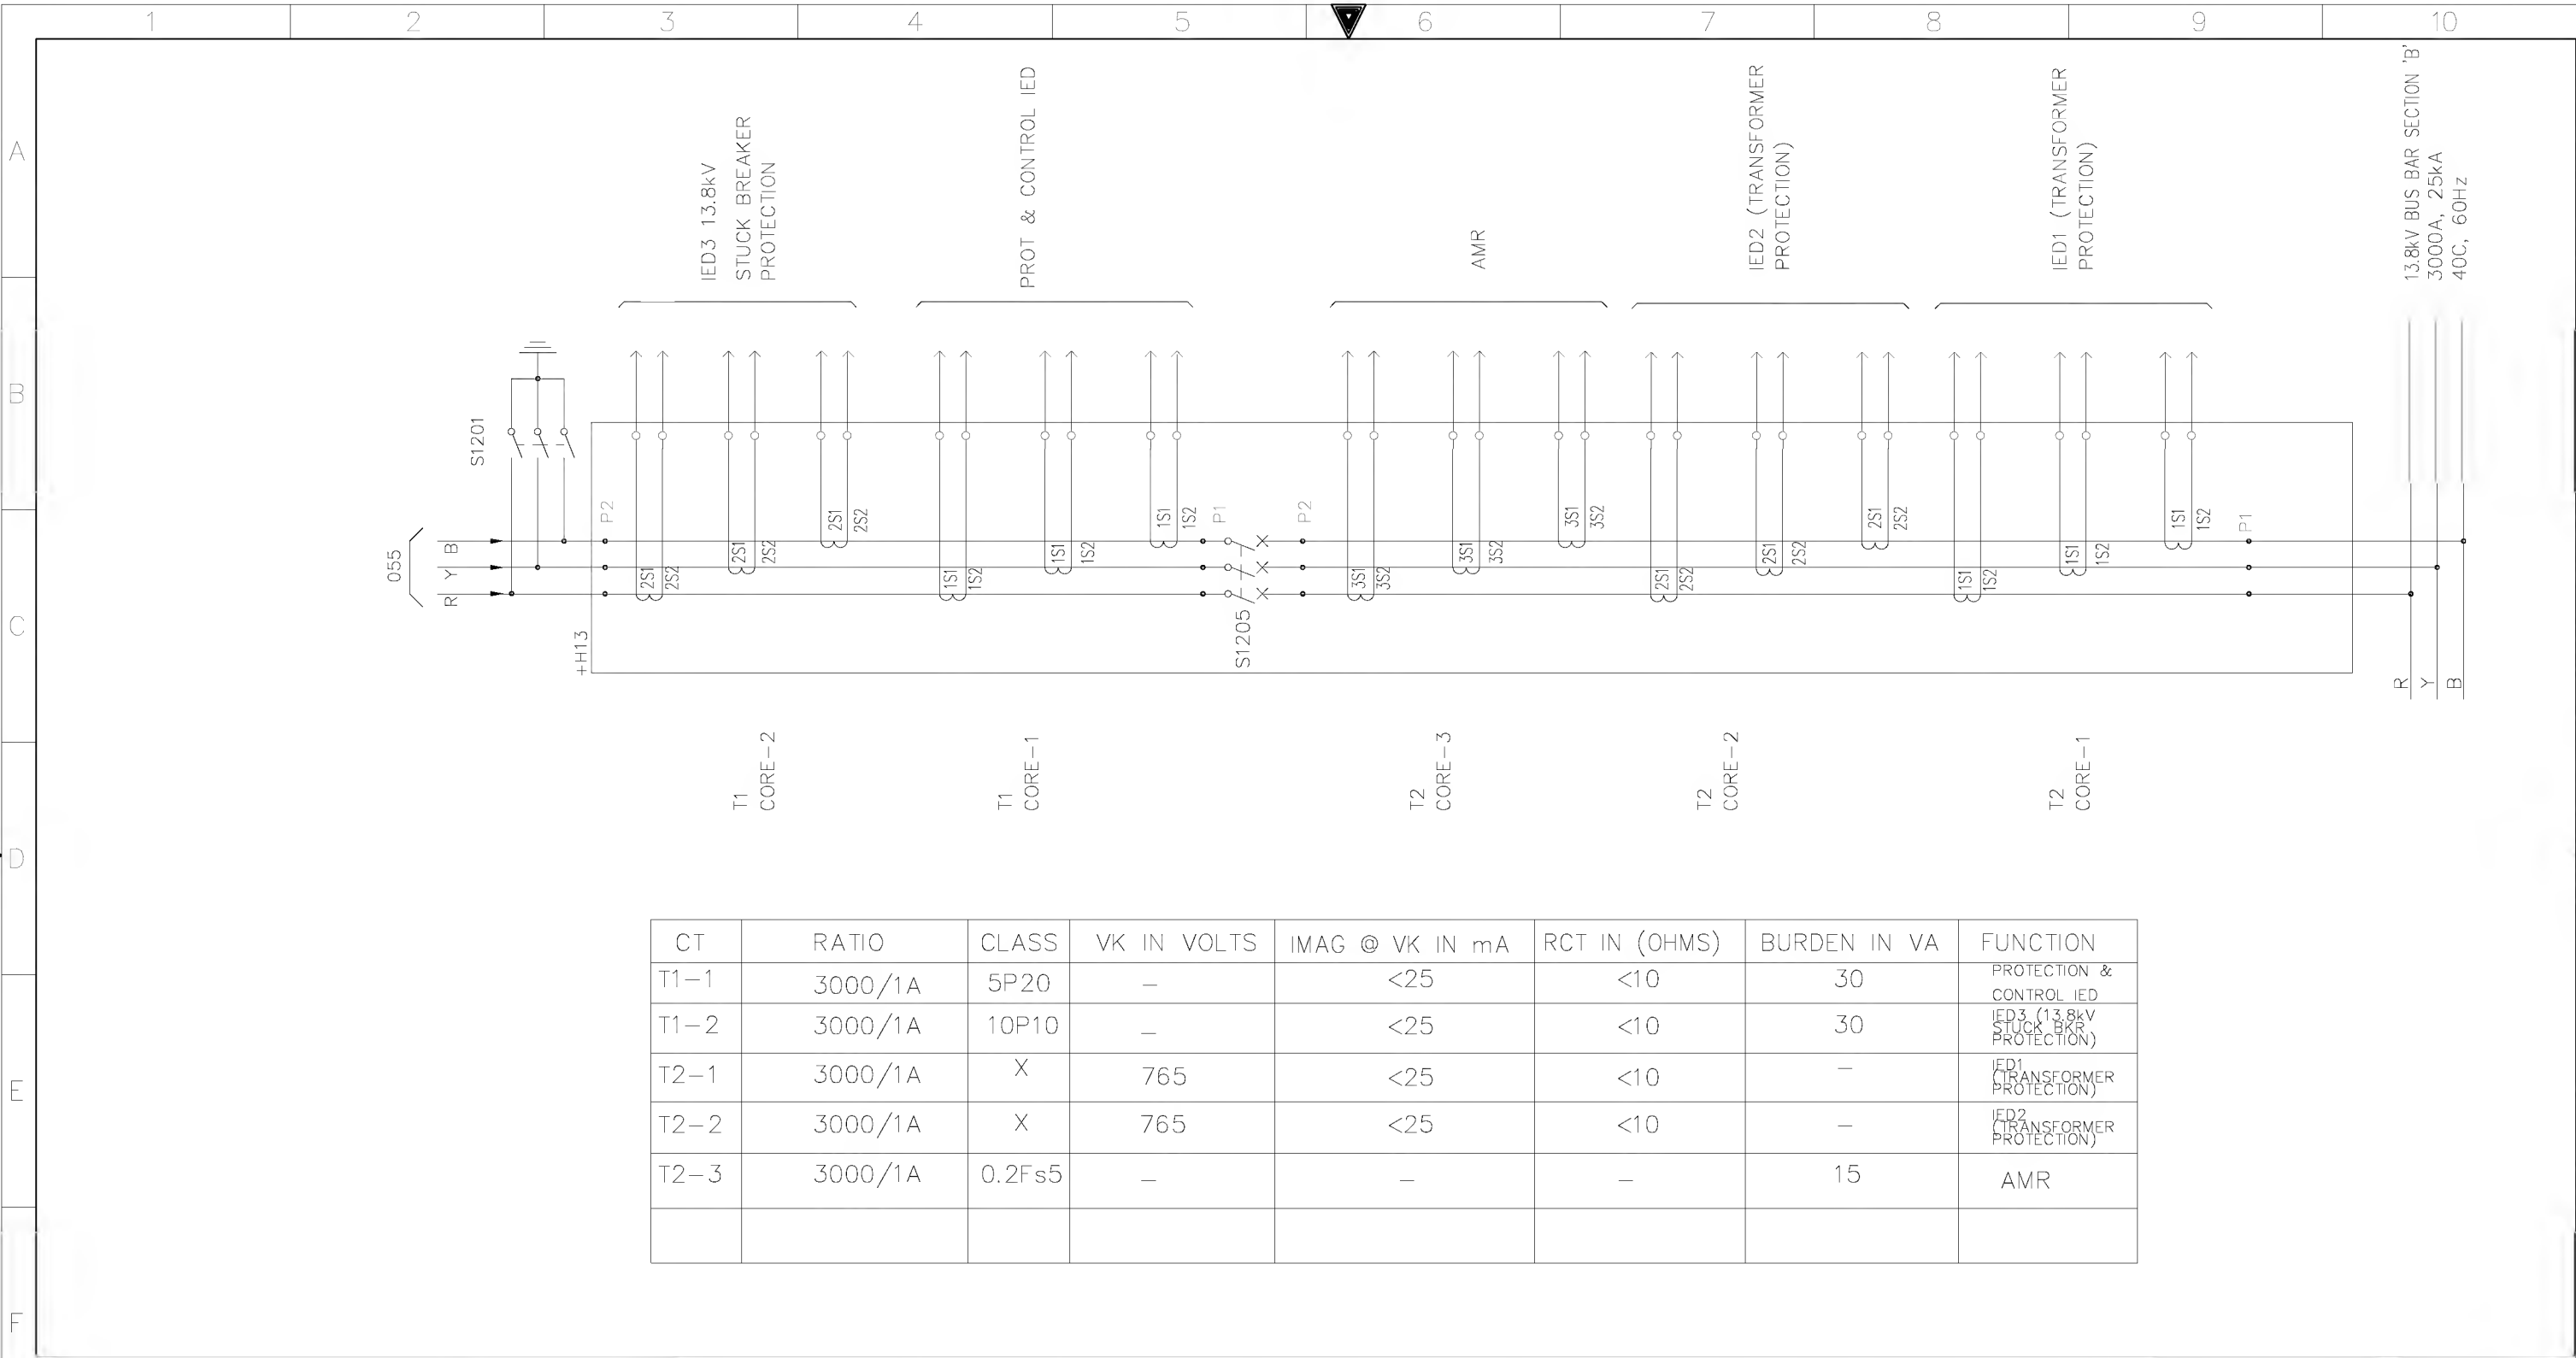


CT	RATIO	CLASS	VK IN VOLTS	IMAG @ VK IN mA	RCT IN (OHMS)	BURDEN IN VA	FUNCTION
T1-1	3000/1A	5P20	—	<25	<10	30	PROTECTION & CONTROL IED
T1-2	3000/1A	10P10	—	<25	<10	30	IED3 (13.8kV STUCK BKR PROTECTION)
T2-1	3000/1A	X	765	<25	<10	—	IED1 (TRANSFORMER PROTECTION)
T2-2	3000/1A	X	765	<25	<10	—	IED2 (TRANSFORMER PROTECTION)
T2-3	3000/1A	0.2Fs5	—	—	—	15	AMR

AS-BUILT BY _____ DATE _____ CONTRACT NO. 11131113/00 JOB ORDER NO. S-13656

01	13 49	FACTORY ASBUILT	DRAWN BY RIZ	CHECKED BY JKR
00	13 04	FOR APPROVAL	DATE STARTED 24.01.2013	DATE COMPLETED _____
REV. NO.	DATE	DESCRIPTION	OPRG. DEPT. CTPD	ENG. DEPT. AUT-PSAC

PRIMARY SYSTEM (GT-2)
132/13.8KV GT-2 RELAY PANEL-1/2
S/S 8709-132/13.8KV IN AL-KHARJ CITY
RIYADH SAUDI ARABIA

الشركة الوطنية لنقل الكهرباء			 نقل الكهرباء		
			National Grid sa		
INDEX	PLANT NO.	DRAWING NUMBER	SHEET NO.		REV. NO.
-	C421	CD-322931	SHT	CONT.	01
			056	211	

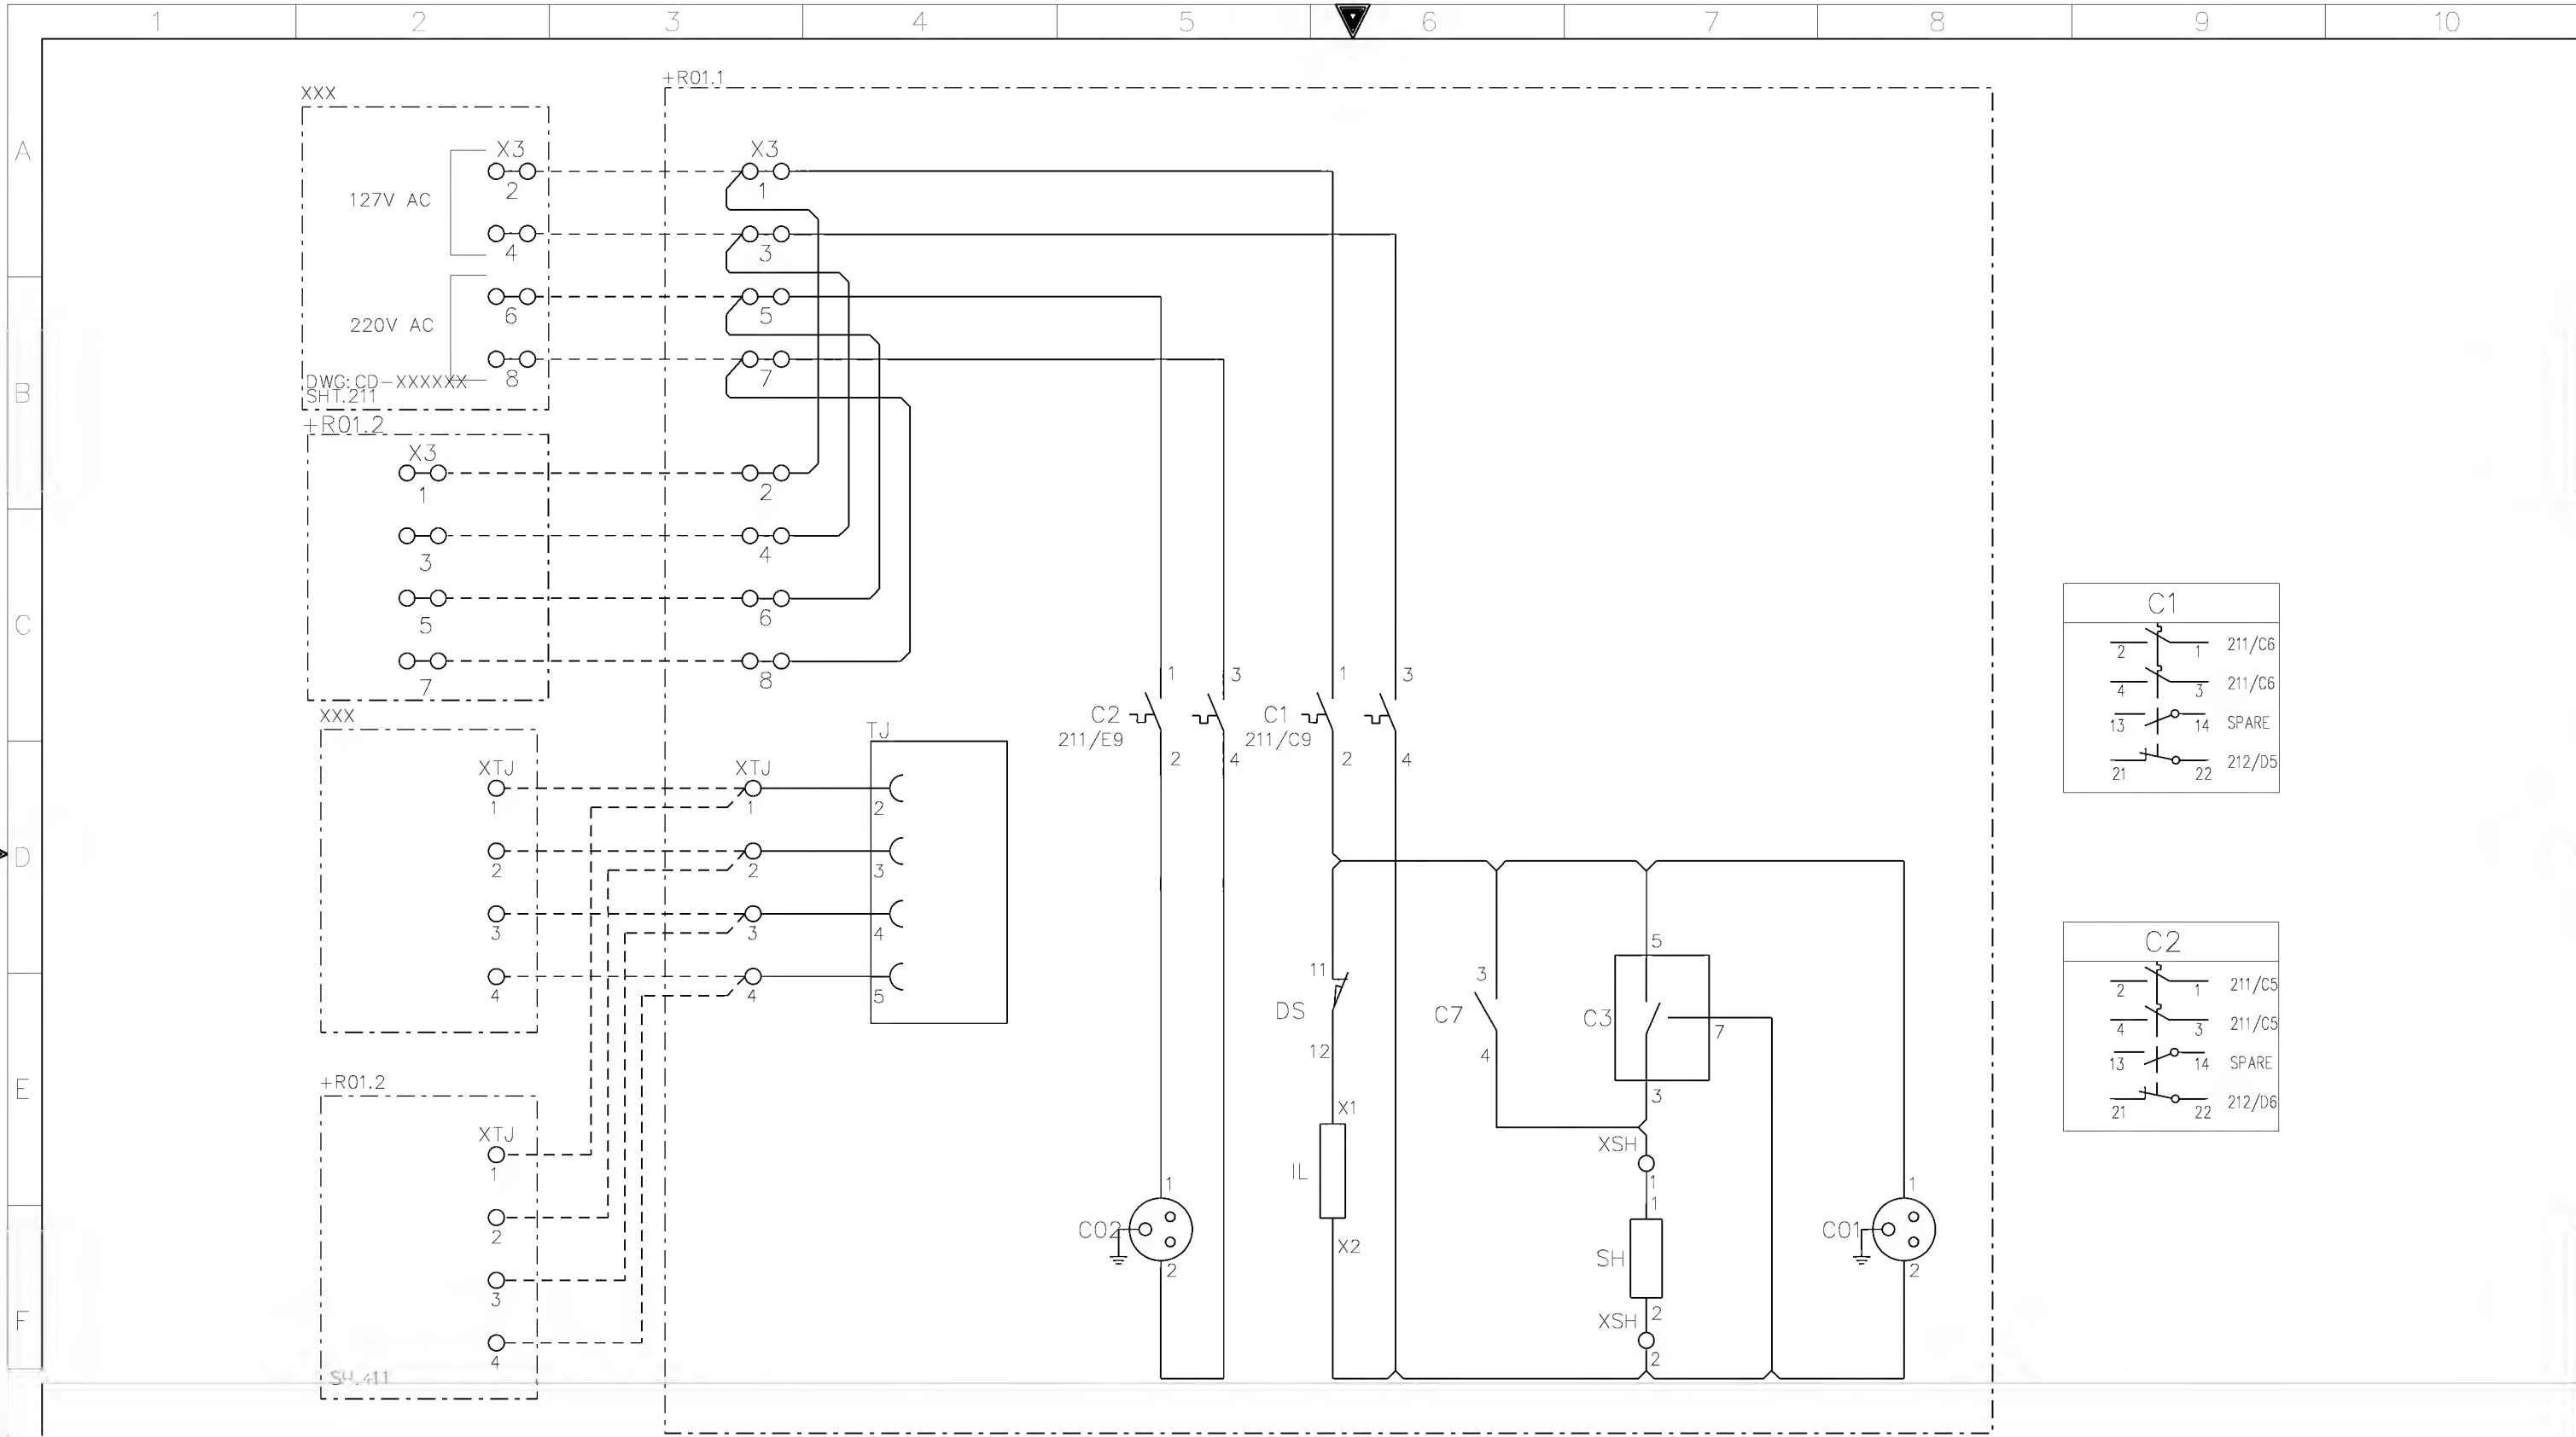


AS-BUILT BY _____ DATE _____ CONTRACT NO. 11131113/00 JOB ORDER NO. S-13656

01	13 49	FACTORY ASBUILT	DRAWN BY RIZ	CHECKED BY JKR
00	13 04	FOR APPROVAL	DATE STARTED 24.01.2013	DATE COMPLETED _____
REV. NO.	DATE	DESCRIPTION	OPRG. DEPT. CTPD	ENG. DEPT. AUT-PSAC

AC SUPPLY FOR ILLUMINATION & POWER SOCKET
132/13.8kV GT-2 RELAY PANEL-1 +R01.1
S/S 8709-132/13.8KV IN AL-KHARJ CITY
RIYADH SAUDI ARABIA

الشركة الوطنية لنقل الكهرباء		نقل الكهرباء		National Grid sa	
INDEX	PLANT NO.	DRAWING NUMBER	SHEET NO.	REV. NO.	
-	C421	CD-322931	SHT 211	CONT. 212	01

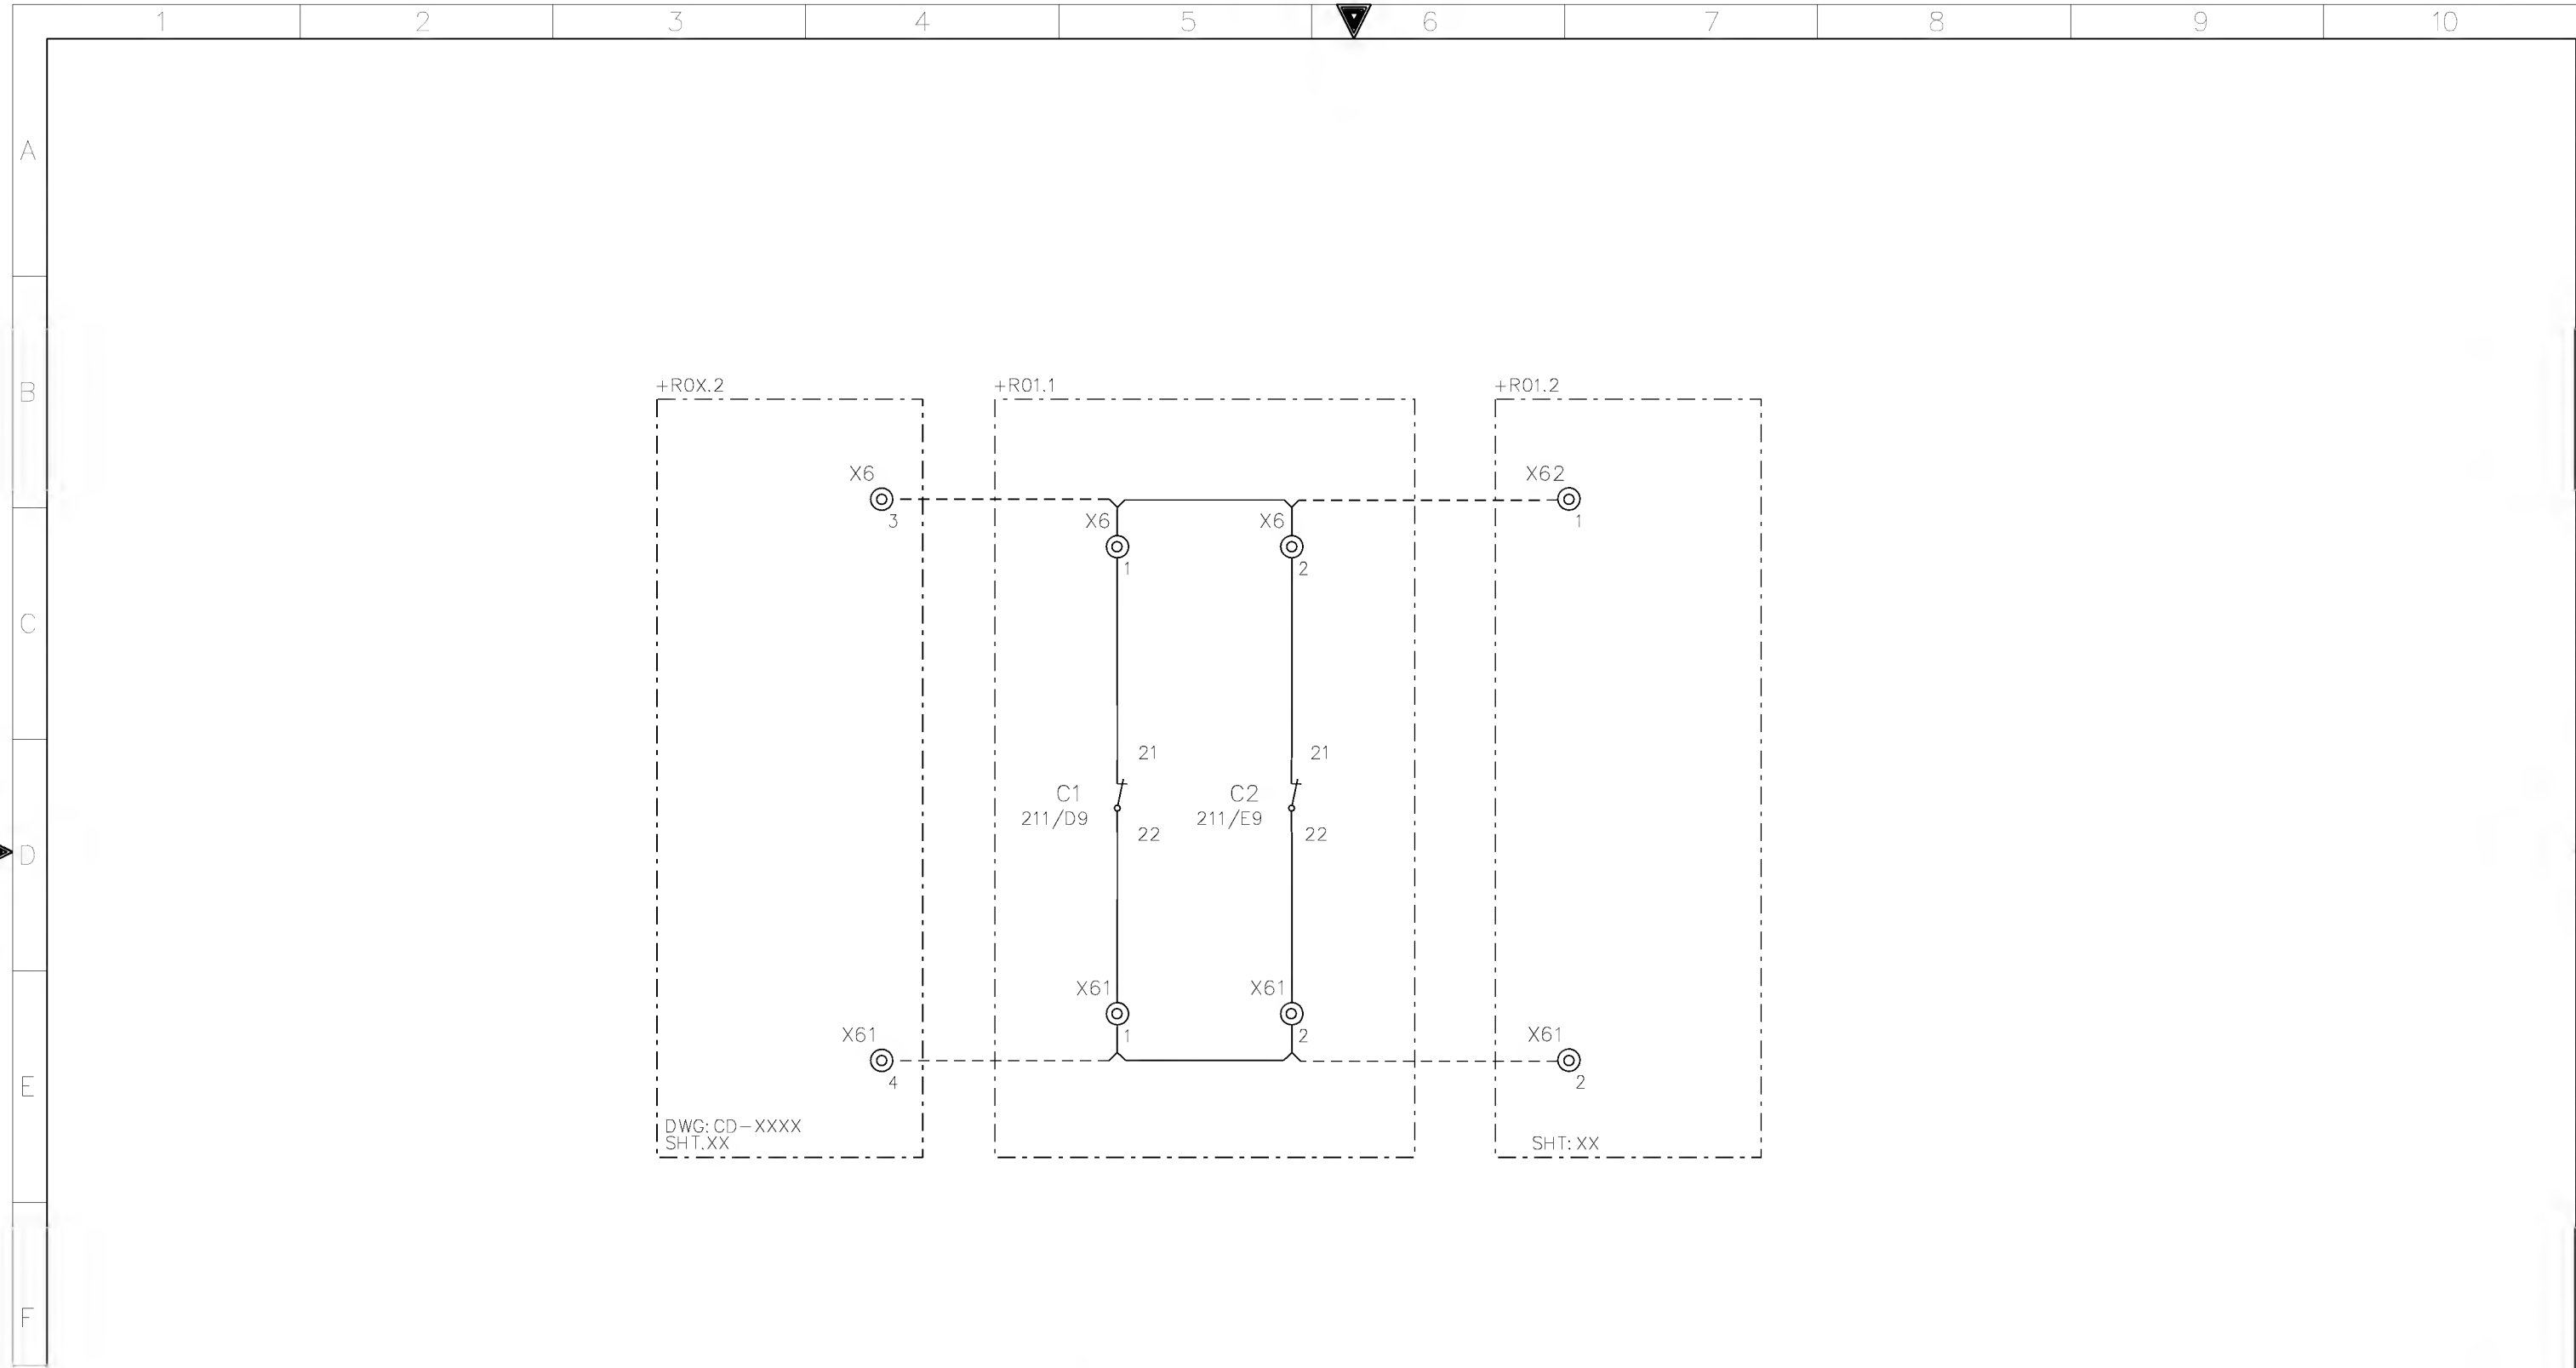


AS-BUILT BY _____ DATE _____ CONTRACT NO. 11131113/00 JOB ORDER NO. S-13656

01	13 49	FACTORY ASBUILT	DRAWN BY RIZ	CHECKED BY JKR
00	13 04	FOR APPROVAL	DATE STARTED 24.01.2013	DATE COMPLETED
REV. NO.	DATE	DESCRIPTION	OPRG. DEPT. CTPD	ENG. DEPT. AUT-PSAC

CUB.LIGHTING,HEATER&SOKET ALARM CKT.
132/13.8kv GT-2 RELAY PANEL-1 +R01.1
S/S 8709-132/13.8KV IN AL-KHARJ CITY
RIYADH SAUDI ARABIA


الشركة الوطنية لنقل الكهرباء		نقل الكهرباء		National Grid sa	
INDEX	PLANT NO.	DRAWING NUMBER	SHEET NO.	REV. NO.	
-	C421	CD-322931	SHT 212	CONT. 216	01

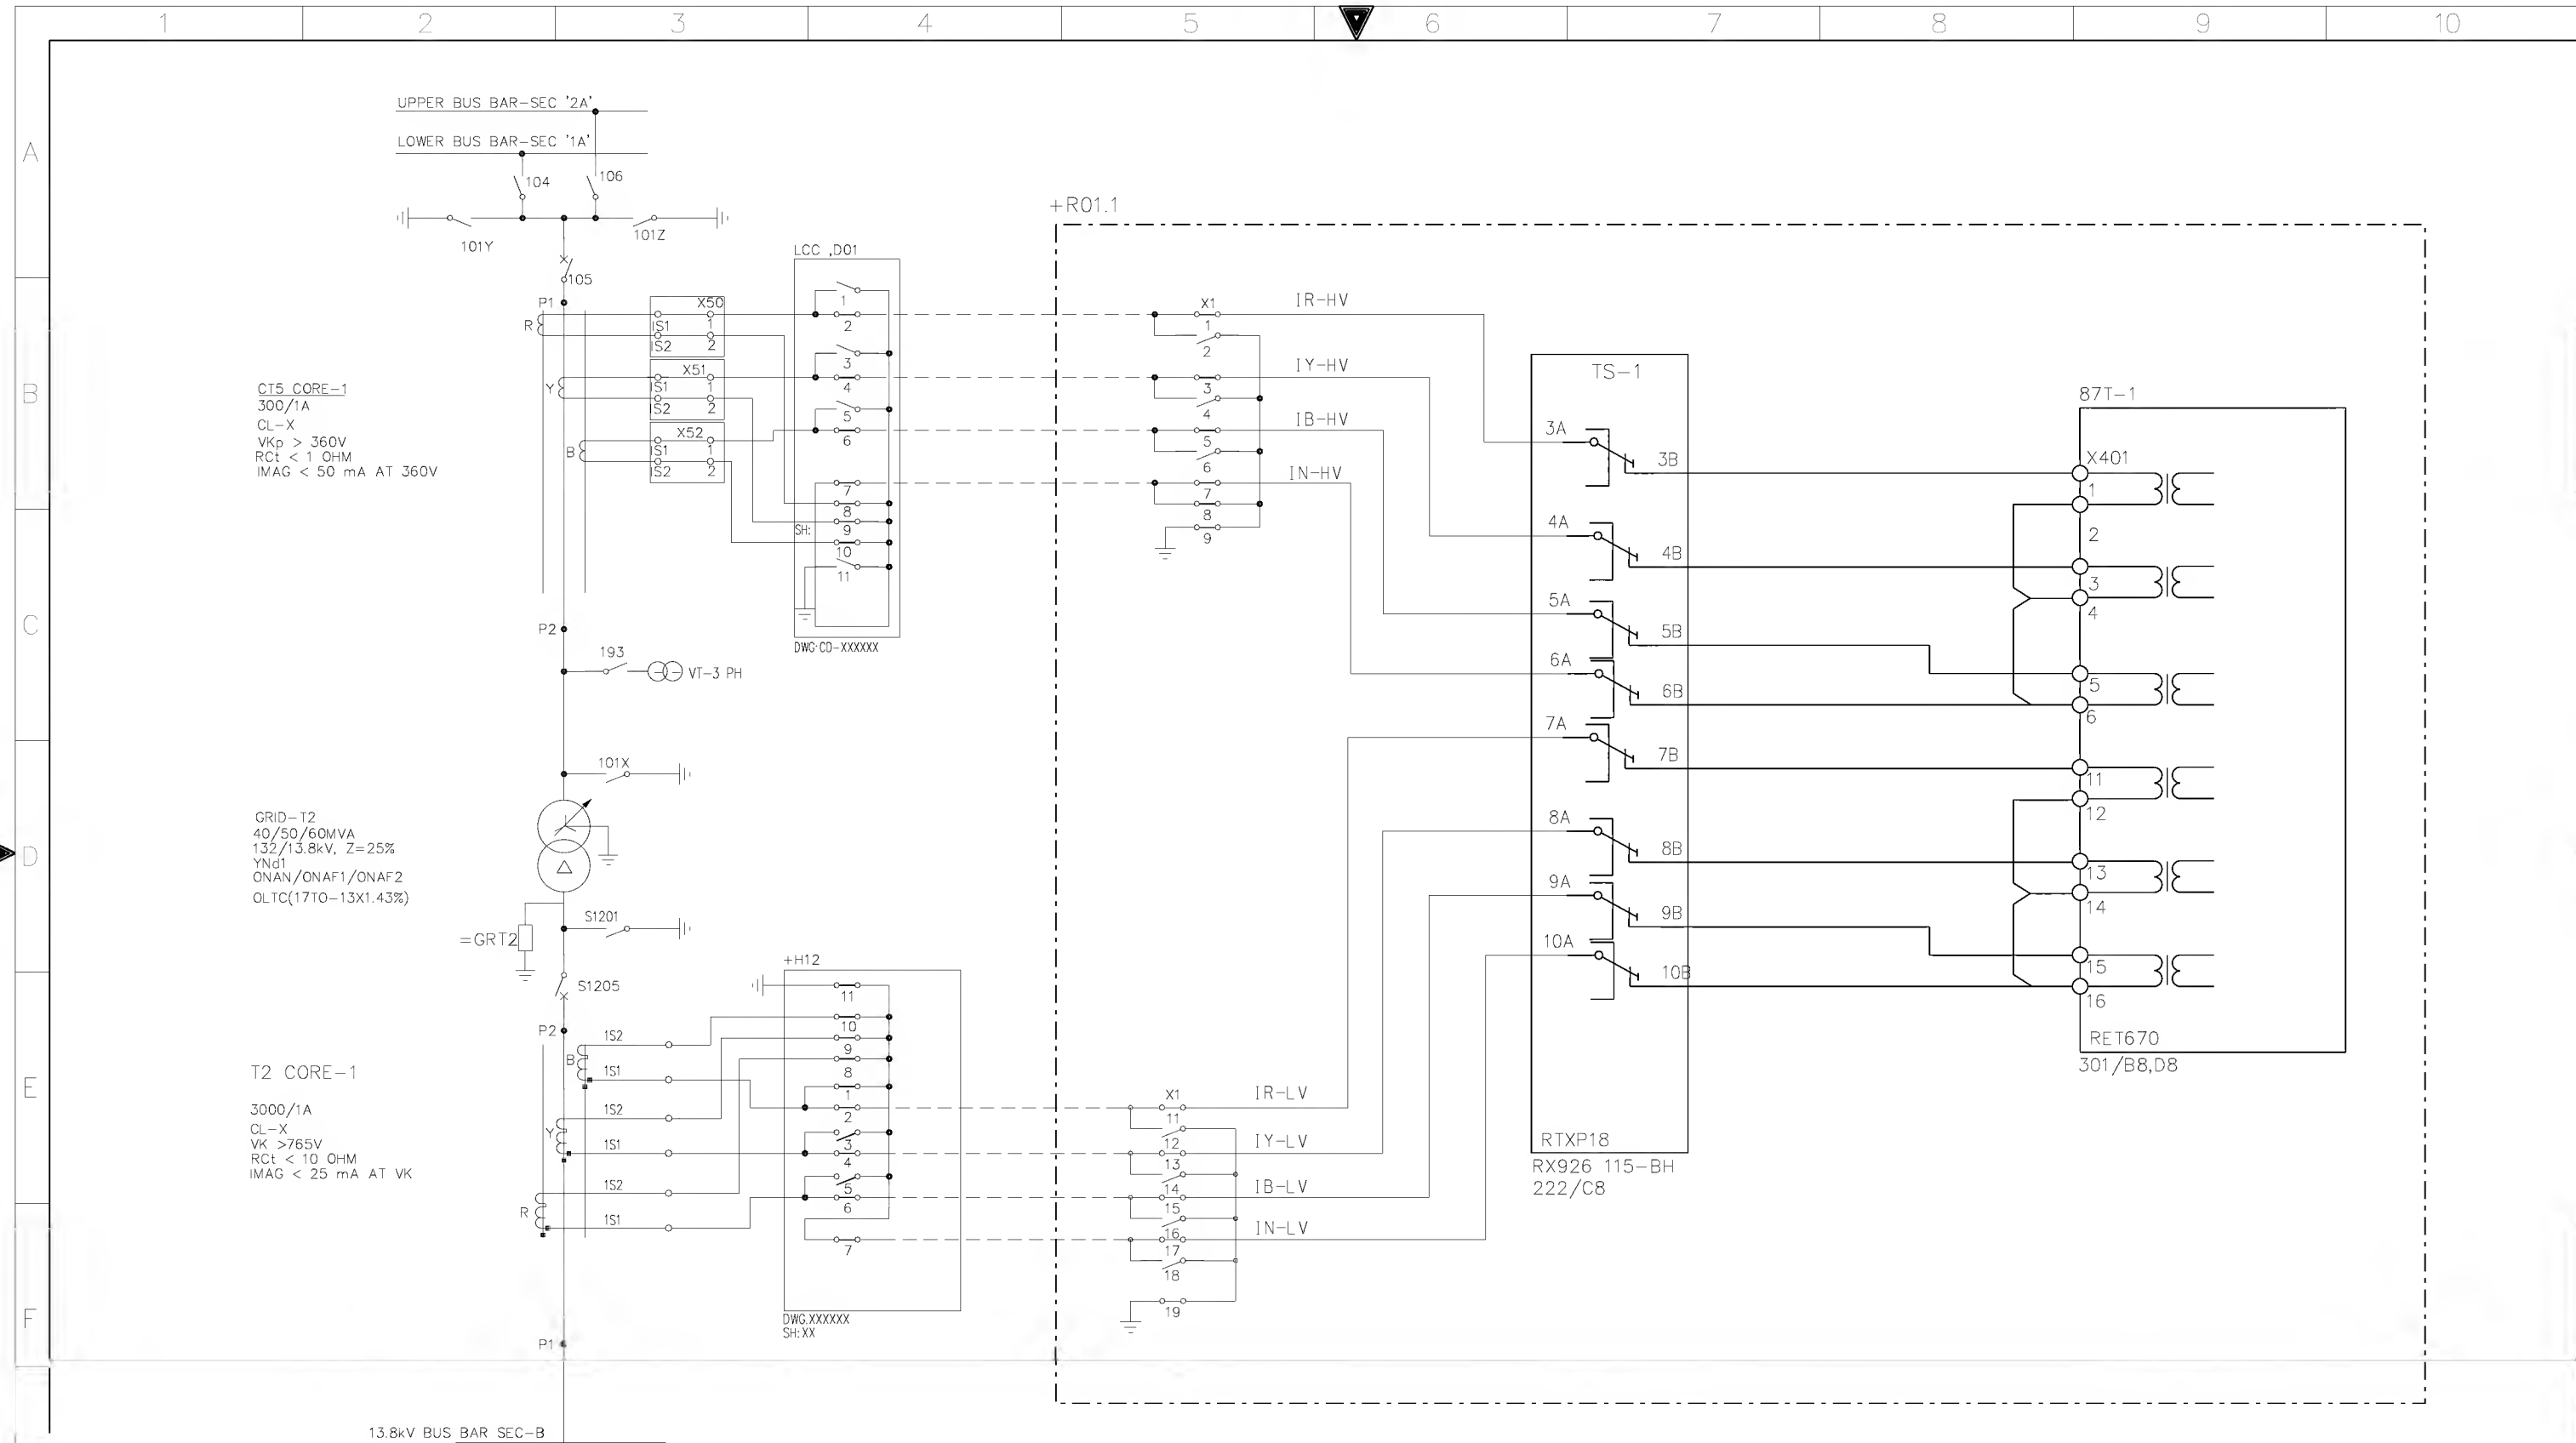

AS-BUILT BY _____ DATE _____			CONTRACT NO. 11131113/00		JOB ORDER NO. S-13656	
01	13 49	FACTORY ASBUILT	DRAWN BY RIZ		CHECKED BY JKR	
00	13 04	FOR APPROVAL	DATE STARTED 24.01.2013		DATE COMPLETED _____	
REV. NO.	DATE	DESCRIPTION	OPRG. DEPT. CTPD		ENG. DEPT. AUT-PSAC	

CT CIRCUITS 87T-1 RELAY	
132/13.8kV GT-2 RELAY PANEL-1 +R01.1	
S/S 8709-132/13.8KV IN AL-KHARJ CITY	
RIYADH	SAUDI ARABIA


الشركة الوطنية لنقل الكهرباء National Grid sa				
INDEX	PLANT NO.	DRAWING NUMBER	SHEET NO.	
-	C421	CD-322931	SHT	CONT.
-	C421	CD-322931	221	222
			REV. NO.	
			01	

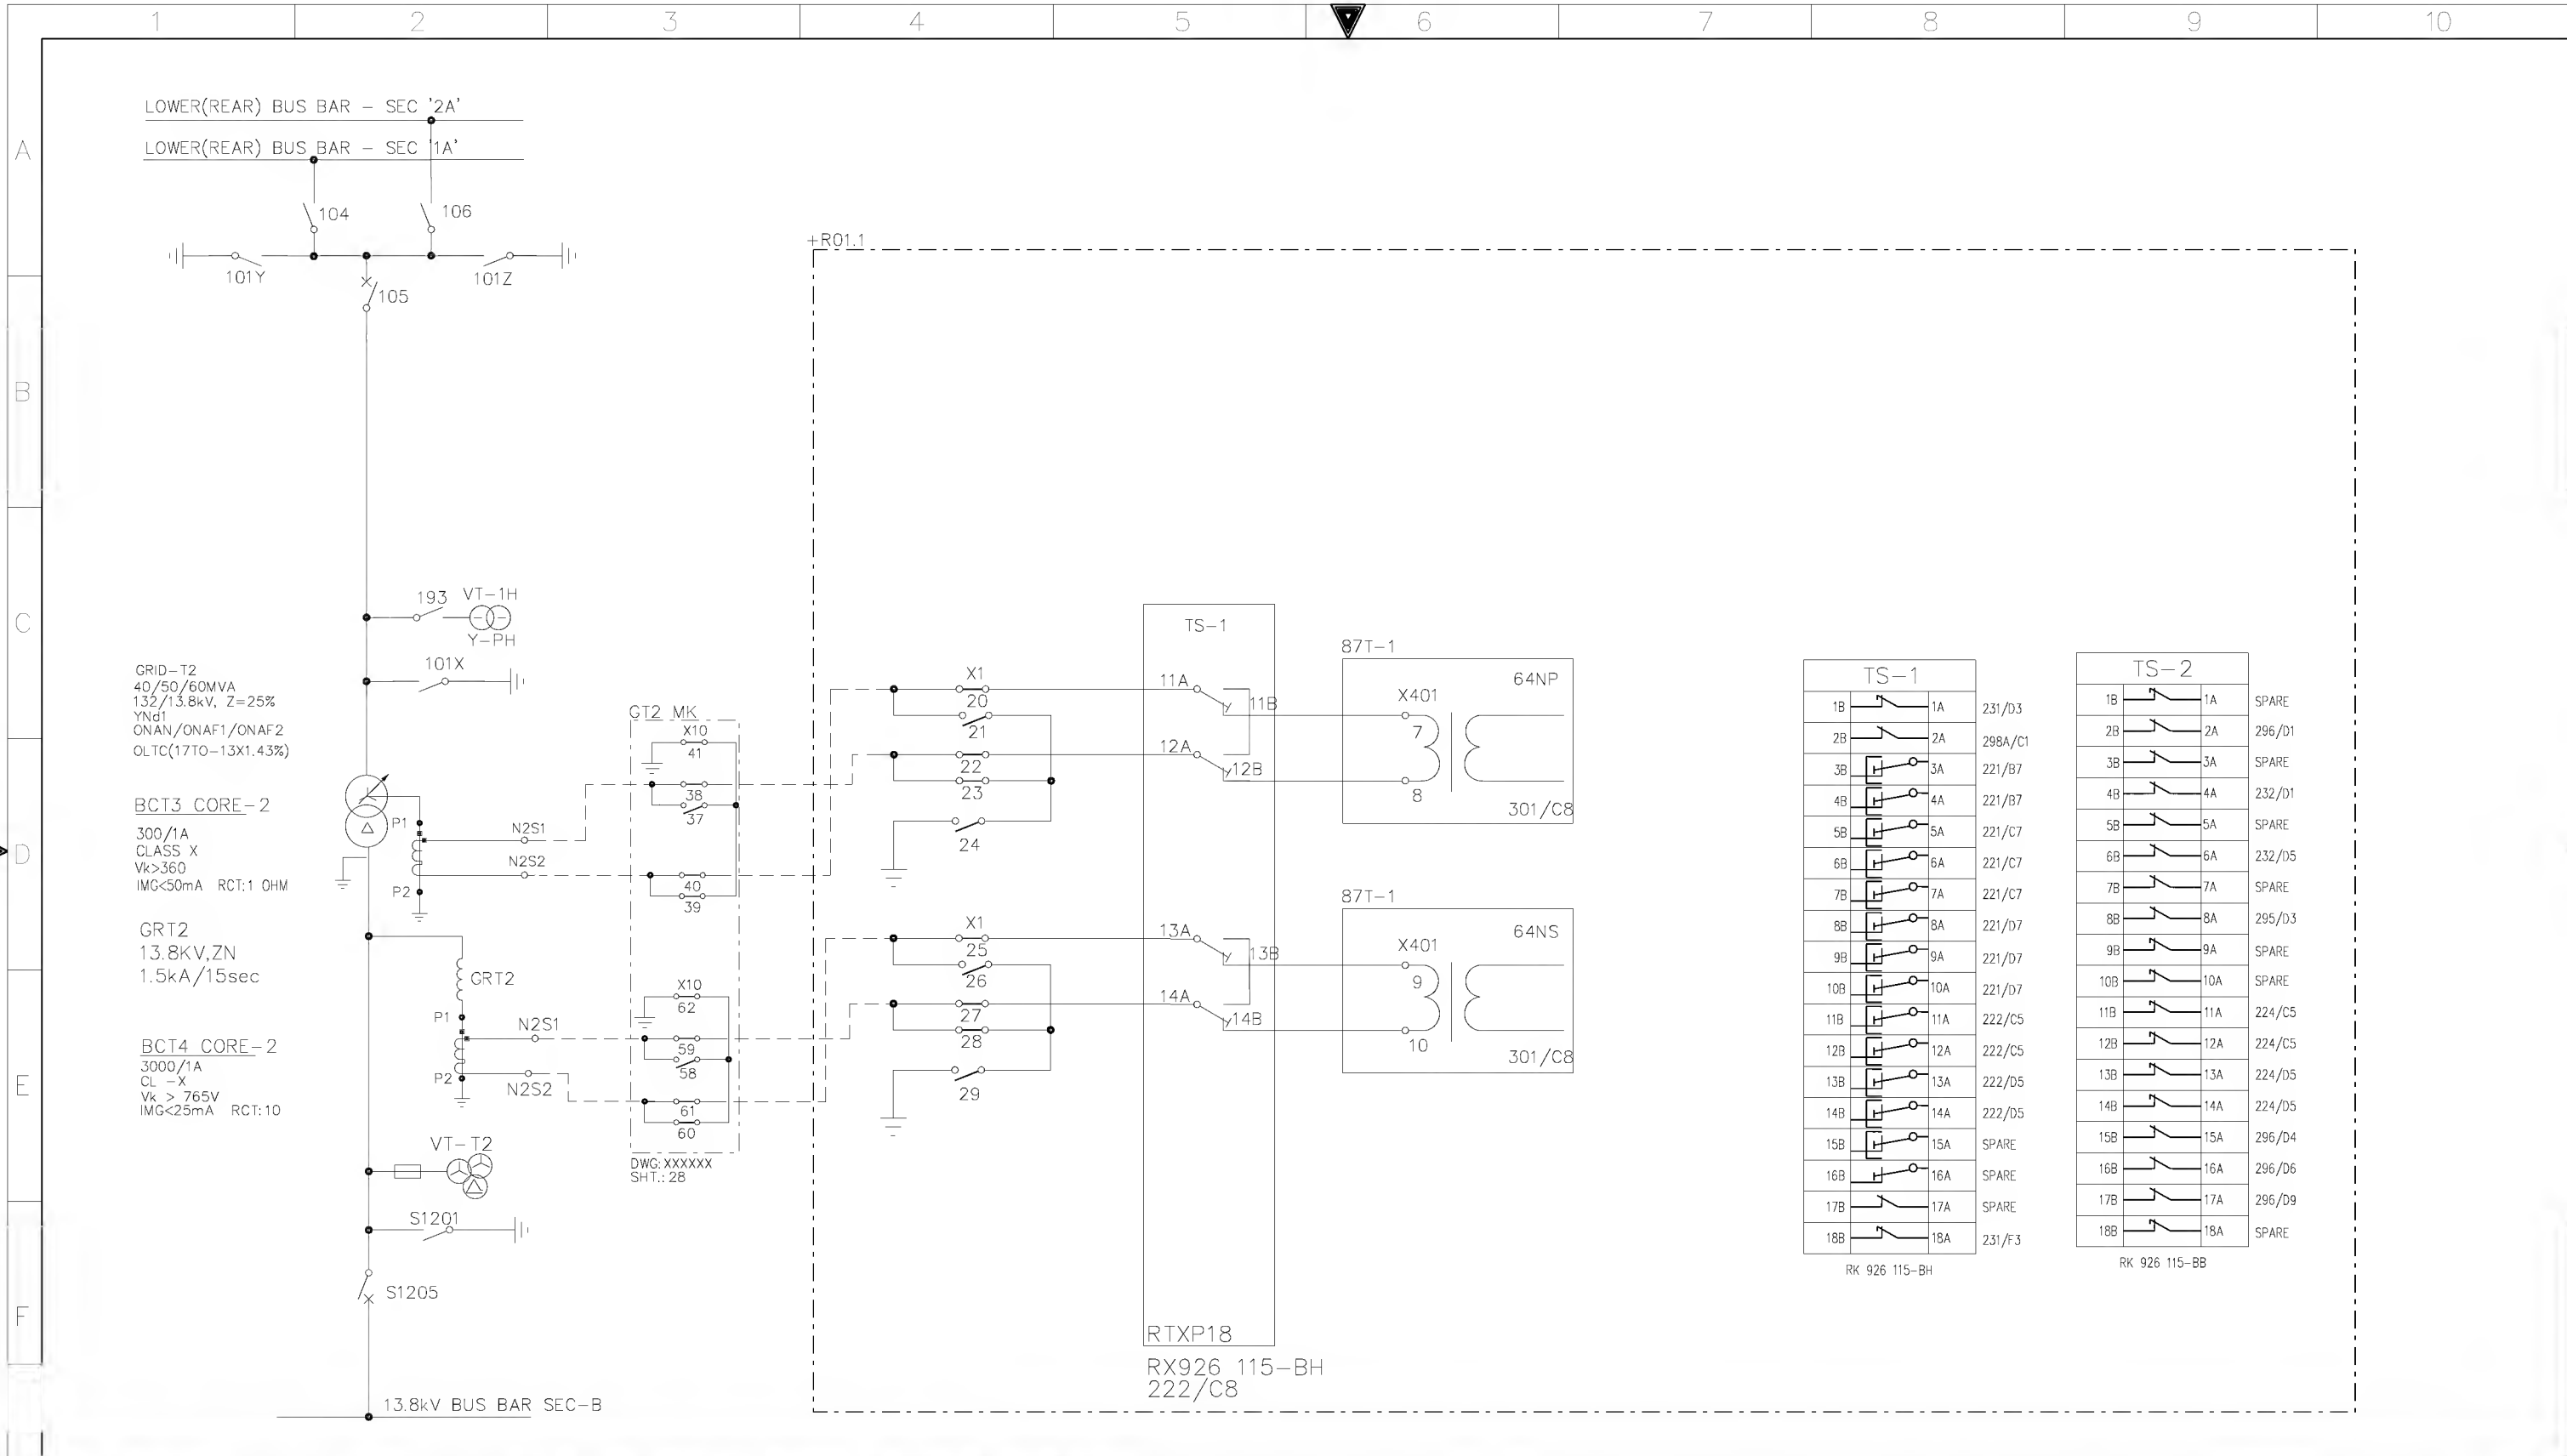


AS-BUILT BY _____ DATE _____			CONTRACT NO. 11131113/00		JOB ORDER NO. S-13656	
01	13 49	FACTORY ASBUILT	DRAWN BY RIZ		CHECKED BY JKR	
00	13 04	FOR APPROVAL	DATE STARTED 24.01.2013		DATE COMPLETED _____	
REV. NO.	DATE	DESCRIPTION	OPRG. DEPT. CTPD		ENG. DEPT. AUT-PSAC	

CT CIRCUITS 87T-1 RELAY	
132/13.8kV GT-2 RELAY PANEL-1 +R01.1	
S/S 8709-132/13.8KV IN AL-KHARJ CITY	
RIYADH	SAUDI ARABIA

الشركة الوطنية لنقل الكهرباء					نقل الكهرباء	
					National Grid sa	
INDEX	PLANT NO.	DRAWING NUMBER		SHEET NO.		REV. NO.
-	C421	CD-322931		SHT	CONT.	01
				222	223	

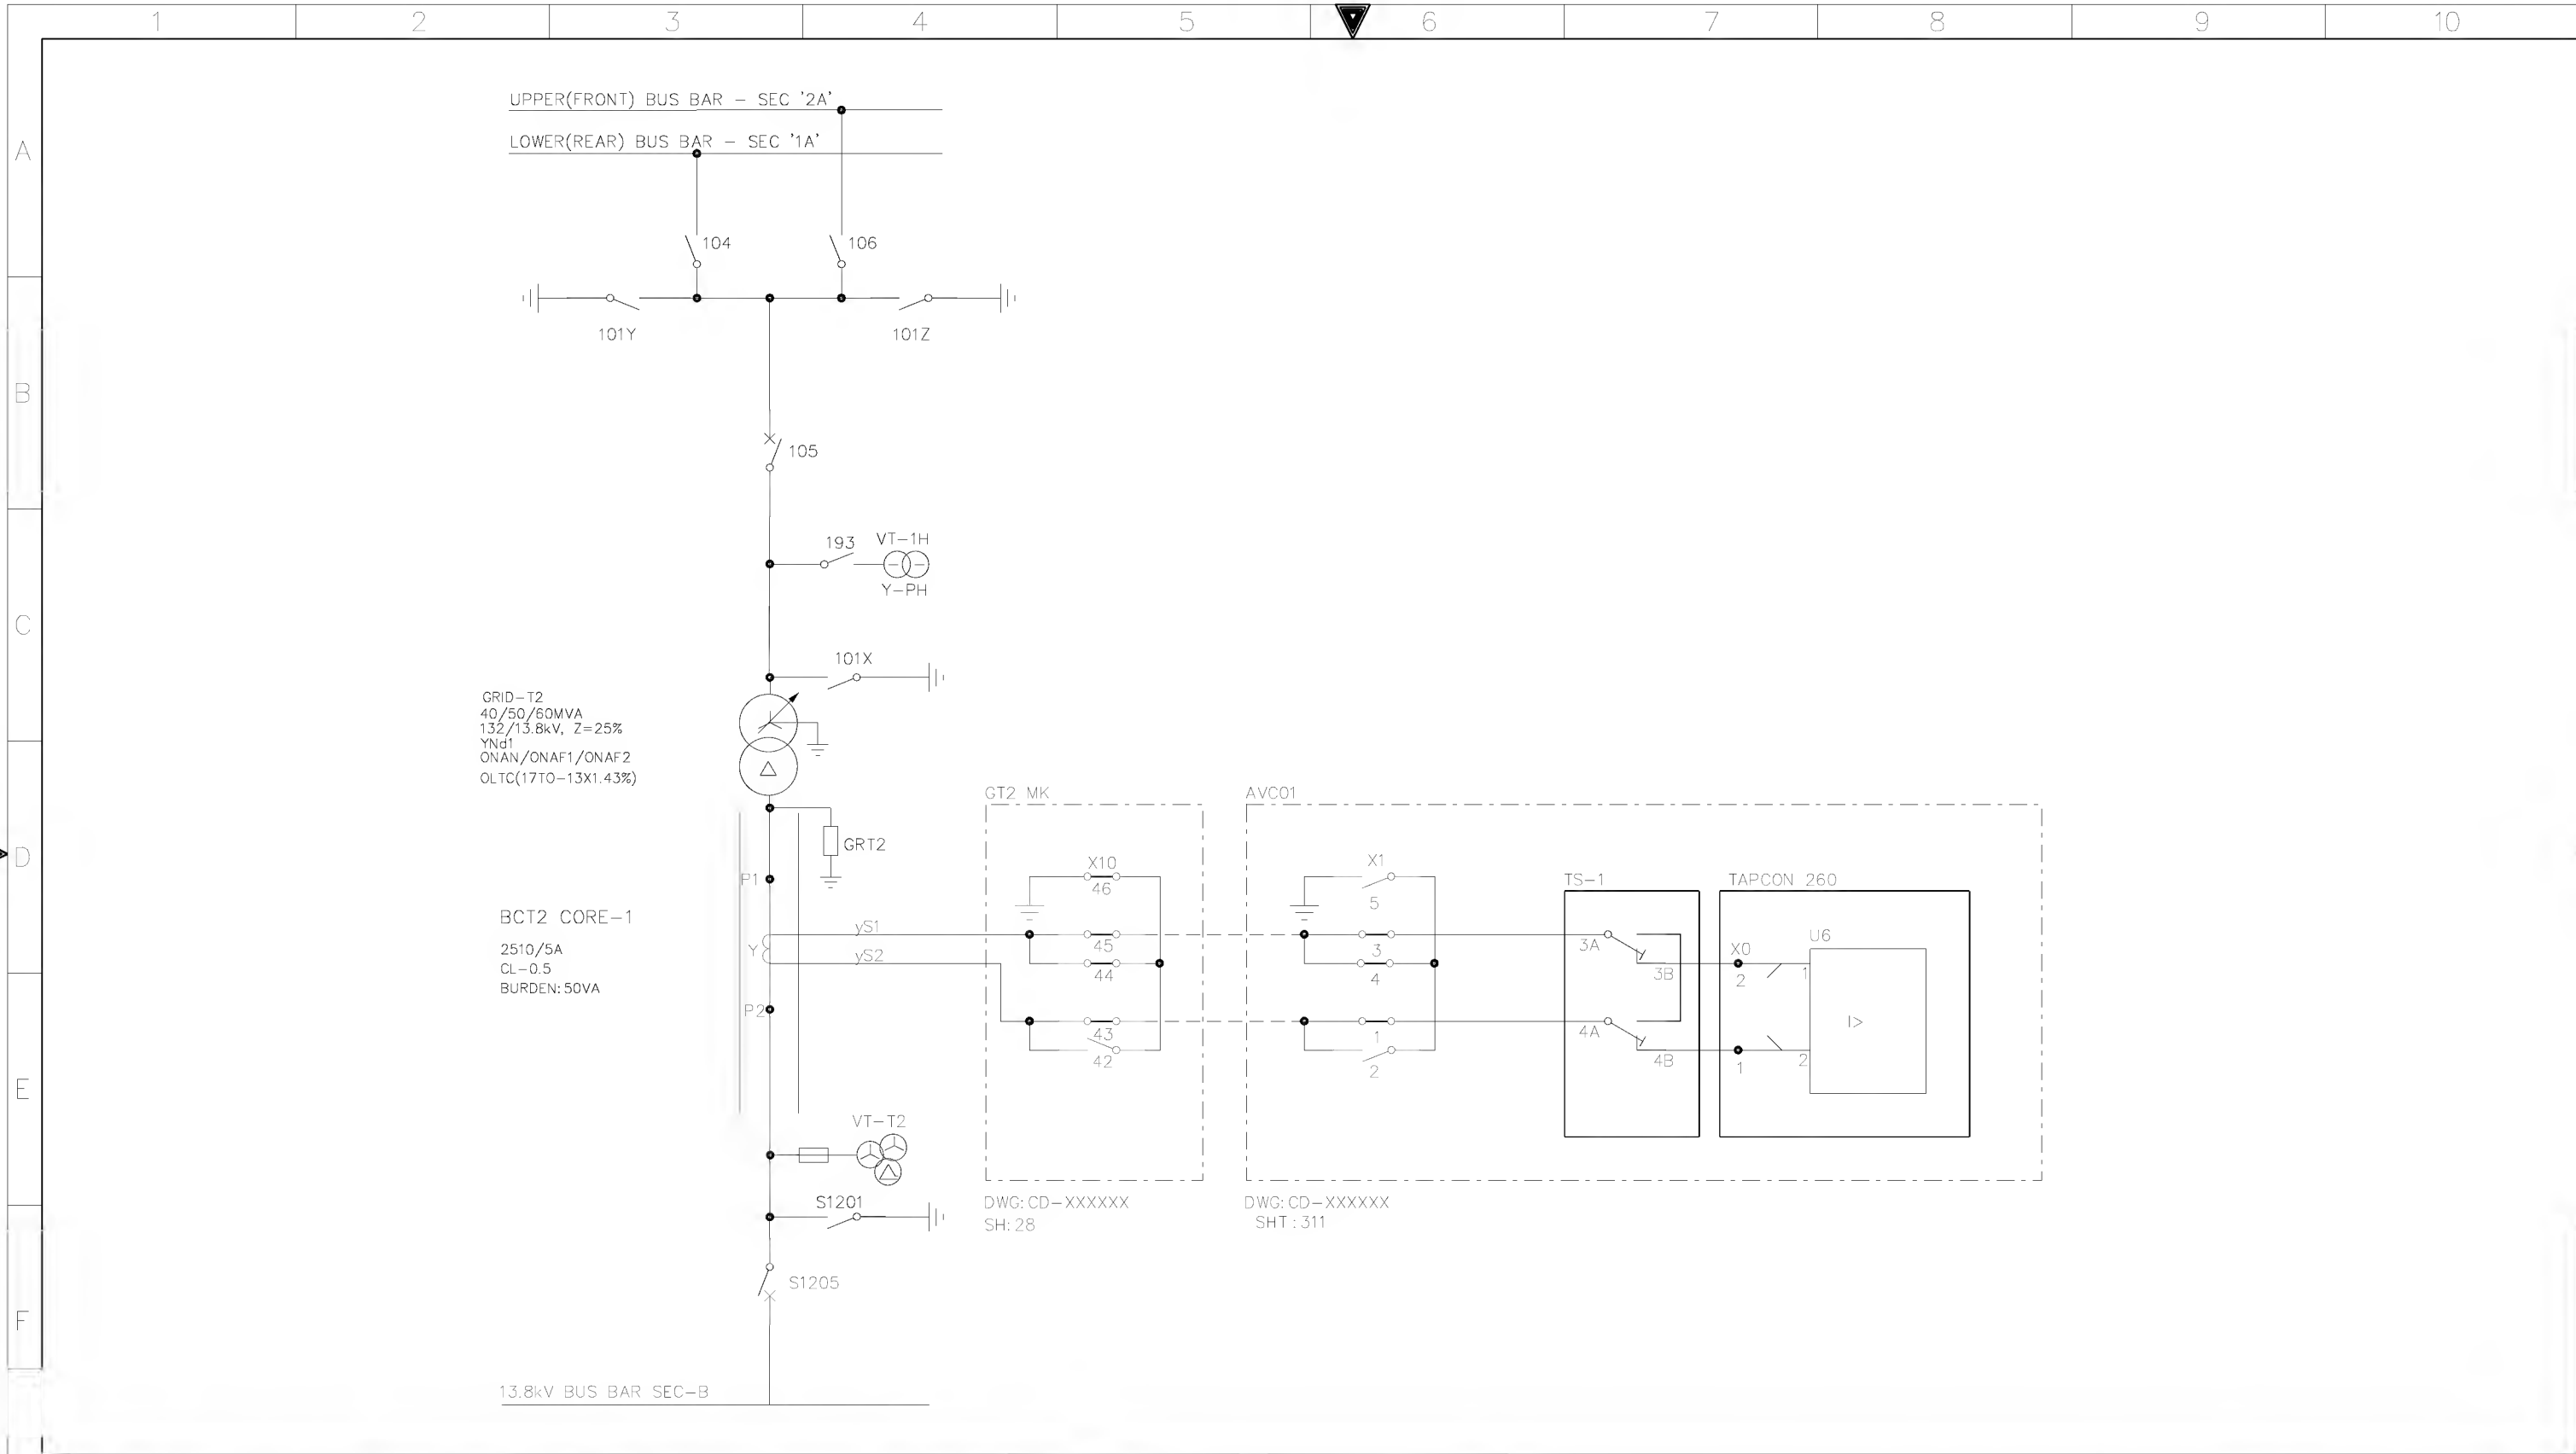

AS-BUILT BY _____ DATE _____			CONTRACT NO. 11131113/00		JOB ORDER NO. S-13656		CT CIRCUITS 87T-1 RELAY		<div>الشركة الوطنية لنقل الكهرباء</div> <div>نقل الكهرباء</div> <div>National Grid sa</div>						
			DRAWN BY RIZ		CHECKED BY JKR		132/13.8kV GT-2 RELAY PANEL-1 +R01.1								
			DATE STARTED 24.01.2013		DATE COMPLETED _____		S/S 8709-132/13.8KV IN AL-KHARJ CITY								
01 13 49			FACTORY ASBUILT				S/S 8709-132/13.8KV IN AL-KHARJ CITY		INDEX	PLANT NO.	DRAWING NUMBER		SHEET NO.		REV. NO.
00 13 04			FOR APPROVAL		OPRG. DEPT. CTPD		ENG. DEPT. AUT-PSAC		-	C421	CD-322931		SHT 223	CONT. 224	01
REV. NO.			DATE		DESCRIPTION		RIYADH SAUDI ARABIA								

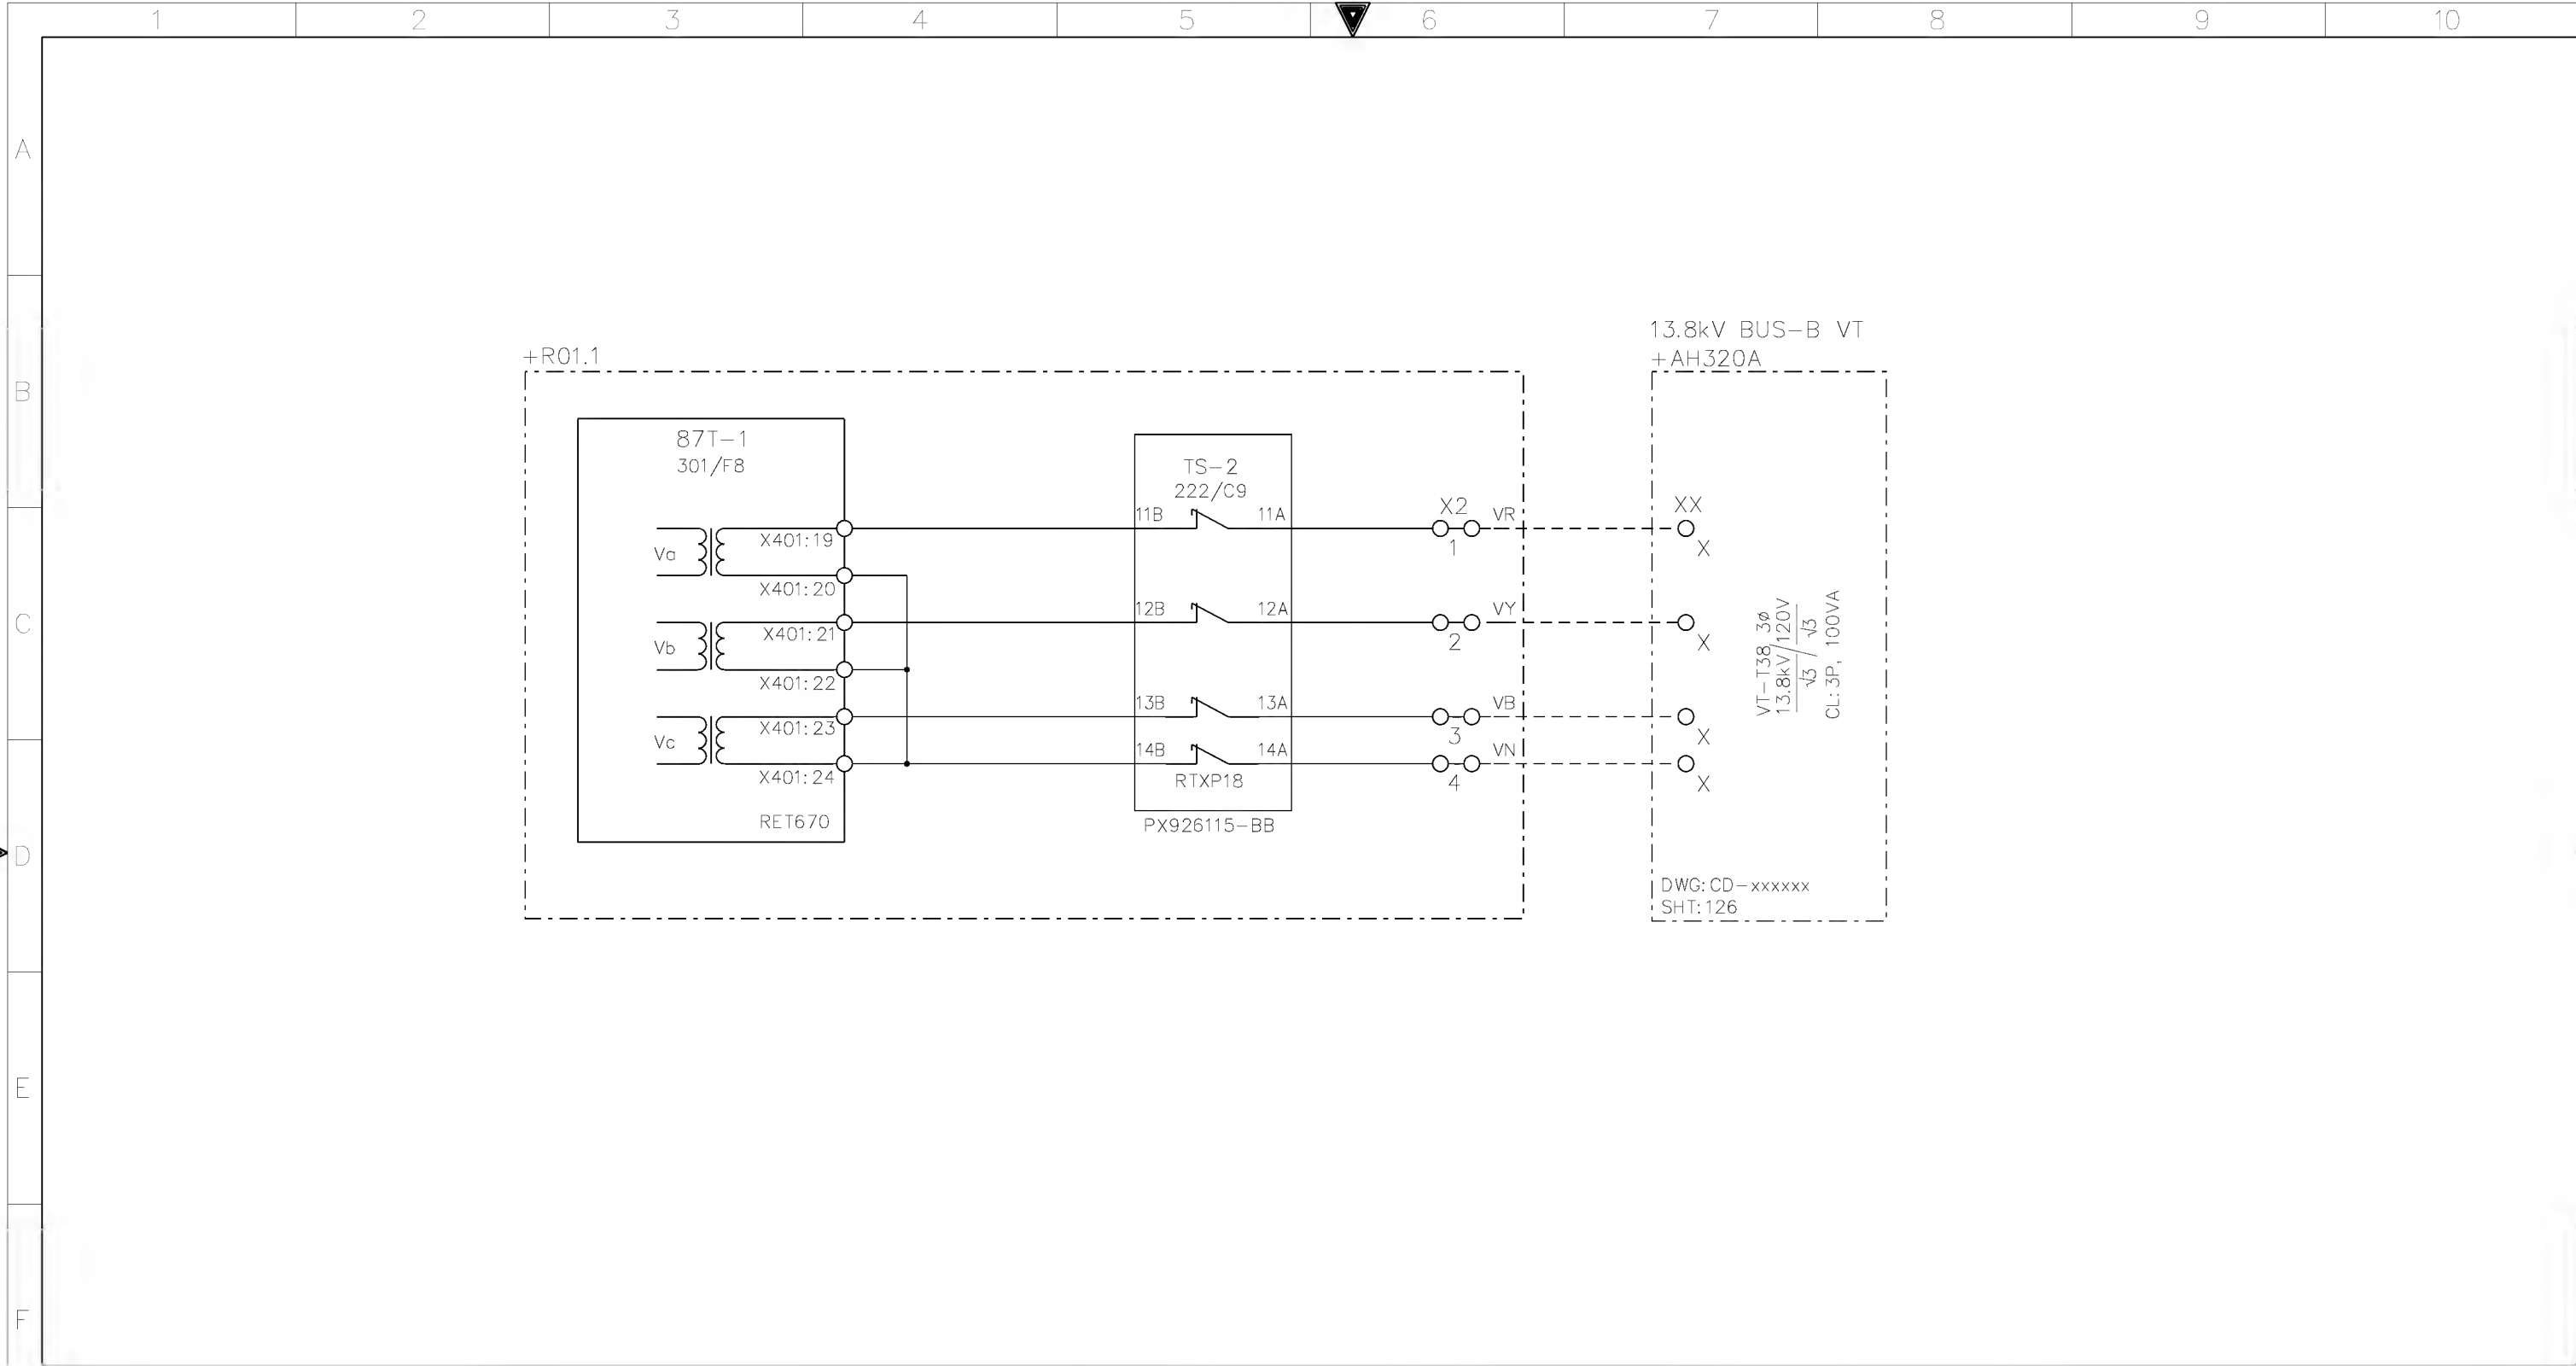


AS-BUILT BY _____ DATE _____ CONTRACT NO. 11131113/00 JOB ORDER NO. S-13656

01	13 49	FACTORY ASBUILT	DRAWN BY RIZ CHECKED BY JKR
00	13 04	FOR APPROVAL	DATE STARTED 24.01.2013 DATE COMPLETED _____
REV. NO.	DATE	DESCRIPTION	OPRG. DEPT. CTPD ENG. DEPT. AUT-PSAC

VT CIRCUITS 87T-1 RELAY
132/13.8kV GT-2 RELAY PANEL-1 +R01.1
S/S 8709-132/13.8KV IN AL-KHARJ CITY
RIYADH SAUDI ARABIA

الشركة الوطنية لنقل الكهرباء				نقل الكهرباء			
				National Grid sa			
INDEX	PLANT NO.	DRAWING NUMBER		SHEET NO.			
	C421	CD-322931		SHT	CONT.		
				224	227		
				REV. NO.			
				01			






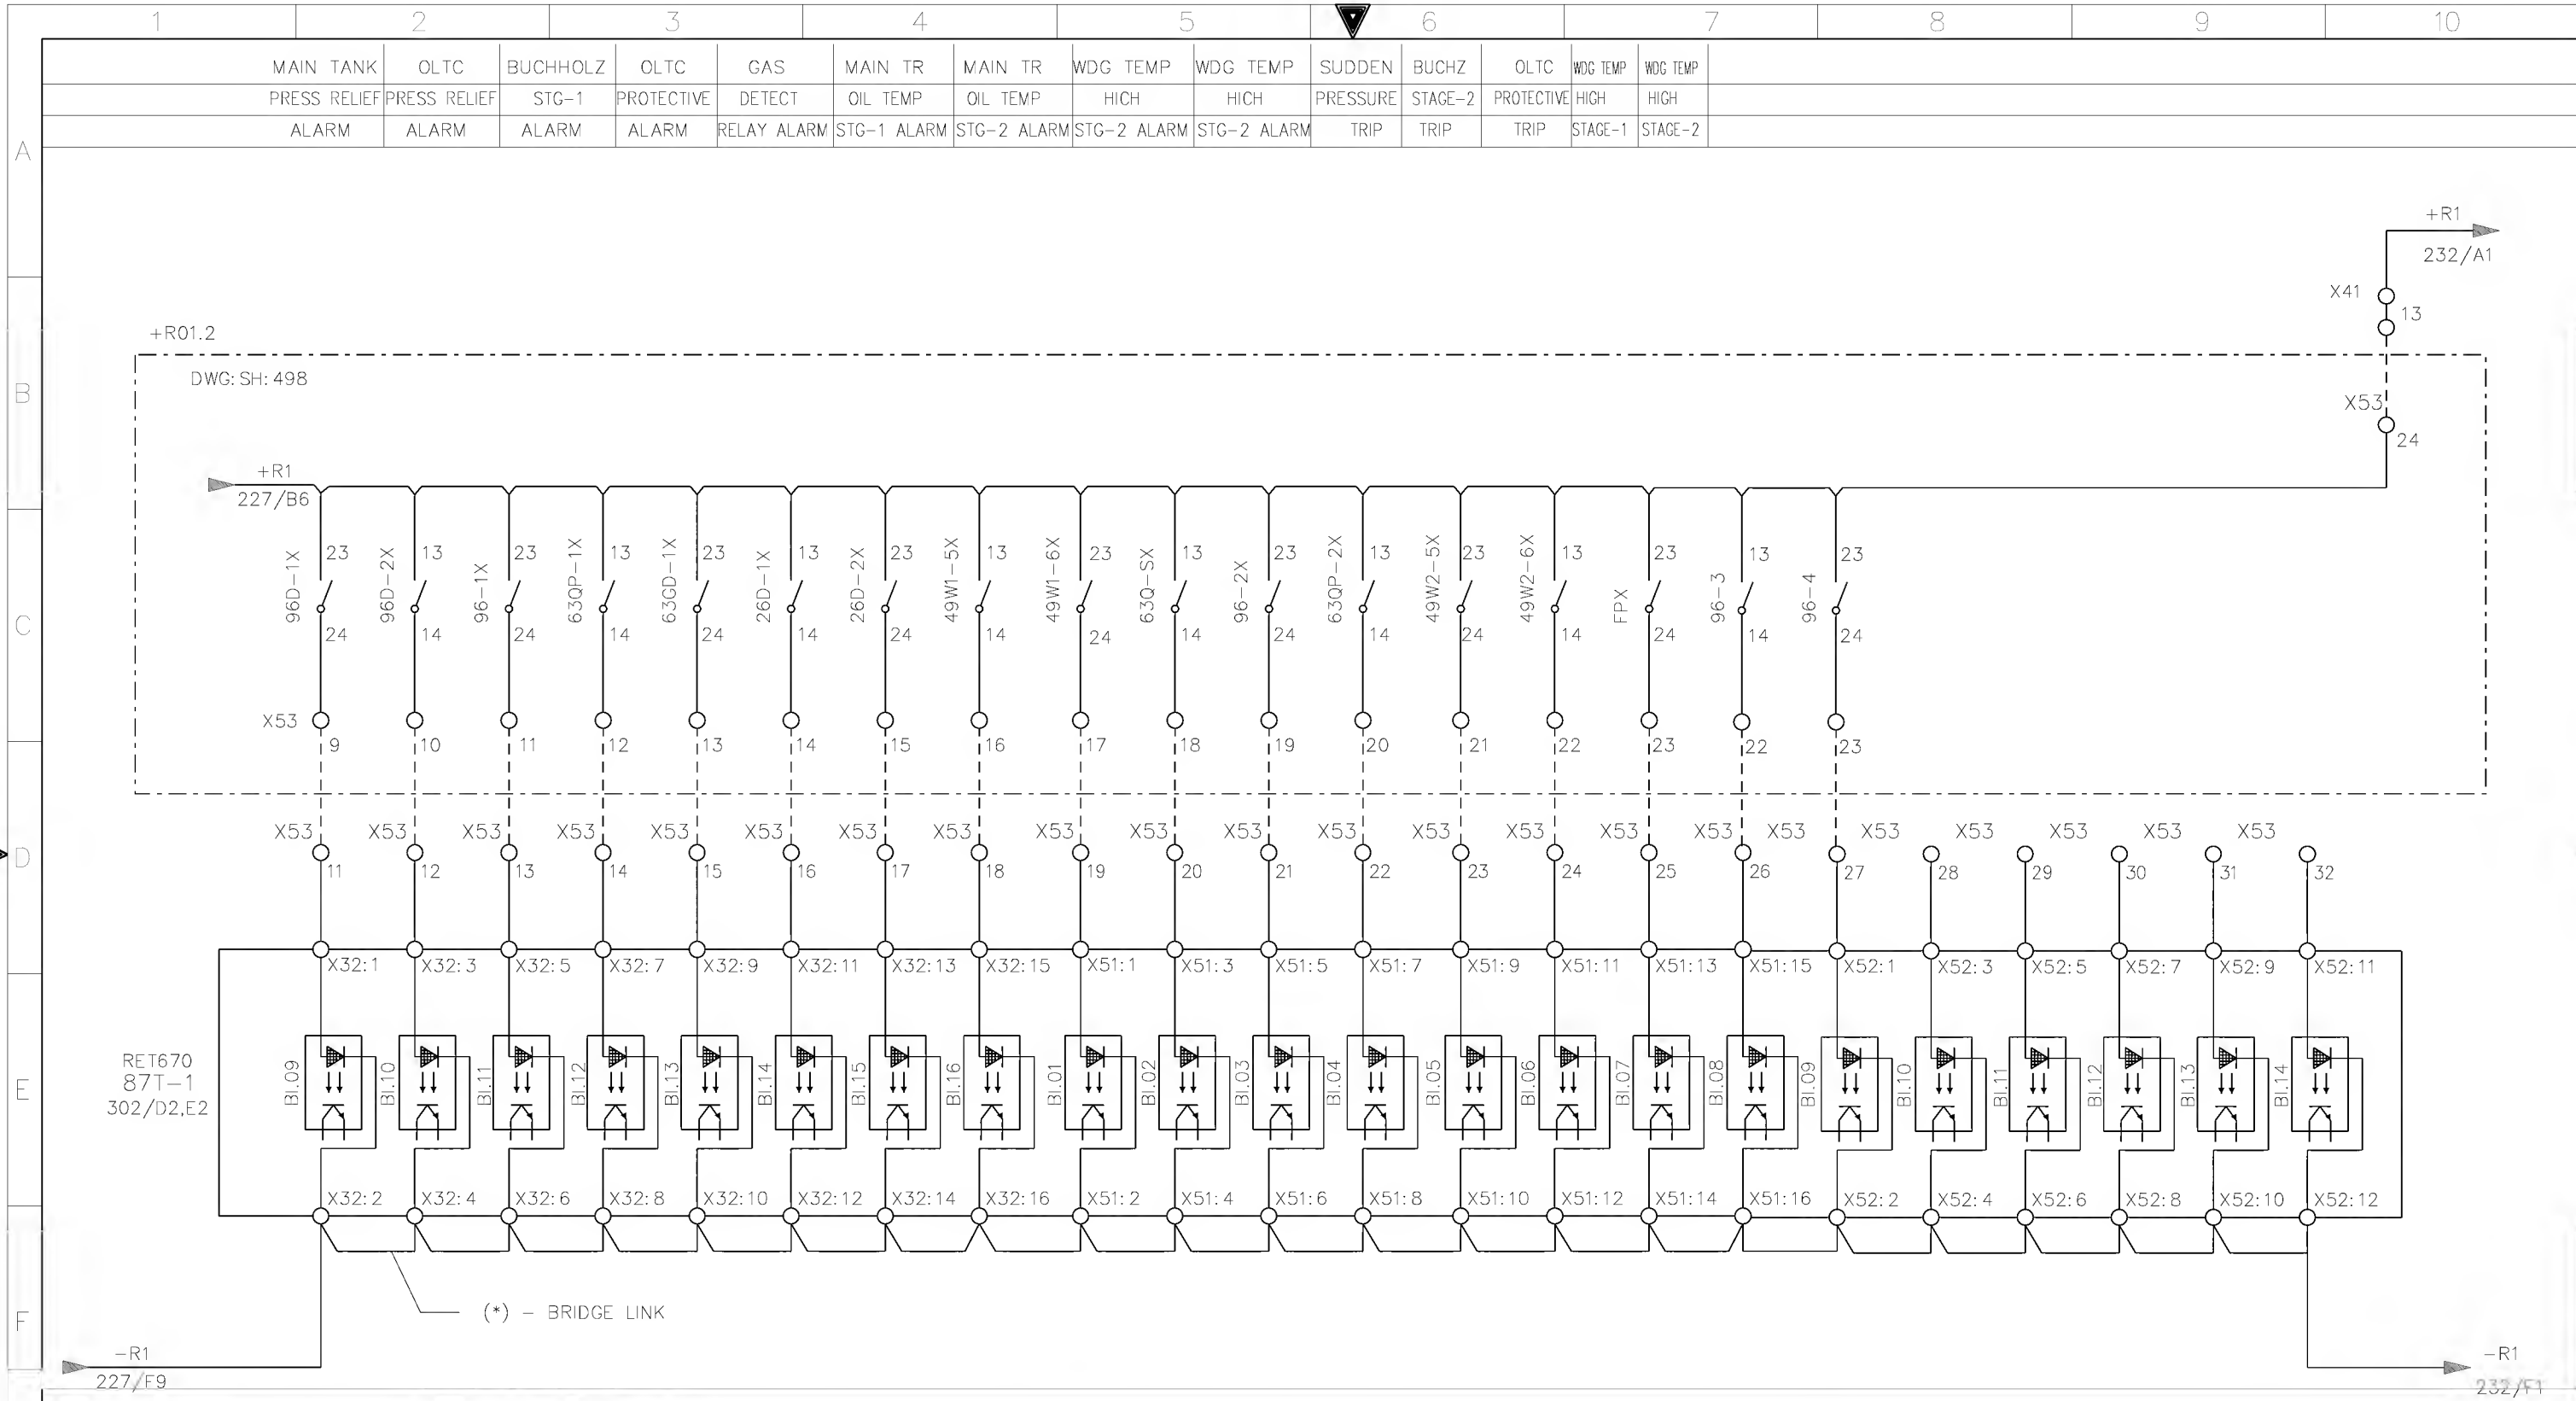



AS-BUILT BY _____ DATE _____ CONTRACT NO. 11131113/00 JOB ORDER NO. S-13656


01	13 49	FACTORY ASBUILT	DRAWN BY RIZ	CHECKED BY JKR
00	13 04	FOR APPROVAL	DATE STARTED 24.01.2013	DATE COMPLETED
REV. NO.	DATE	DESCRIPTION	OPRG. DEPT. CTPD	ENG. DEPT. AUT-PSAC

87T-1 BINARY INPUTS
132/13.8kV GT-2 RELAY PANEL-1 +R01.1
S/S 8709-132/13.8KV IN AL-KHARJ CITY
RIYADH SAUDI ARABIA

الشركة الوطنية لنقل الكهرباء National Grid sa				
INDEX	PLANT NO.	DRAWING NUMBER	SHEET NO.	REV. NO.
-	C421	CD-322931	SHT 228	CONT. 232
			01	

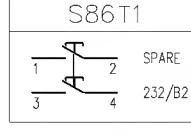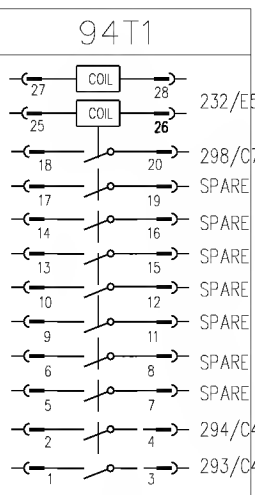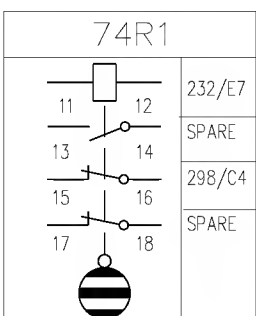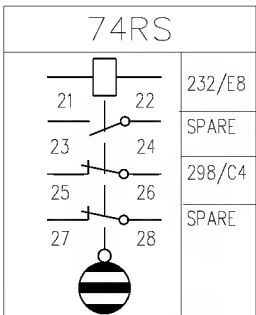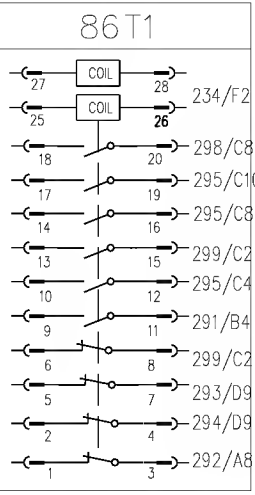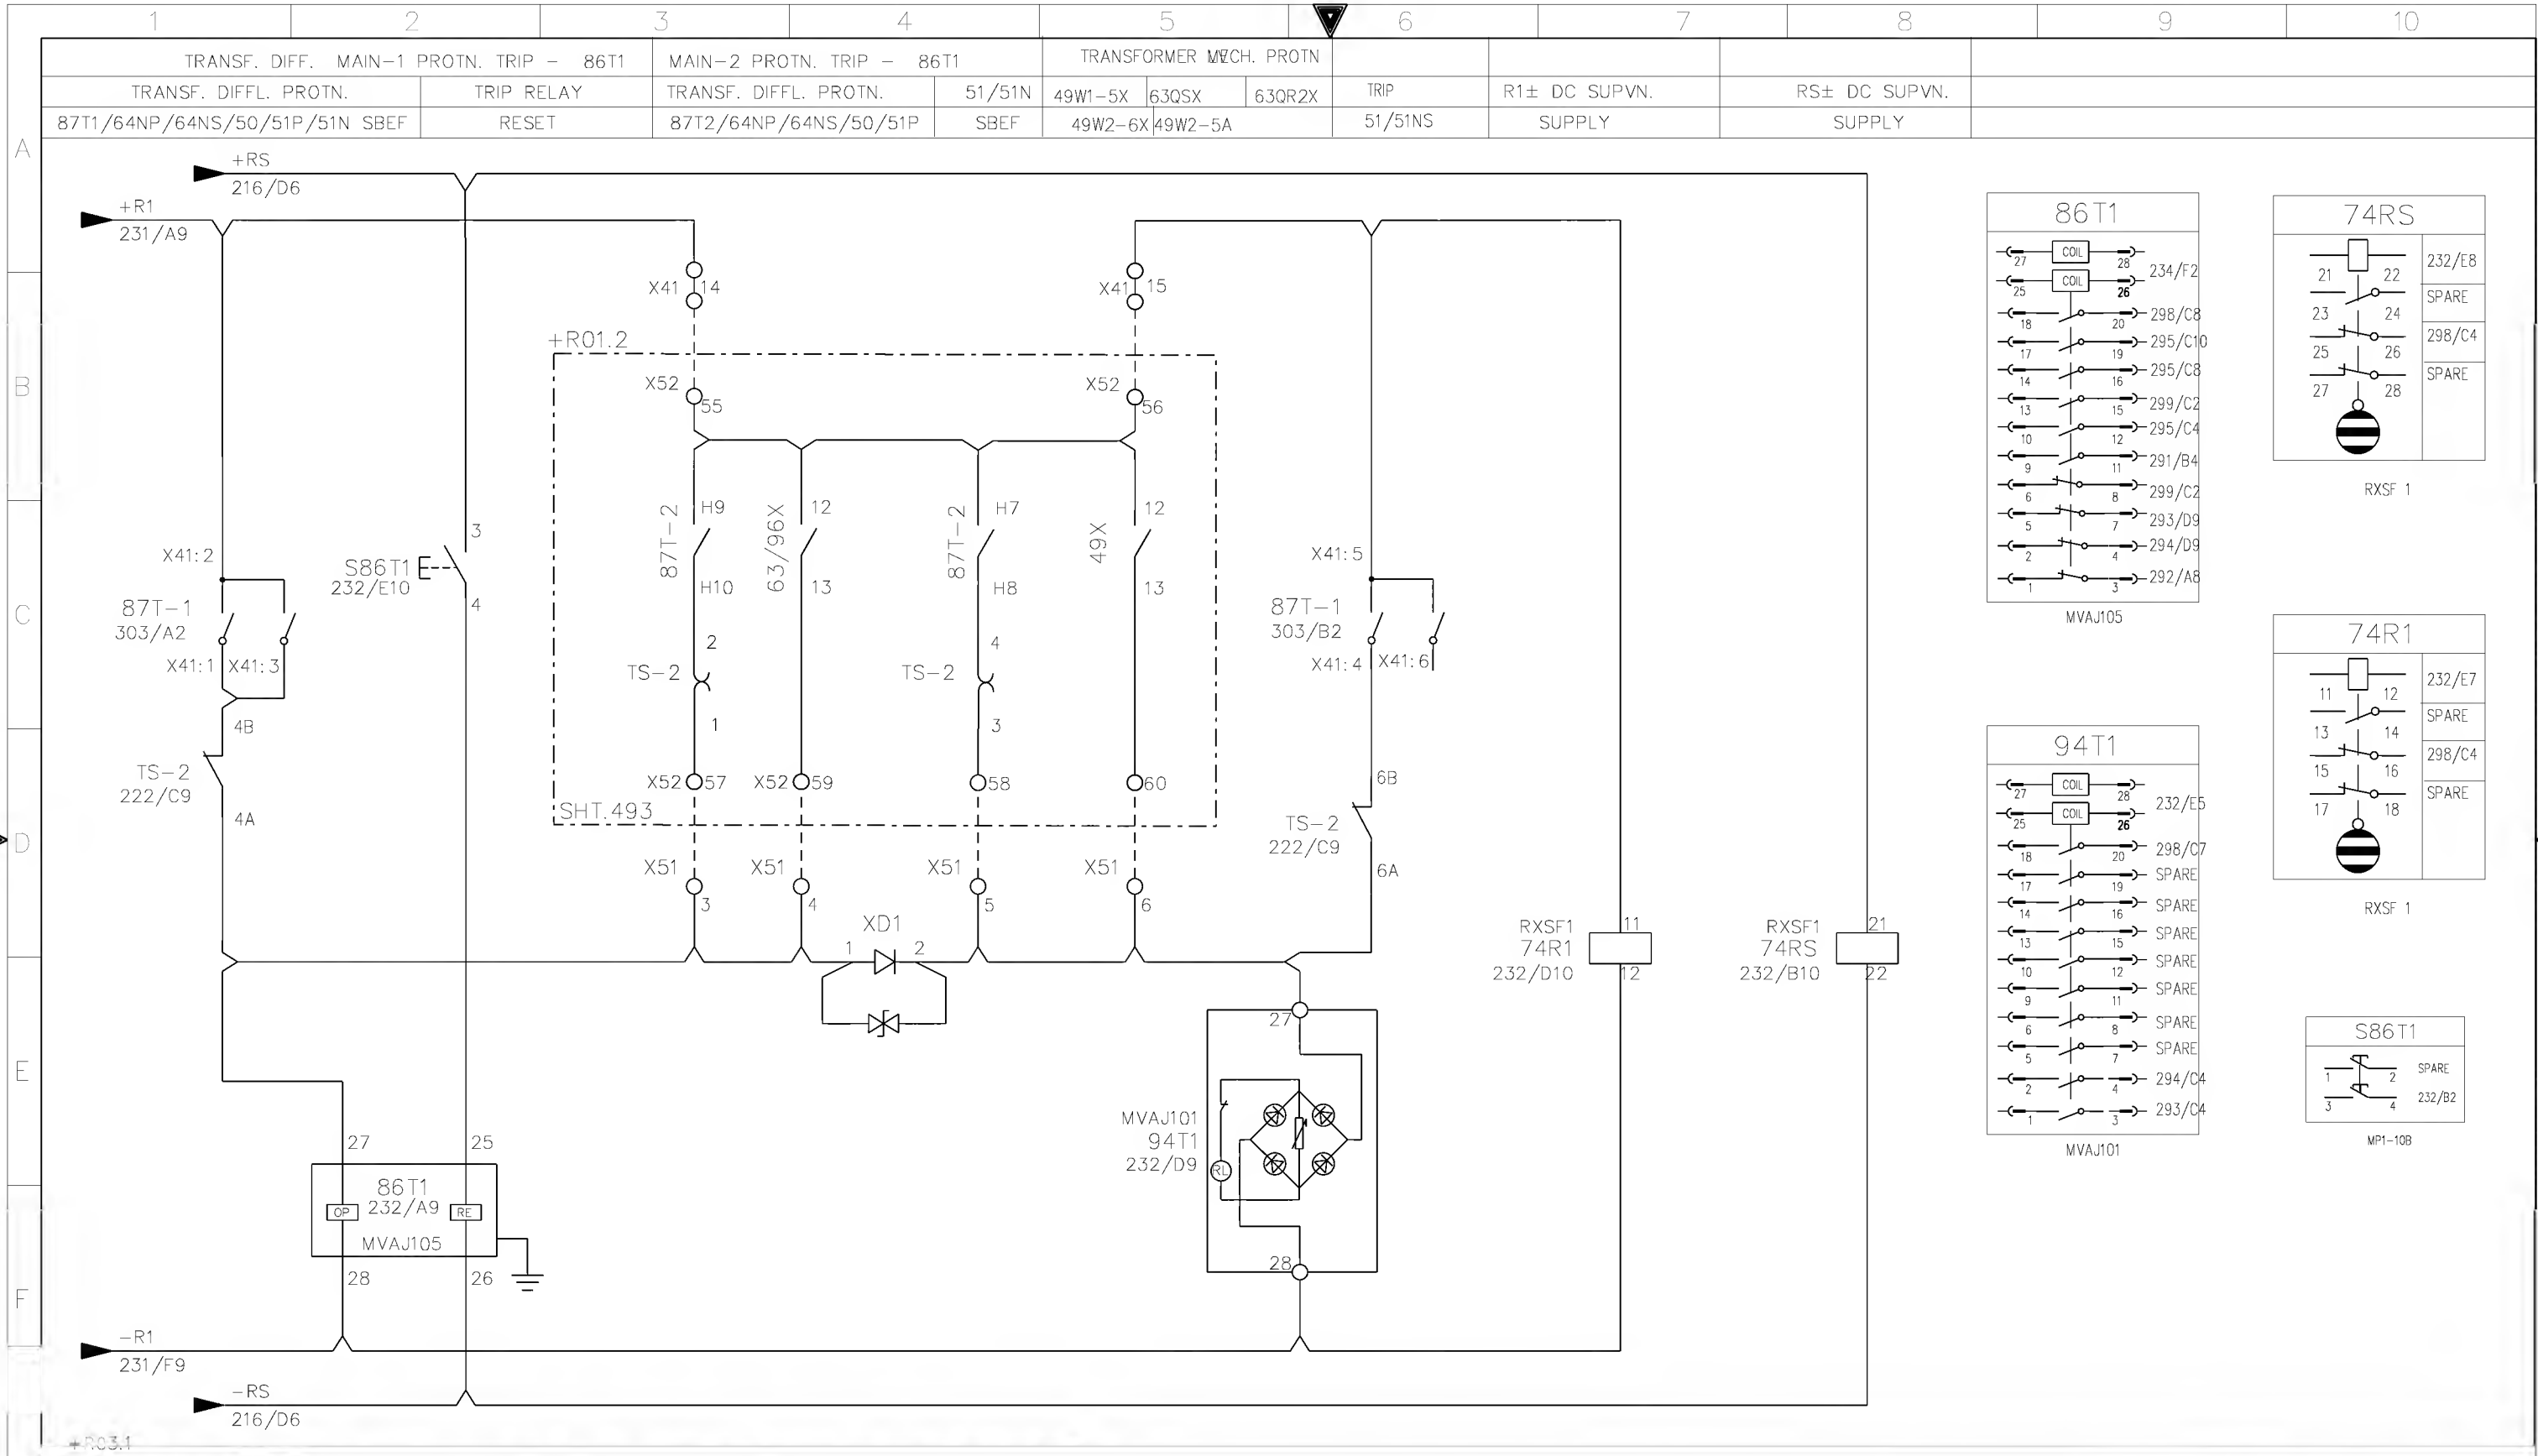


AS-BUILT BY _____ DATE _____			CONTRACT NO. 11131113/00		JOB ORDER NO. S-13656		MAIN-1 TRANSF DIFFL PROT TRIP RELAY CIRCUIT			<div>الشركة الوطنية لنقل الكهرباء</div> <div>نقل الكهرباء</div> <div>National Grid sa</div>	
			DRAWN BY <u>RIZ</u> CHECKED BY <u>JKR</u>		DATE STARTED <u>24.01.2013</u> DATE COMPLETED _____		132/13.8kV GT-2 RELAY PANEL-1 +R01.1				
01 13 49 FACTORY ASBUILT			DATE STARTED <u>24.01.2013</u> DATE COMPLETED _____		OPRG. DEPT. <u>CTPD</u> ENG. DEPT. <u>AUT-PSAC</u>		S/S 8709-132/13.8KV IN AL-KHARJ CITY			INDEX PLANT NO. DRAWING NUMBER SHEET NO. REV. NO.	
00 13 04 FOR APPROVAL							RIYADH SAUDI ARABIA			- C421 CD-322931	
REV. NO. DATE DESCRIPTION										232 276 01	

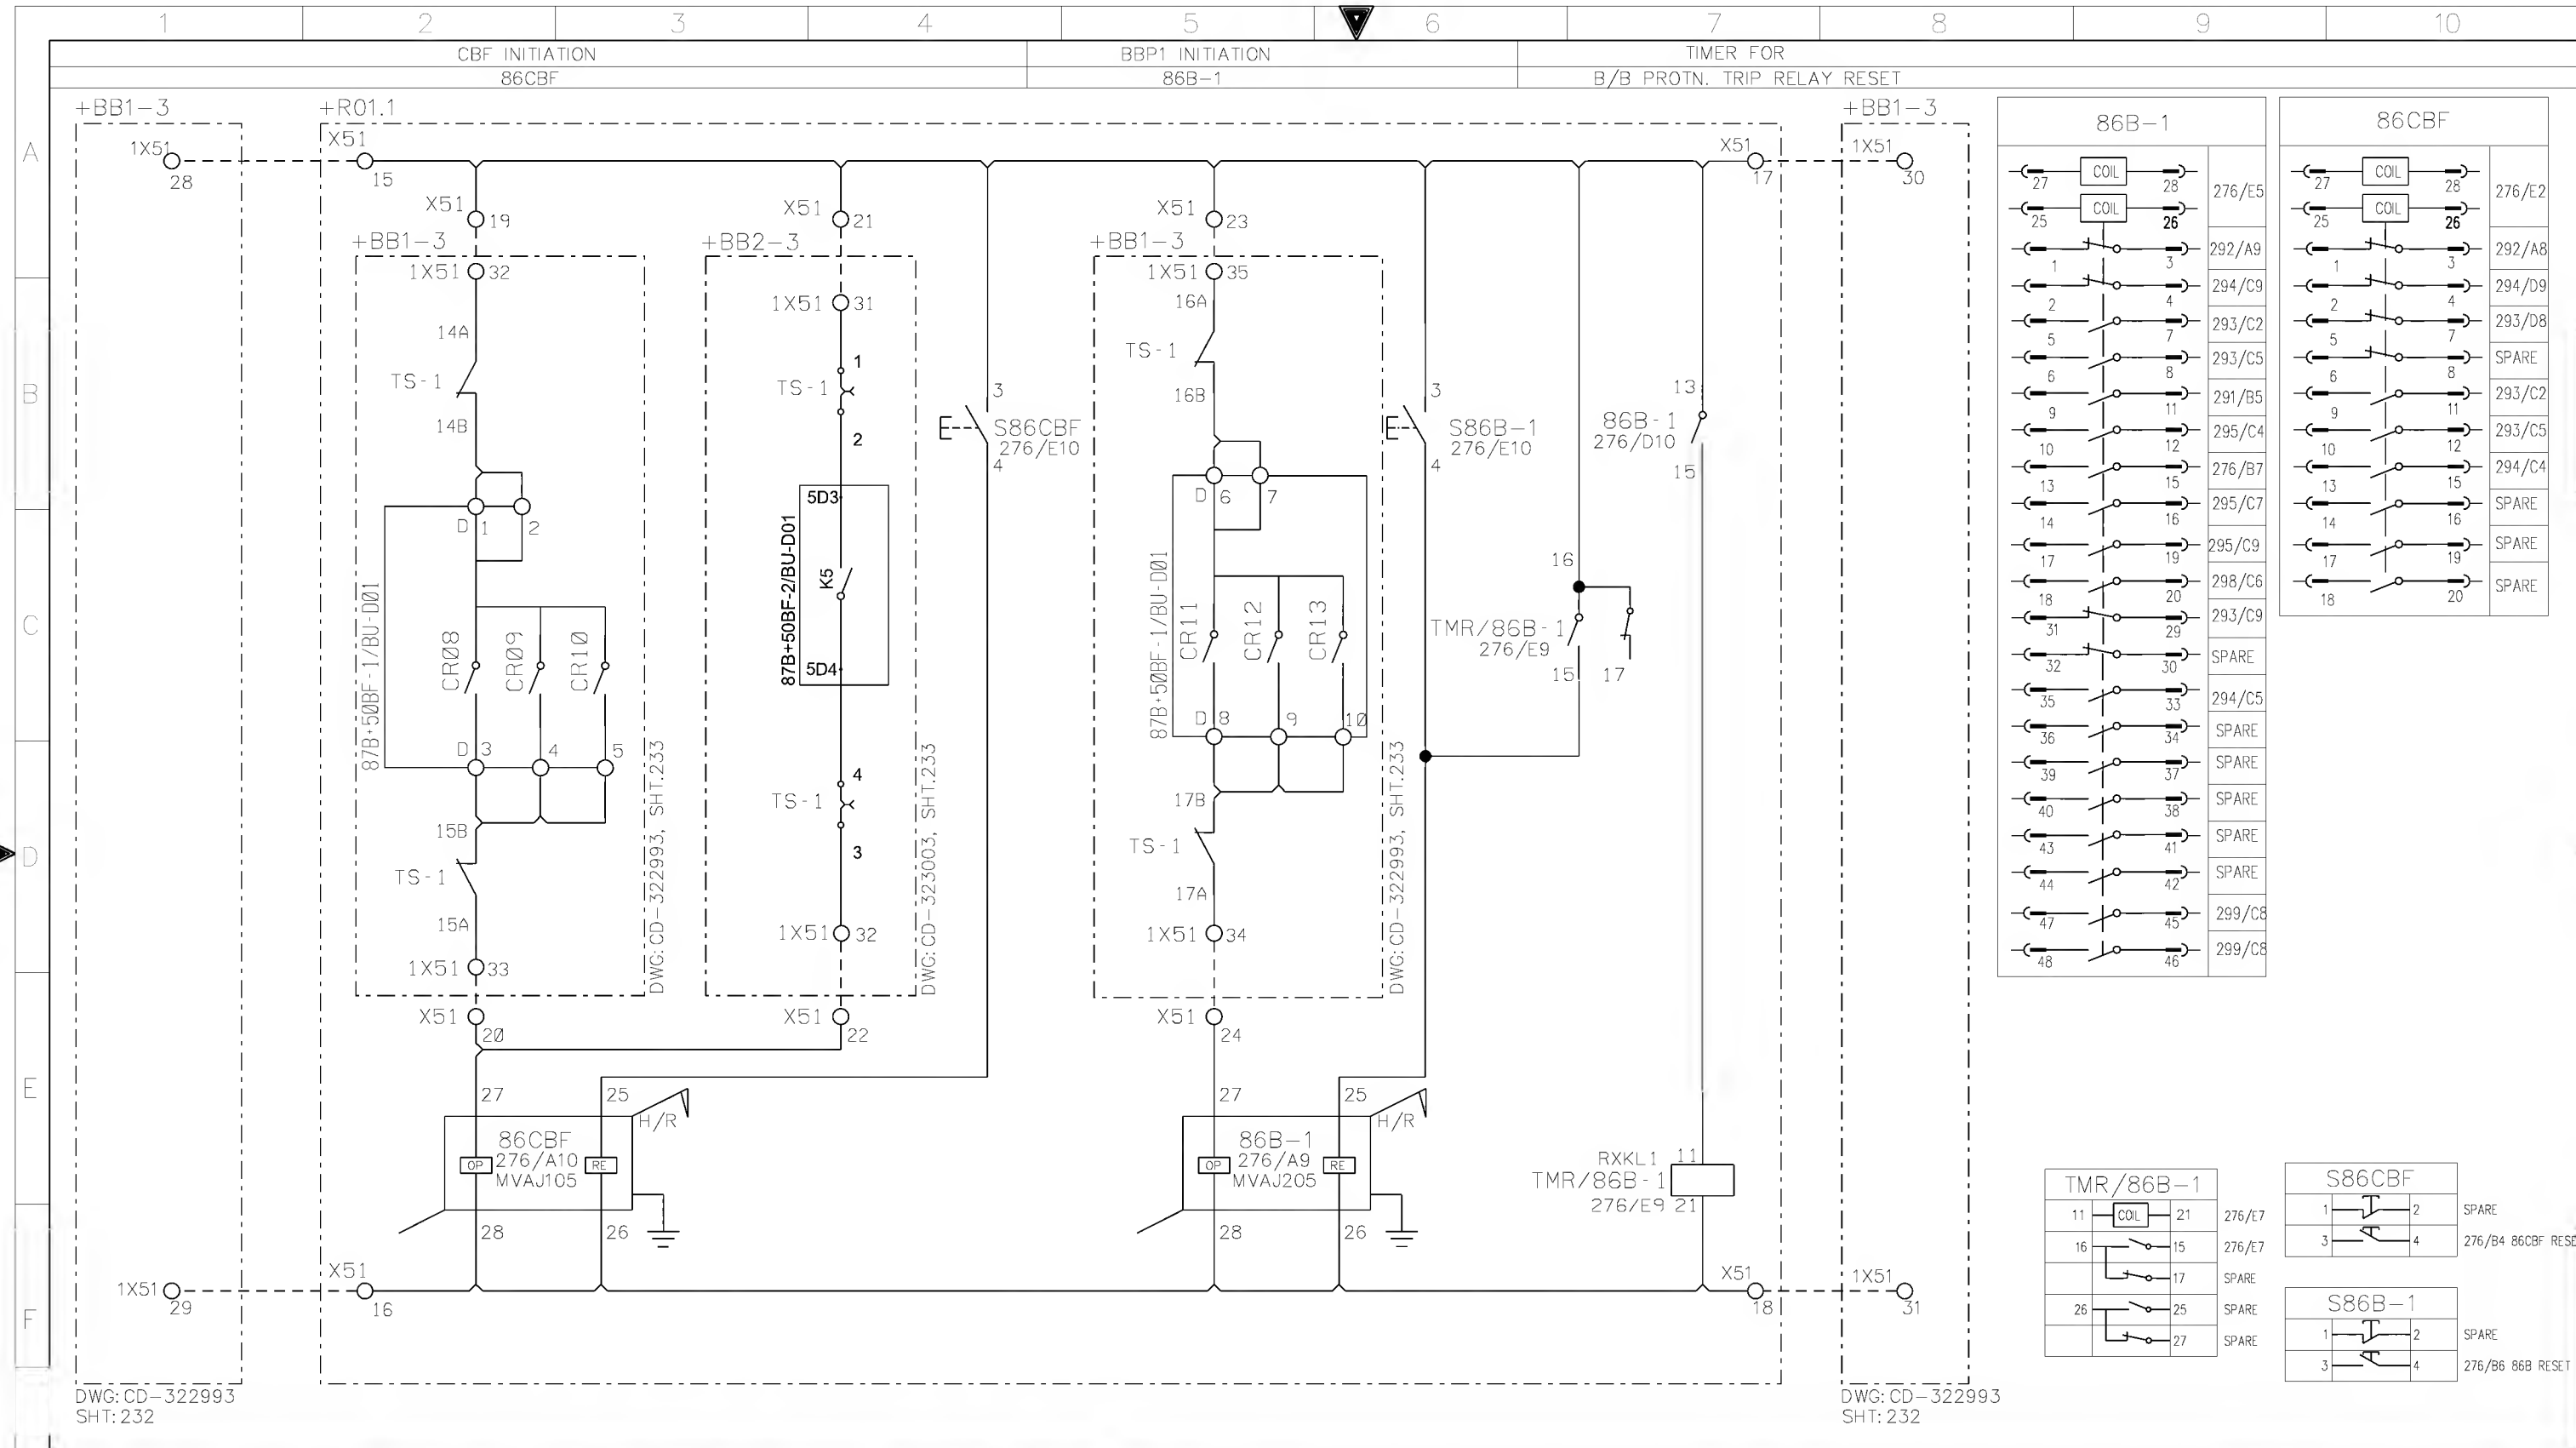

AS-BUILT BY _____ DATE _____			CONTRACT NO. 11131113/00		JOB ORDER NO. S-13656	
01	13 49	FACTORY ASBUILT	DRAWN BY RIZ		CHECKED BY JKR	
00	13 04	FOR APPROVAL	DATE STARTED 24.01.2013		DATE COMPLETED _____	
REV. NO.	DATE	DESCRIPTION	OPRG. DEPT. CTPD		ENG. DEPT. AUT-PSAC	

CBF-1/2 & BUSBAR PROTN-1 TRIP RELAY CIRCUIT
132/13.8kV GT-2 RELAY PANEL-1 +R01.1
S/S 8709-132/13.8KV IN AL-KHARJ CITY
RIYADH SAUDI ARABIA

الشركة الوطنية لنقل الكهرباء		نقل الكهرباء		National Grid sa	
INDEX	PLANT NO.	DRAWING NUMBER	SHEET NO.	REV. NO.	
-	C421	CD-322931	SHT CONT.	01	
			276 277		

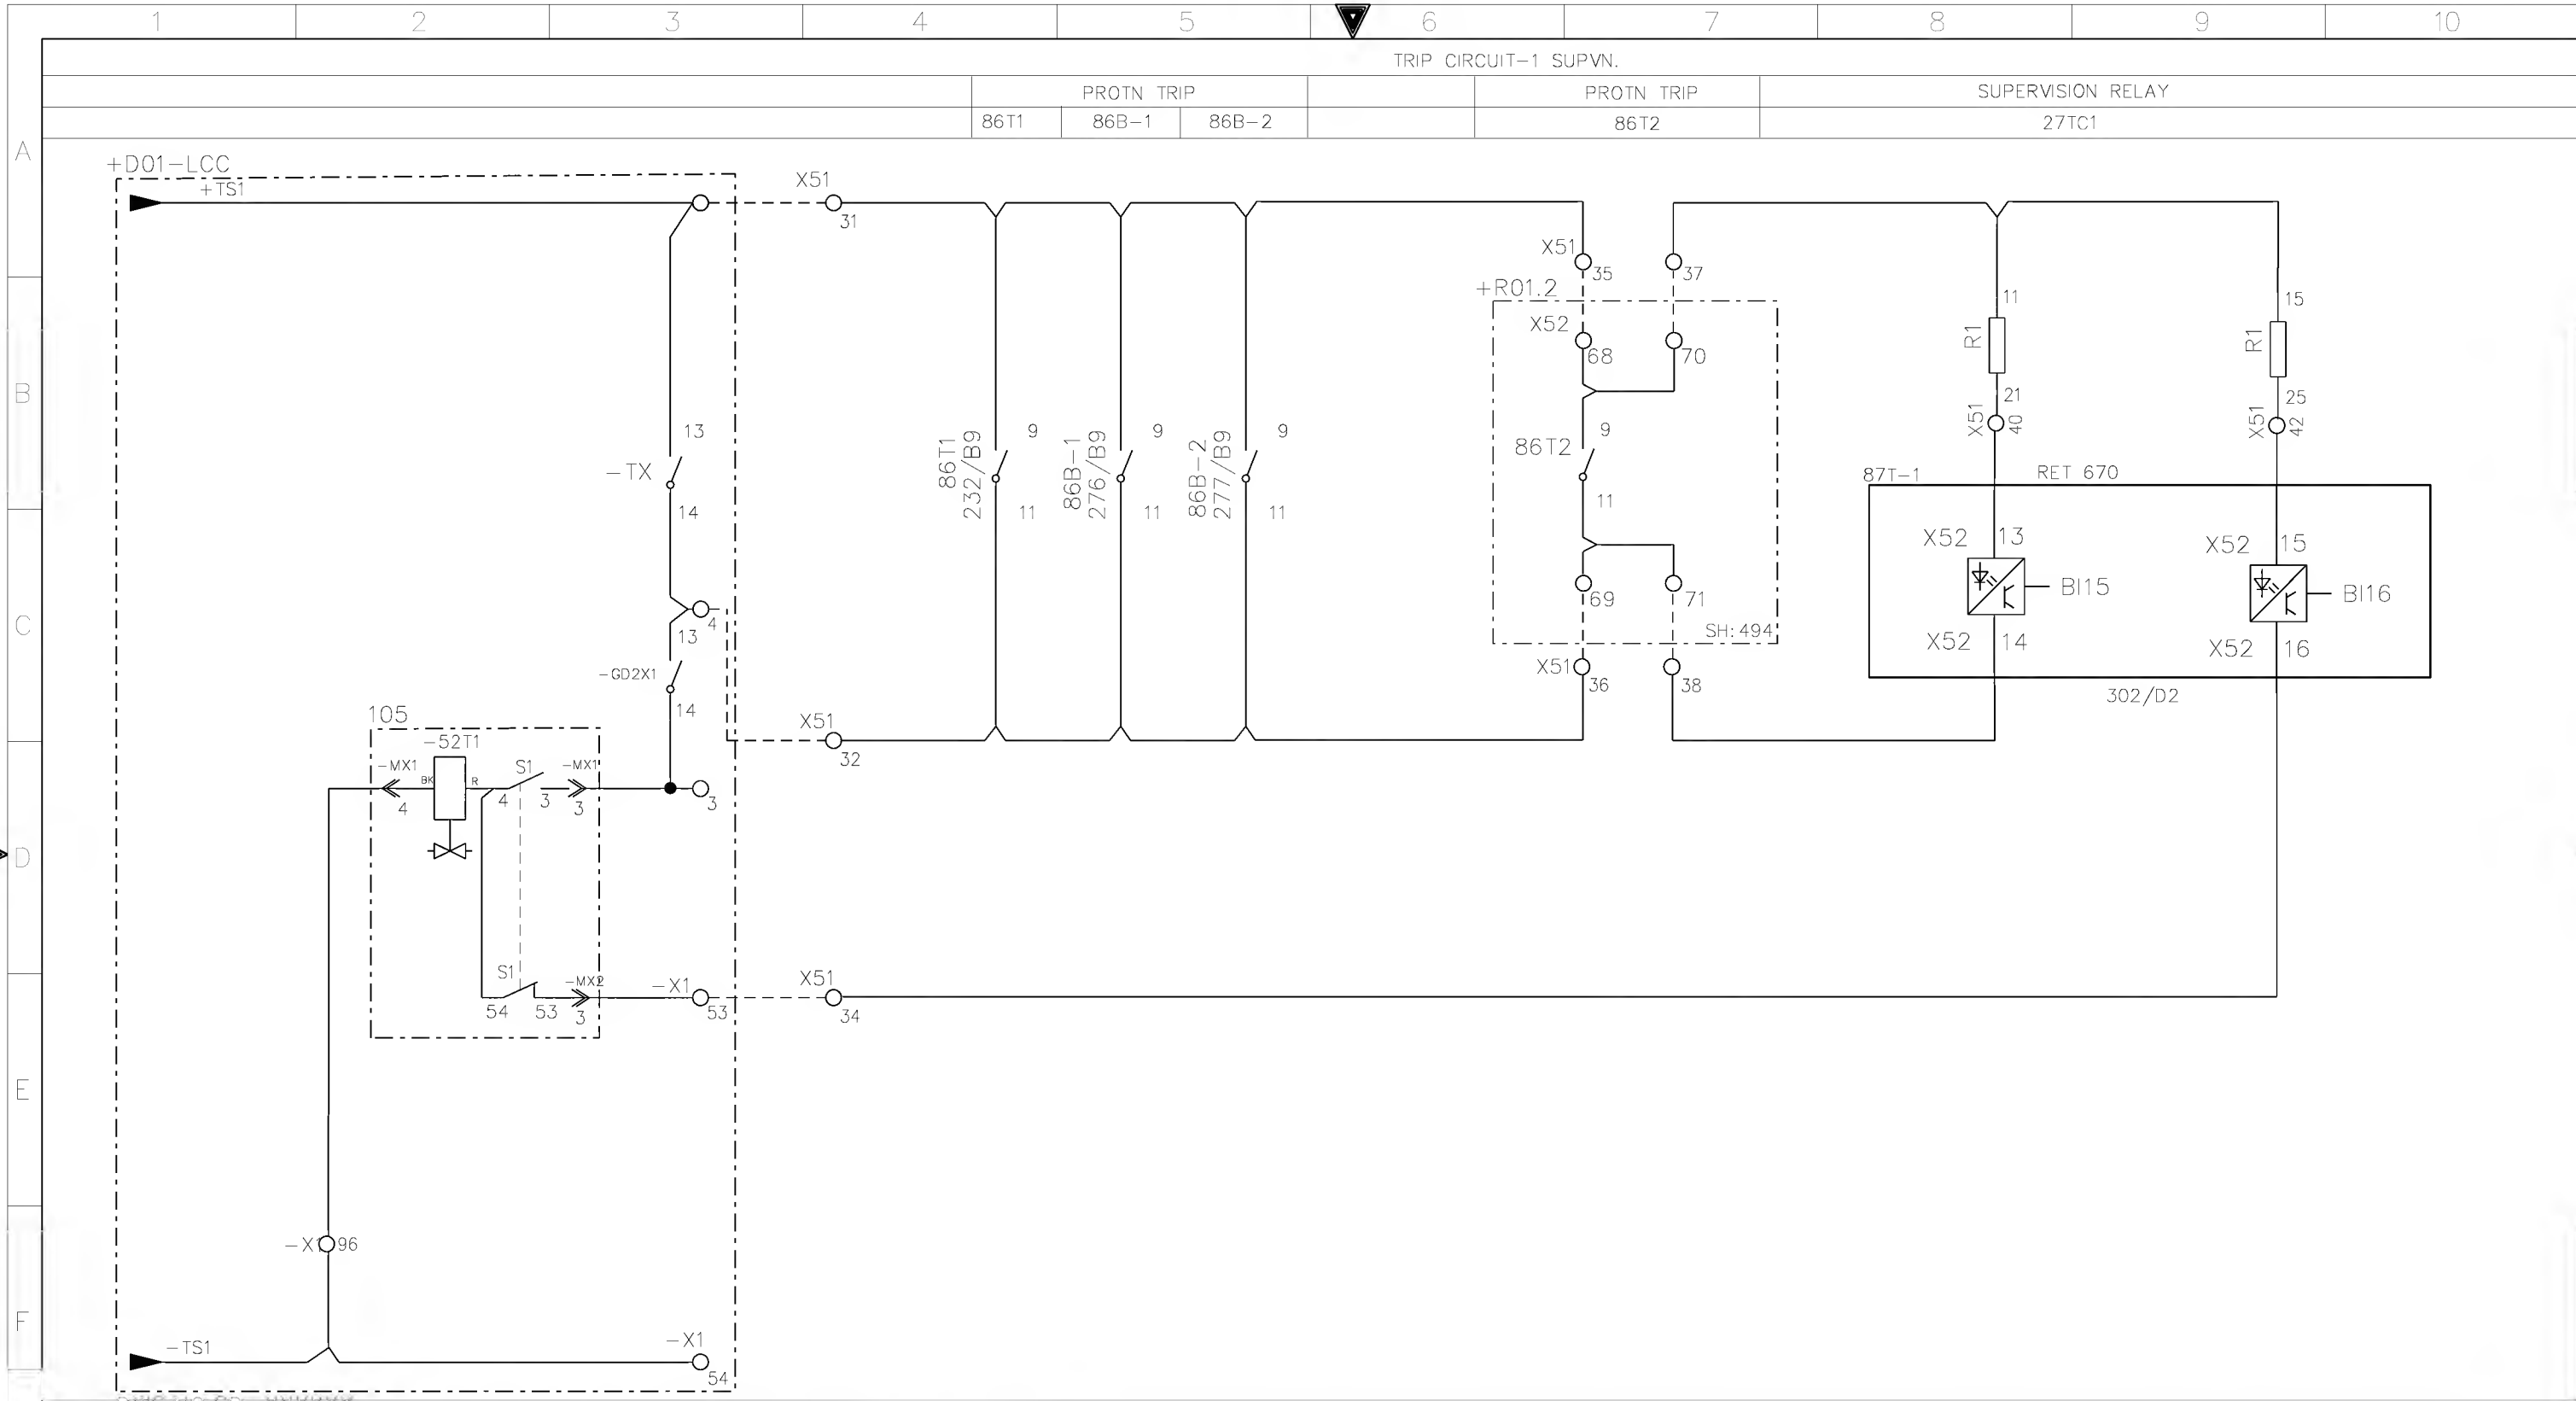

DWG. NO. CD=XXXXXX
SHT. XX

+R01.1

AS-BUILT BY _____ DATE _____ CONTRACT NO. 11131113/00 JOB ORDER NO. S-13656


01	13 49	FACTORY ASBUILT	DRAWN BY RIZ	CHECKED BY JKR
00	13 04	FOR APPROVAL	DATE STARTED 24.01.2013	DATE COMPLETED
REV. NO.	DATE	DESCRIPTION	OPRG. DEPT. CTPD	ENG. DEPT. AUT-PSAC

TRIP COIL-1 SUPERVSION CIRCUIT
132/13.8kV GT-2 RELAY PANEL-1 +R01.1
S/S 8709-132/13.8KV IN AL-KHARJ CITY
RIYADH SAUDI ARABIA

الشركة الوطنية لنقل الكهرباء		نقل الكهرباء	
National Grid sa		National Grid sa	
INDEX	PLANT NO.	DRAWING NUMBER	SHEET NO.
-	C421	CD-322931	291
			292
			01

NG/D2-D (2012/01)

DMS VECTOR NGD200

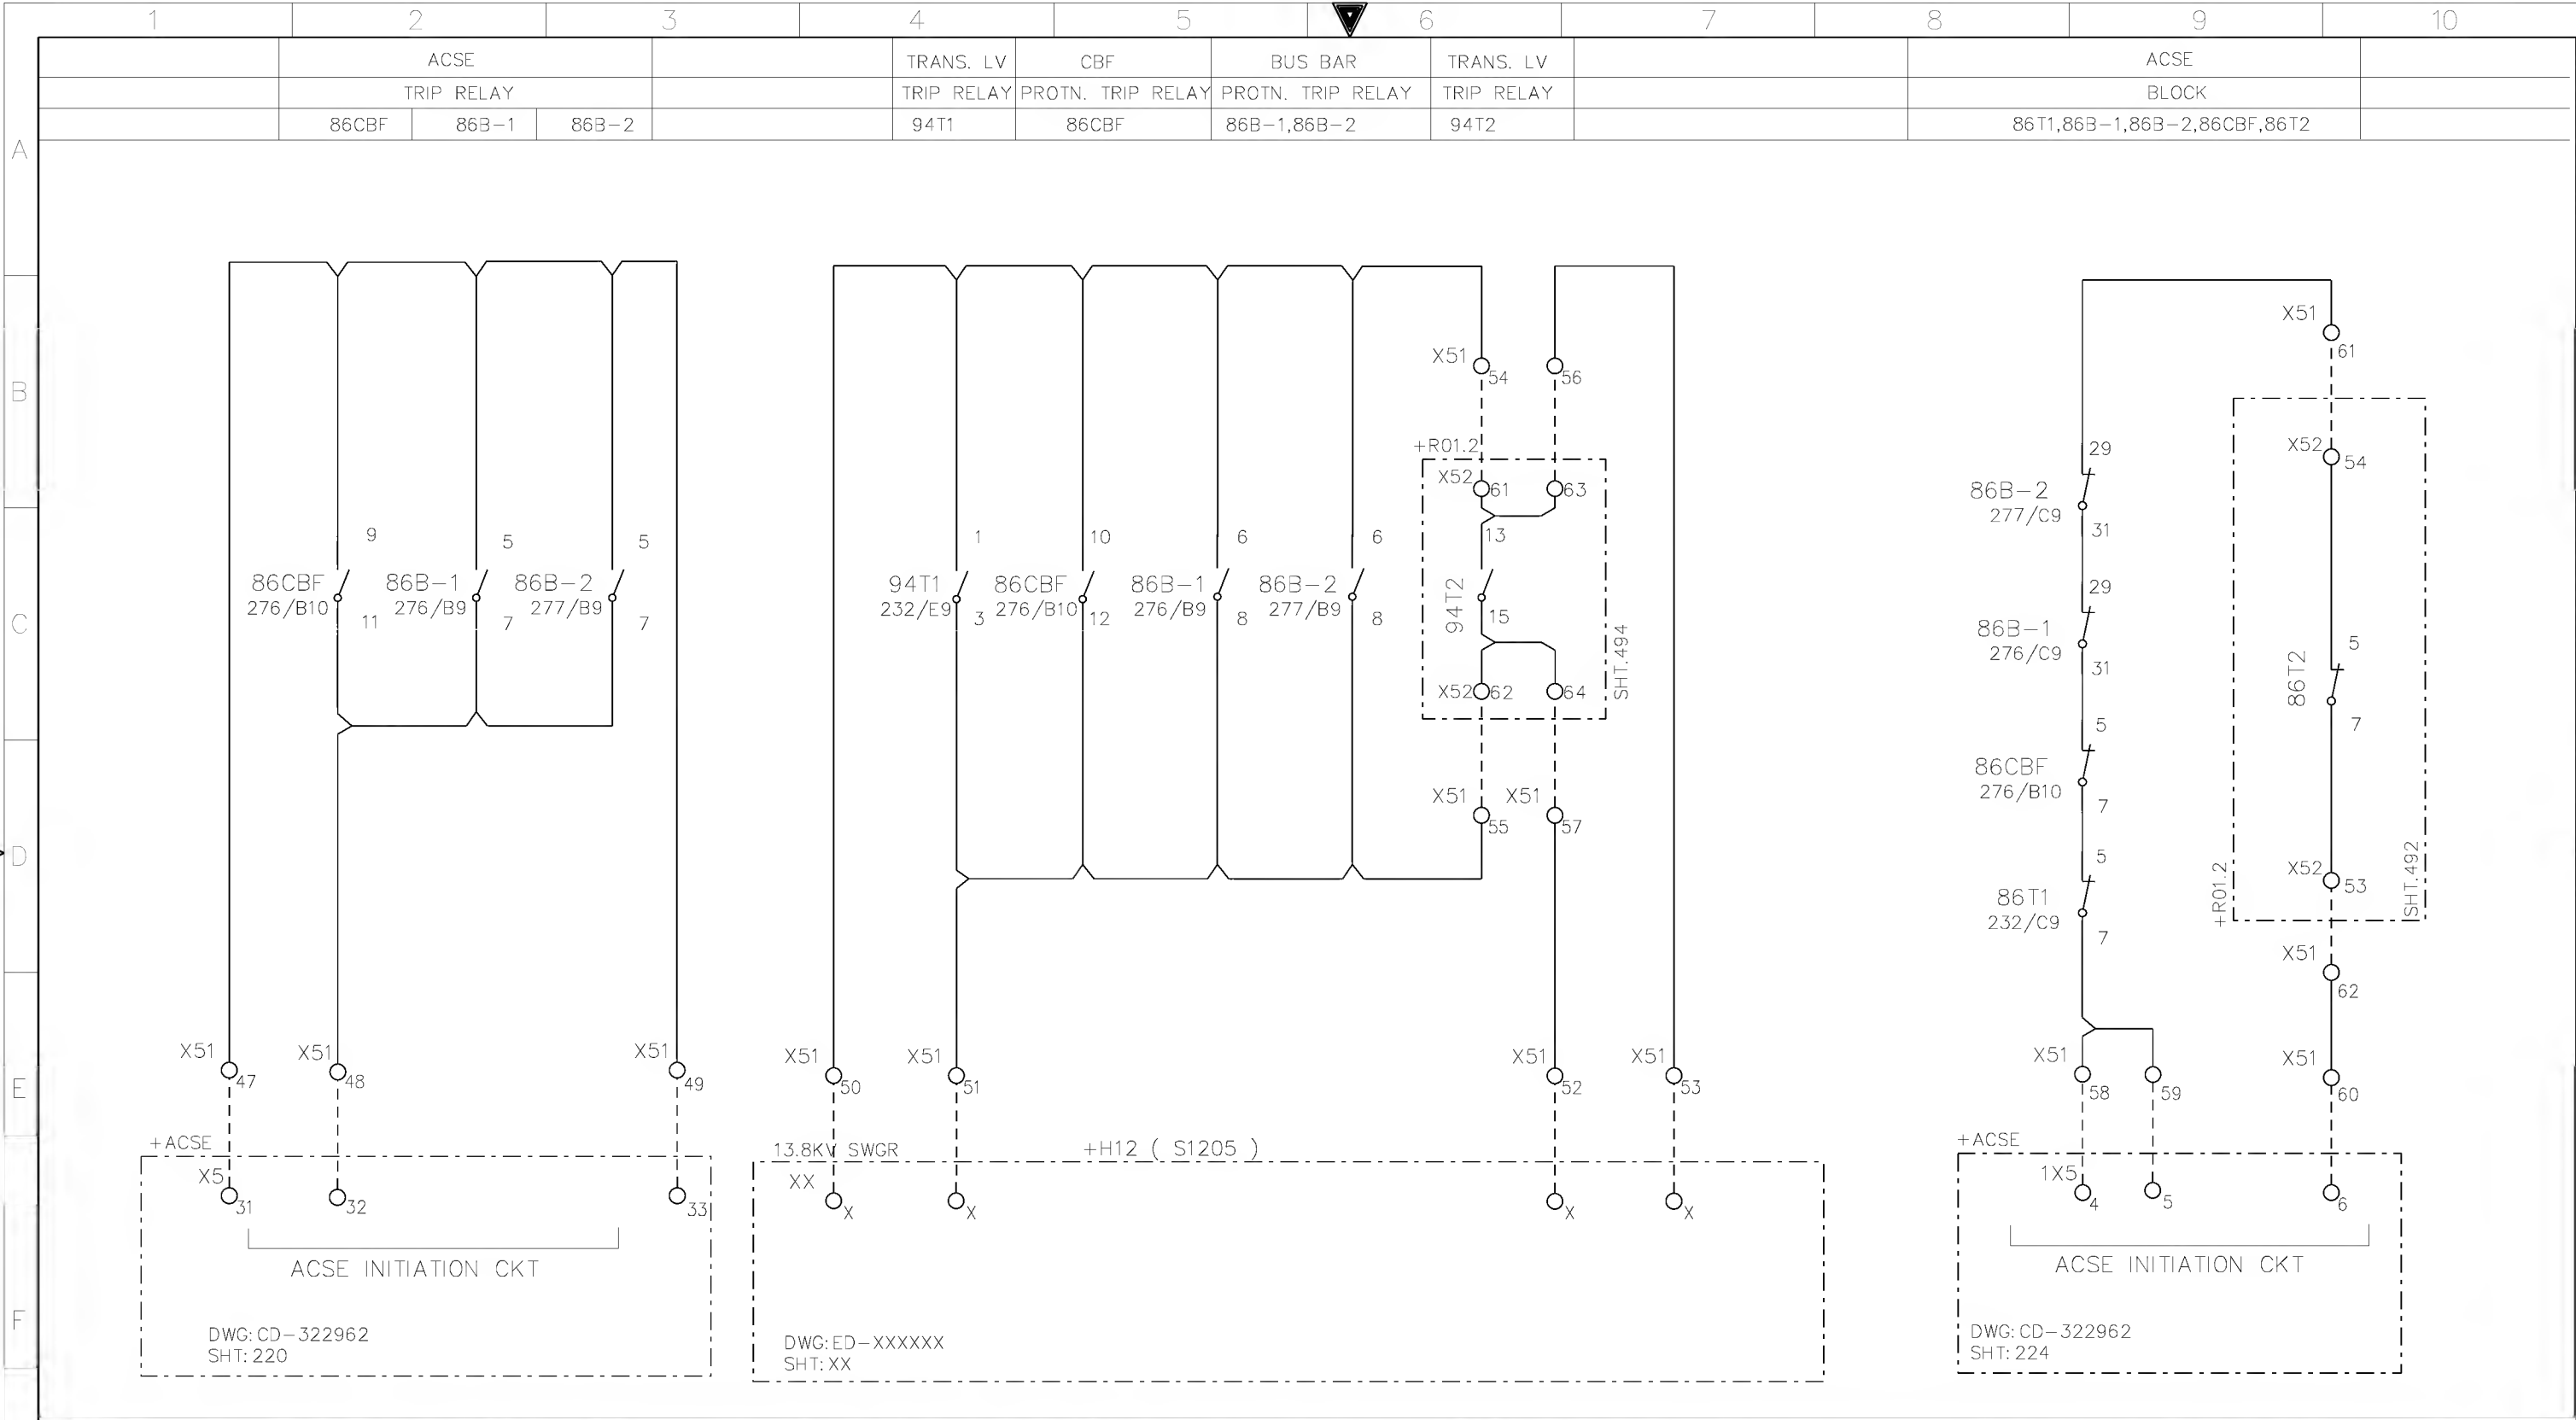


AS-BUILT BY _____ DATE _____ CONTRACT NO. 11131113/00 JOB ORDER NO. S-13656

01	13 49	FACTORY ASBUILT	DRAWN BY RIZ	CHECKED BY JKR
00	13 04	FOR APPROVAL	DATE STARTED 24.01.2013	DATE COMPLETED
REV. NO.	DATE	DESCRIPTION	OPRG. DEPT. CTPD	ENG. DEPT. AUT-PSAC

CONTACTS FOR ACSE INITIATION & LV TRIPPING TC
132/13.8kv GT-2 RELAY PANEL-1 +R01.1
S/S 8709-132/13.8KV IN AL-KHARJ CITY
RIYADH SAUDI ARABIA

الشركة الوطنية لنقل الكهرباء				نقل الكهرباء	
				National Grid SA	
INDEX	PLANT NO.	DRAWING NUMBER	SHEET NO.		REV. NO.
	C421	CD-322931	SHT	CONT.	01
			293	294	

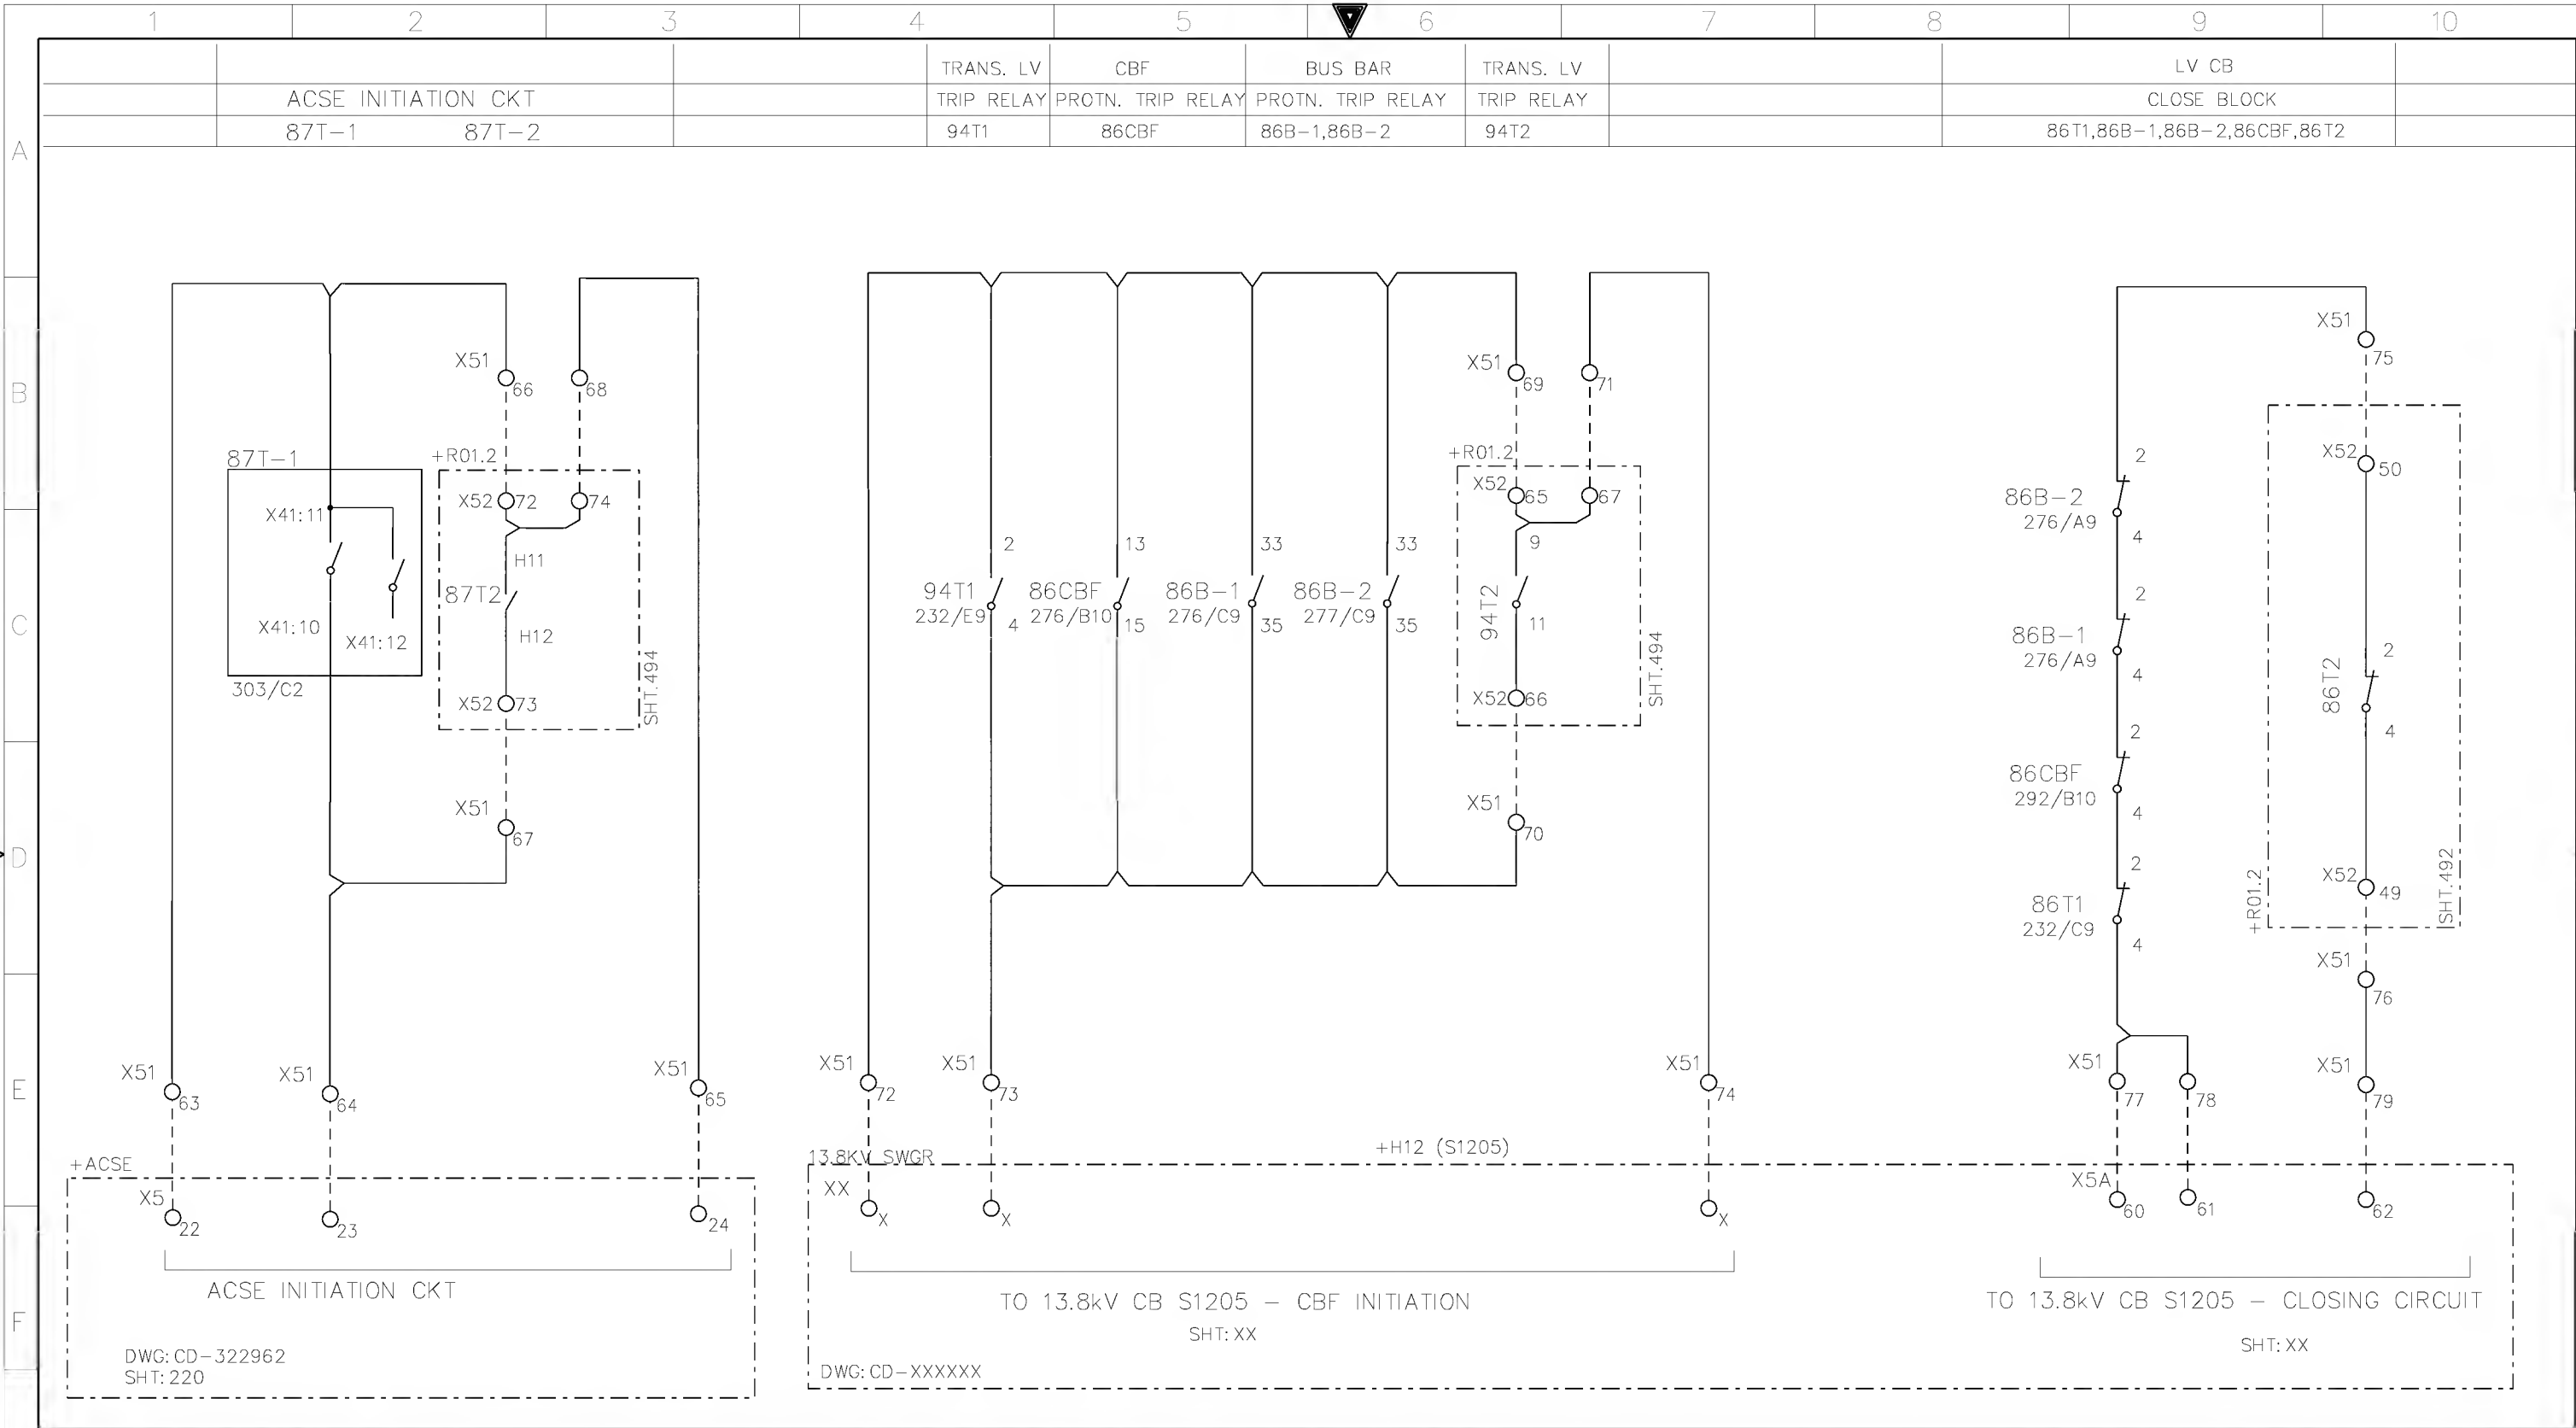

AS-BUILT BY _____ DATE _____

CONTRACT NO. 11131113/00

JOB ORDER NO. S-13656

01

13 49

FACTORY ASBUILT

00

13 04

FOR APPROVAL

REV. NO.

DATE

DESCRIPTION

DRAWN BY RIZ

CHECKED BY JKR

DATE STARTED 24.01.2013

DATE COMPLETED

OPRG. DEPT. CTPD

ENG. DEPT. AUT-PSAC


ACSE INI & LV CLOSE BLK CIRCUIT

132/13.8kV GT-2 RELAY PANEL-1 +R01.1

S/S 8709-132/13.8KV IN AL-KHARJ CITY

RIYADH SAUDI ARABIA

الشركة الوطنية لنقل الكهرباء

نقل الكهرباء

National Grid sa

INDEX

PLANT NO.

DRAWING NUMBER

SHEET NO.

SHT

CONT.

REV. NO.

-


C421

CD-322931


294

295

01

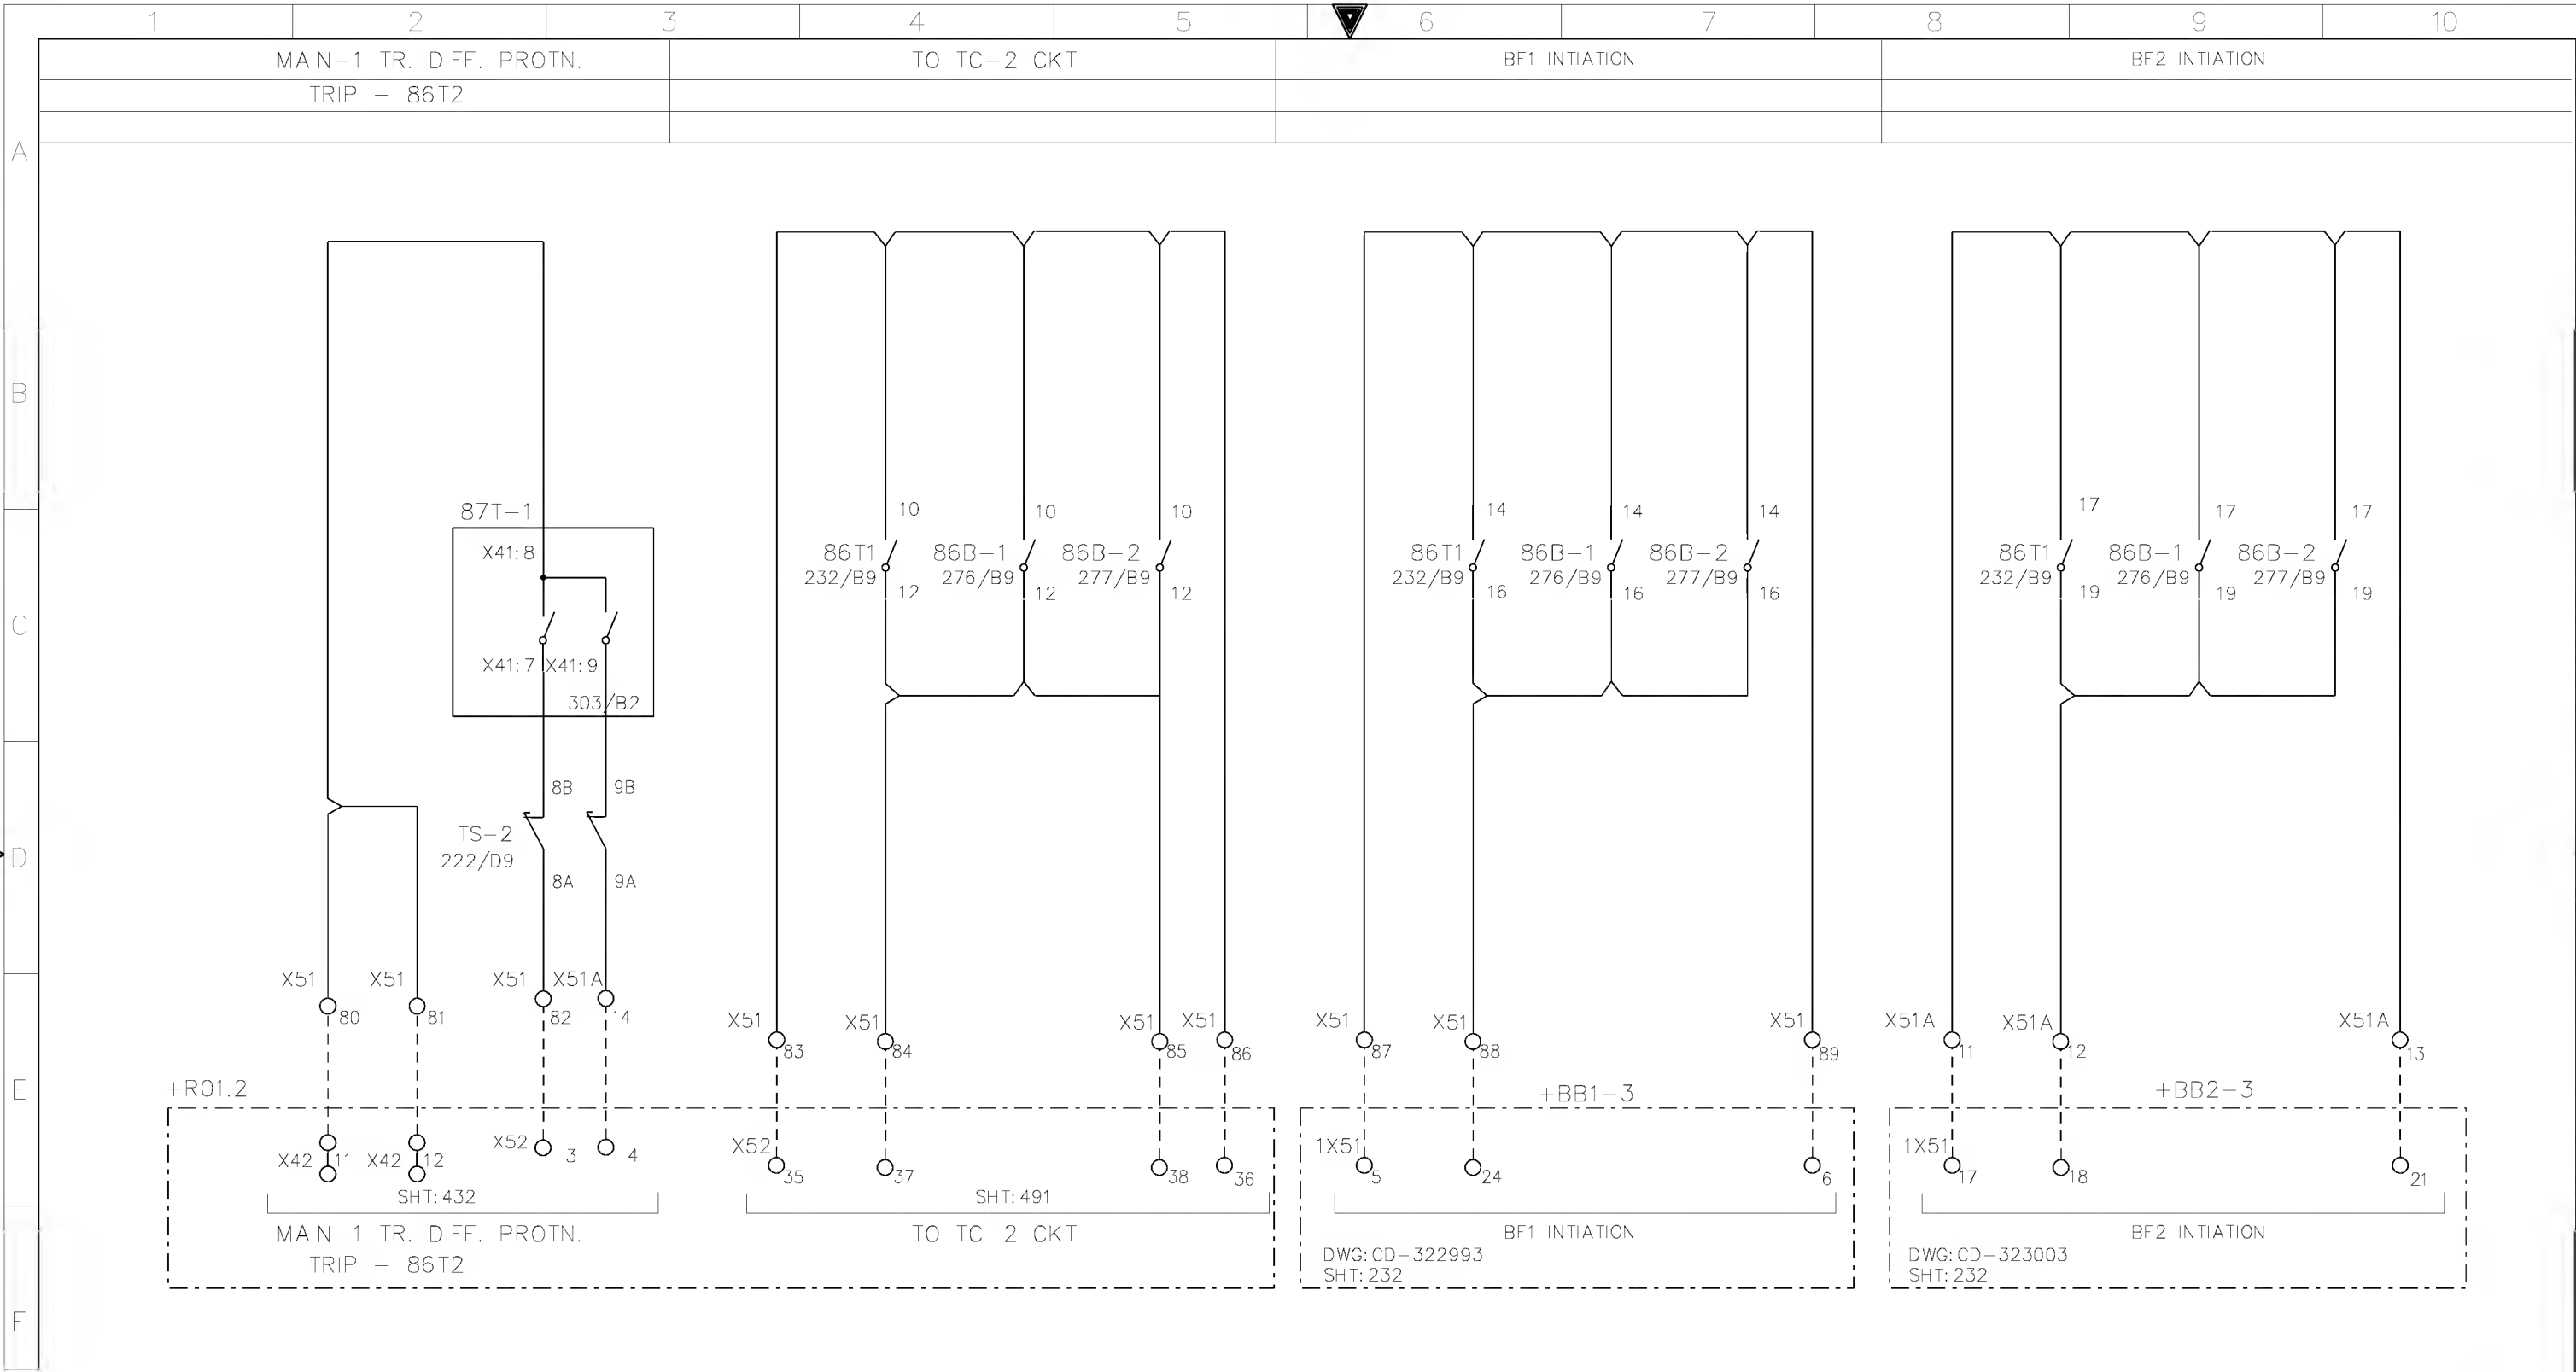

AS-BUILT BY _____ DATE _____			CONTRACT NO. 11131113/00		JOB ORDER NO. S-13656		CONTACTS FOR TRIP CIRCUIT-2 & BF1½		<div>الشركة الوطنية لنقل الكهرباء</div> <div>نقل الكهرباء</div> <div>National Grid sa</div>									
			DRAWN BY RIZ		CHECKED BY JKR		132/13.8kv GT-2 RELAY PANEL-1 +R01.1											
01 13 49			FACTORY ASBUILT		DATE STARTED 24.01.2013		DATE COMPLETED _____		S/S 8709-132/13.8KV IN AL-KHARJ CITY		INDEX	PLANT NO.	DRAWING NUMBER		SHEET NO.		REV. NO.	
00 13 04			FOR APPROVAL		OPRG. DEPT. CTPD		ENG. DEPT. AUT-PSAC		RIYADH SAUDI ARABIA		-	C421	CD-322931		SHT 295		CONT. 296	01
REV. NO.			DATE		DESCRIPTION													

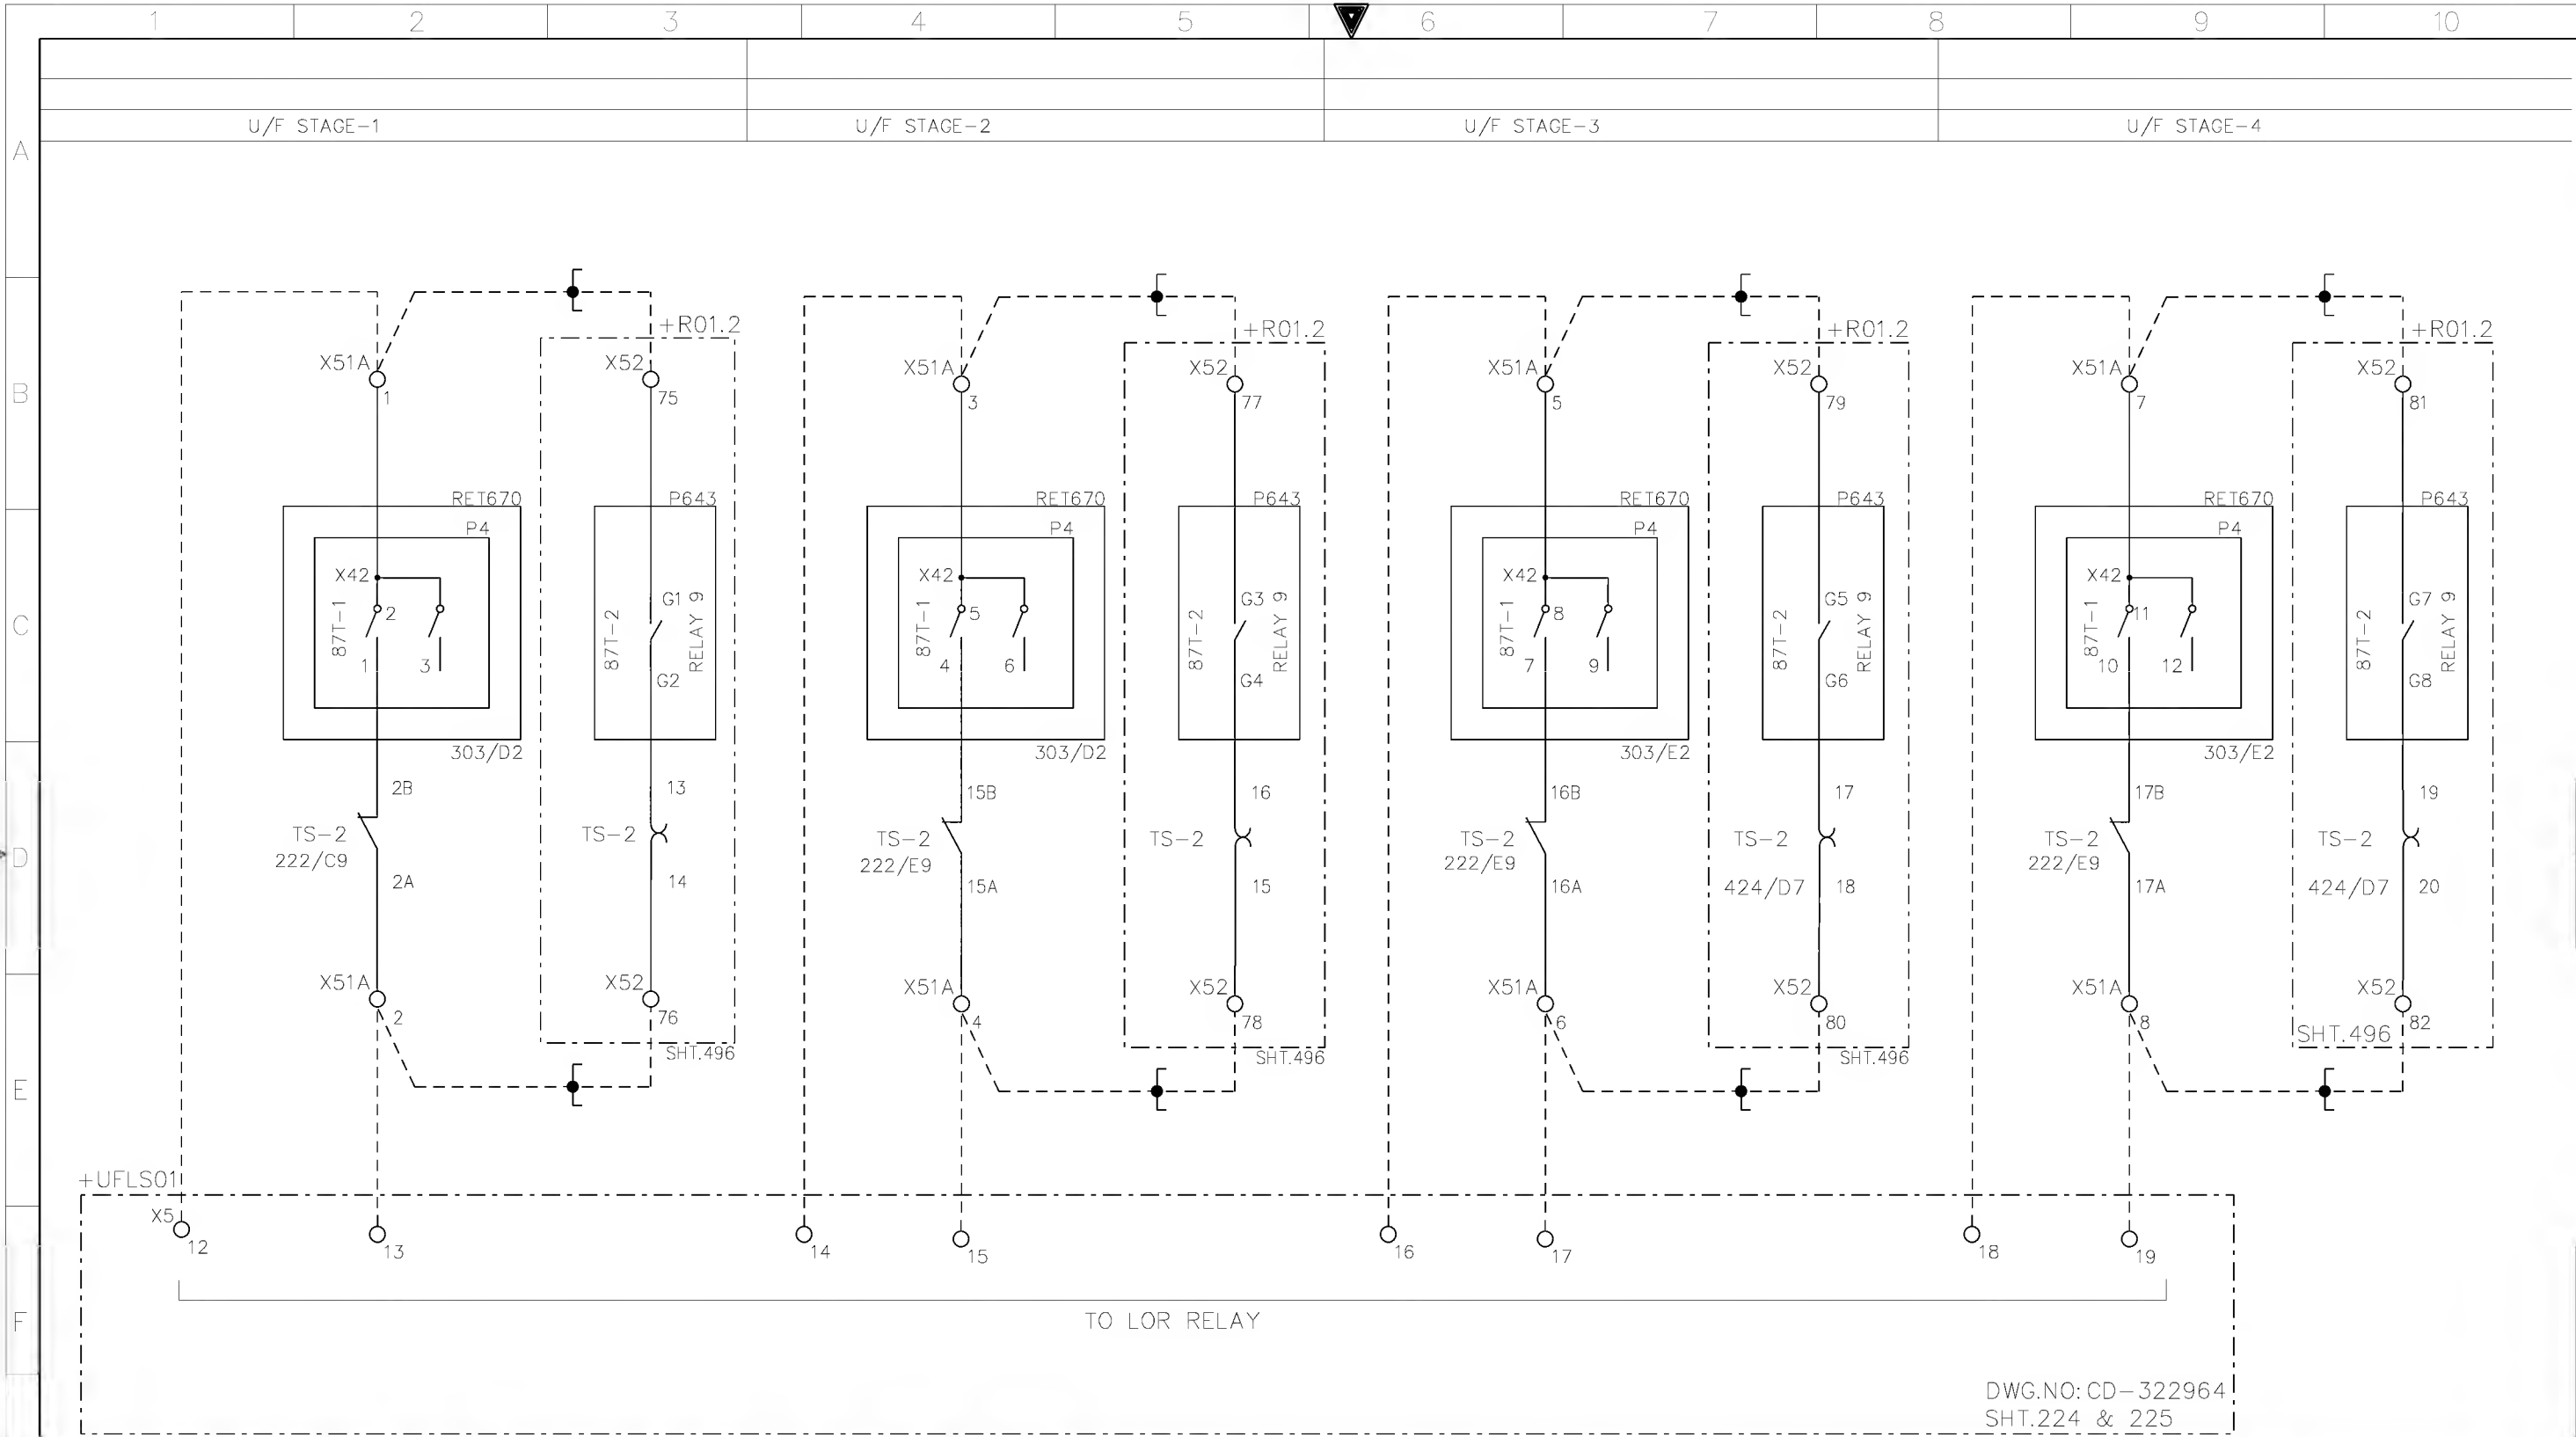


DWG.NO: CD-322964
SHT.224 & 225

G

AS-BUILT BY _____ DATE _____			CONTRACT NO. 11131113/00		JOB ORDER NO. S-13656	
01	13 49	FACTORY ASBUILT	DRAWN BY RIZ CHECKED BY JKR			
00	13 04	FOR APPROVAL	DATE STARTED 24.01.2013 DATE COMPLETED _____			
REV. NO.	DATE	DESCRIPTION	OPRG. DEPT. CTPD ENG. DEPT. AUT-PSAC			

CONTACTS FOR U/F LOAD SHEDDING					
132/13.8kV GT-2 RELAY PANEL-1 +R01.1					
S/S 8709-132/13.8KV IN AL-KHARJ CITY					
RIYADH SAUDI ARABIA					

الشركة الوطنية لنقل الكهرباء							نقل الكهرباء	
							National Grid sa	
INDEX	PLANT NO.	DRAWING NUMBER		SHEET NO.		REV. NO.		
-	C421	CD-322931		SHT	CONT.	01		
				296	298			


NG/D2-D (2012/01)

DMS

VECTOR

NGD200

THIS DRAWING AND THE INFORMATION CONTAINED HEREIN ARE THE SOLE PROPERTY OF NATIONAL GRID SA. NO REPRODUCTION IN FULL OR IN PART SHALL BE OBTAINED FROM THIS DOCUMENT WITHOUT THE WRITTEN CONSENT OF ITS OWNER.

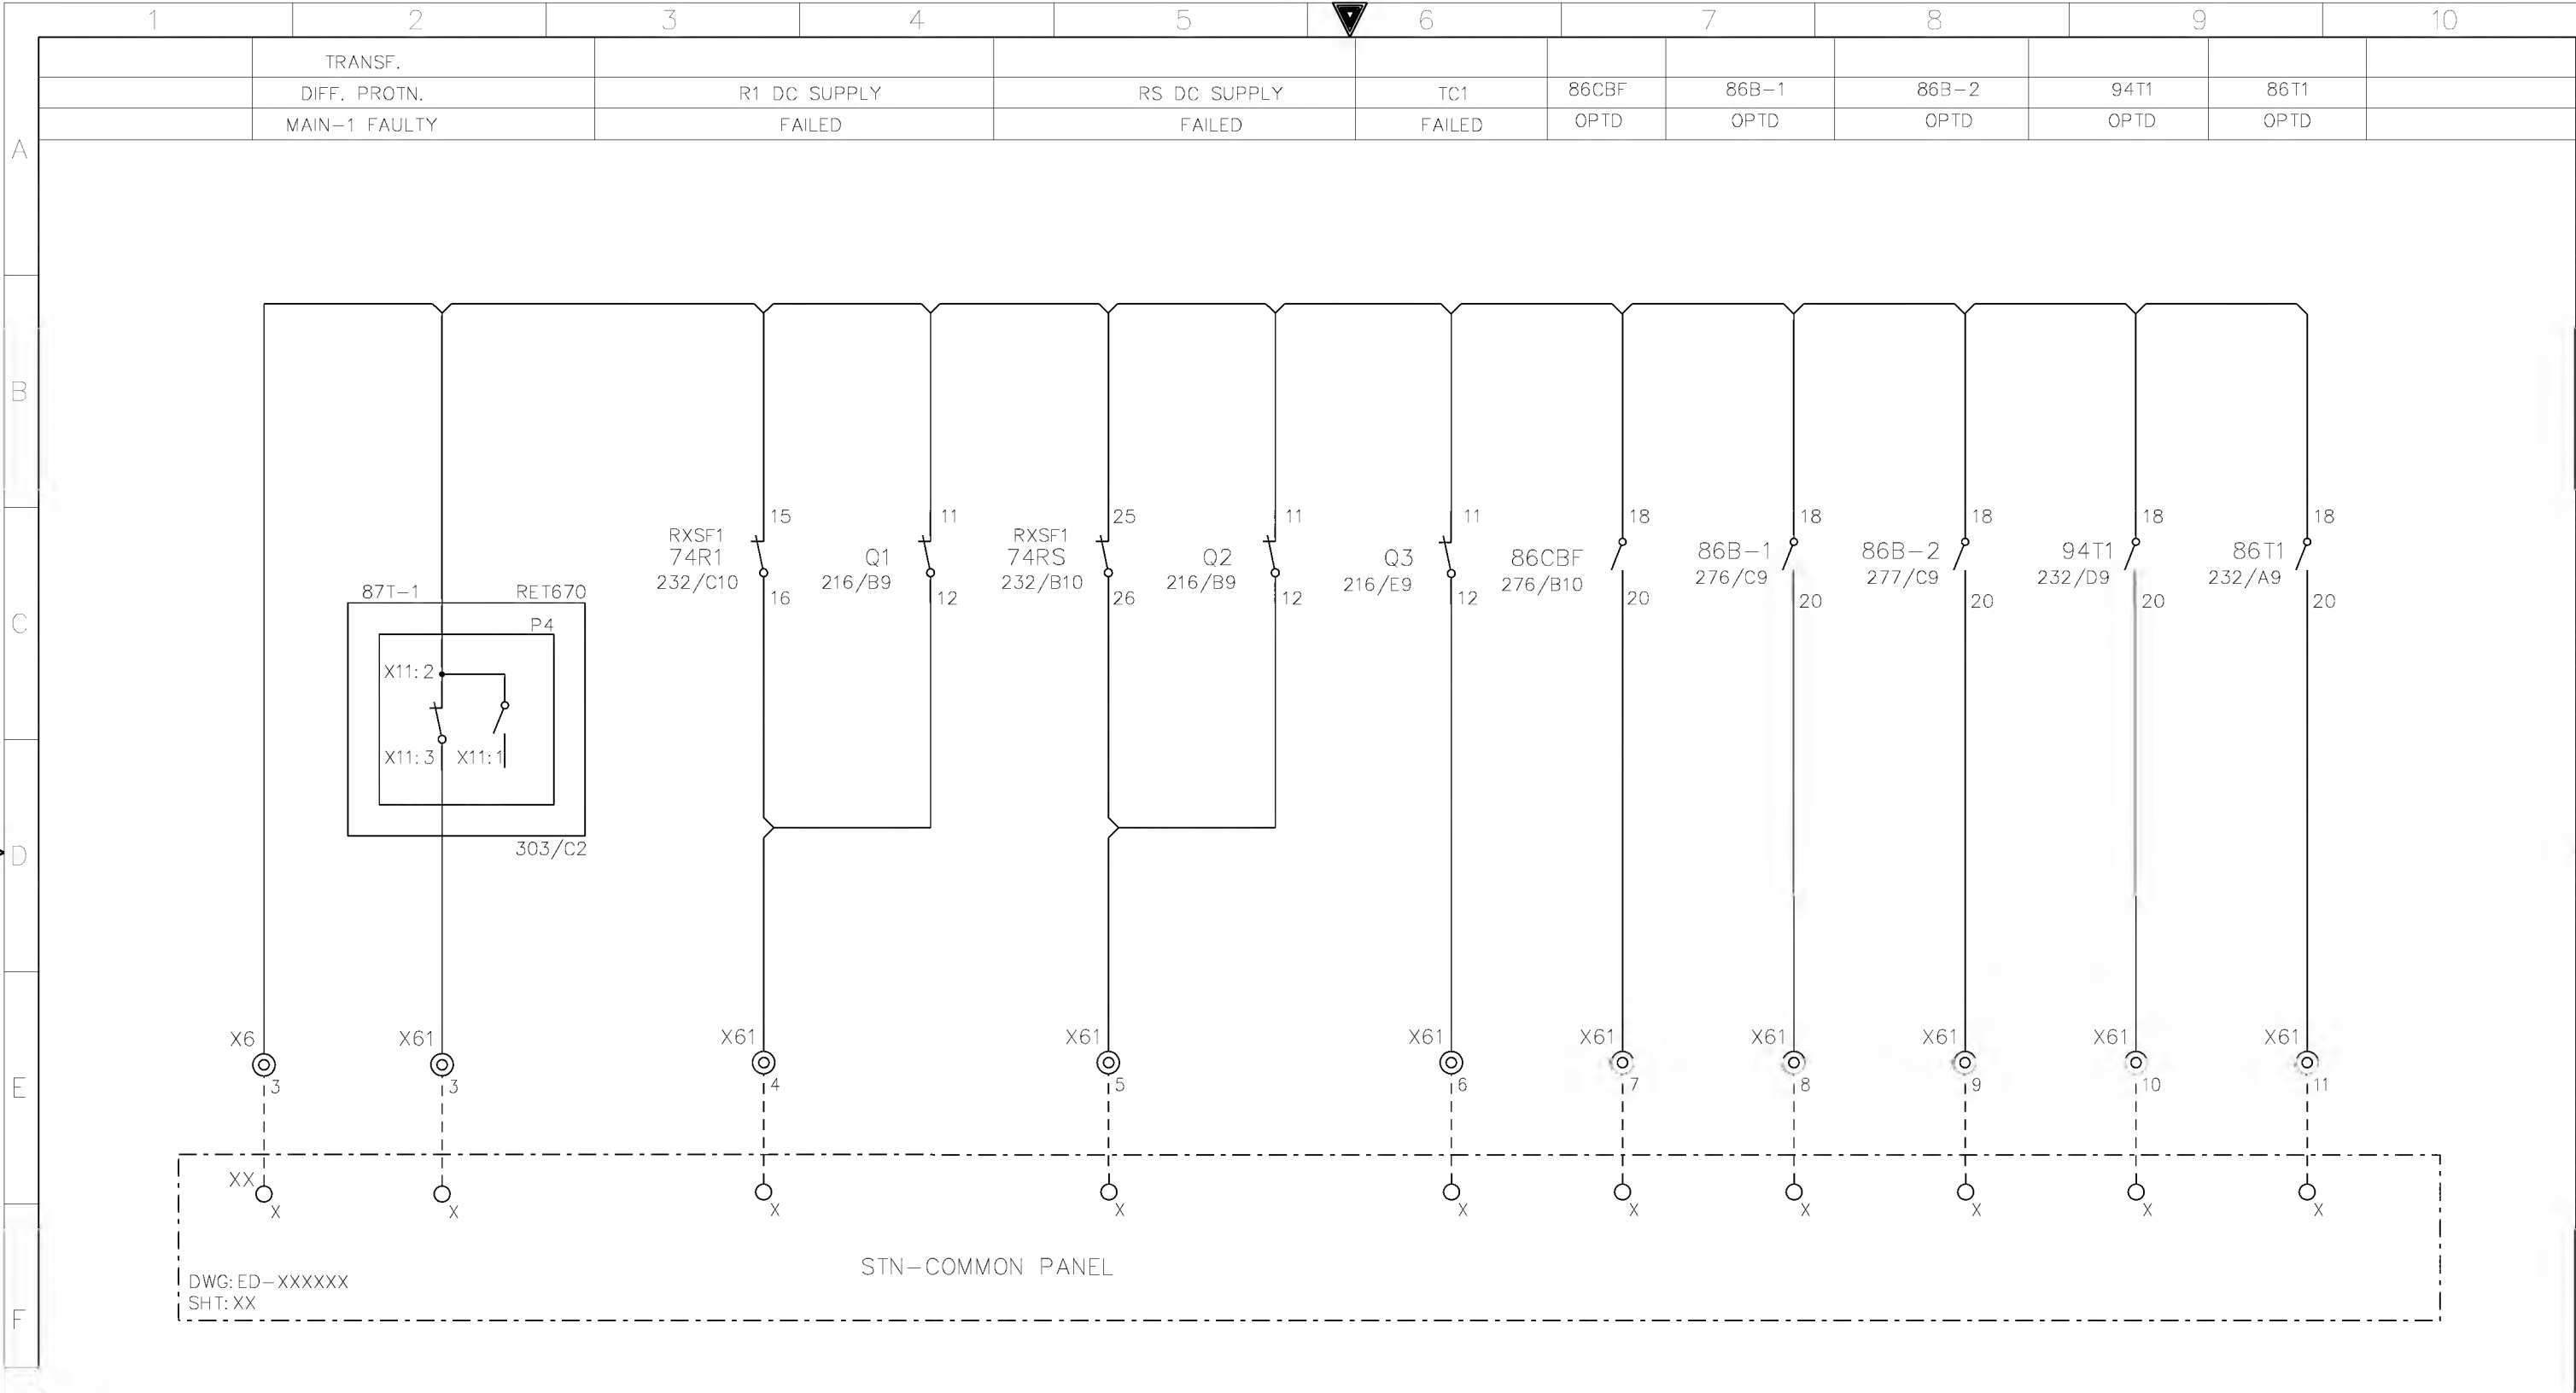

AS-BUILT BY _____ DATE _____ CONTRACT NO. 11131113/00 JOB ORDER NO. S-13656

01	13 49	FACTORY ASBUILT	DRAWN BY RIZ	CHECKED BY JKR
00	13 04	FOR APPROVAL	DATE STARTED 24.01.2013	DATE COMPLETED
REV. NO.	DATE	DESCRIPTION	OPRG. DEPT. CTPD	ENG. DEPT. AUT-PSAC

STN-COMMON ALARM CIRCUIT

132/13.8kV GT-2 RELAY PANEL-1 +R01.1

S/S 8709-132/13.8KV IN AL-KHARJ CITY
RIYADH SAUDI ARABIA

الشركة الوطنية لنقل الكهرباء




INDEX	PLANT NO.	DRAWING NUMBER	SHEET NO.	REV. NO.
-	C421	CD-322931	SHT 298	CONT. 299
				01

NG/D2-D (2012/01)

DMS

VECTOR

NGD200

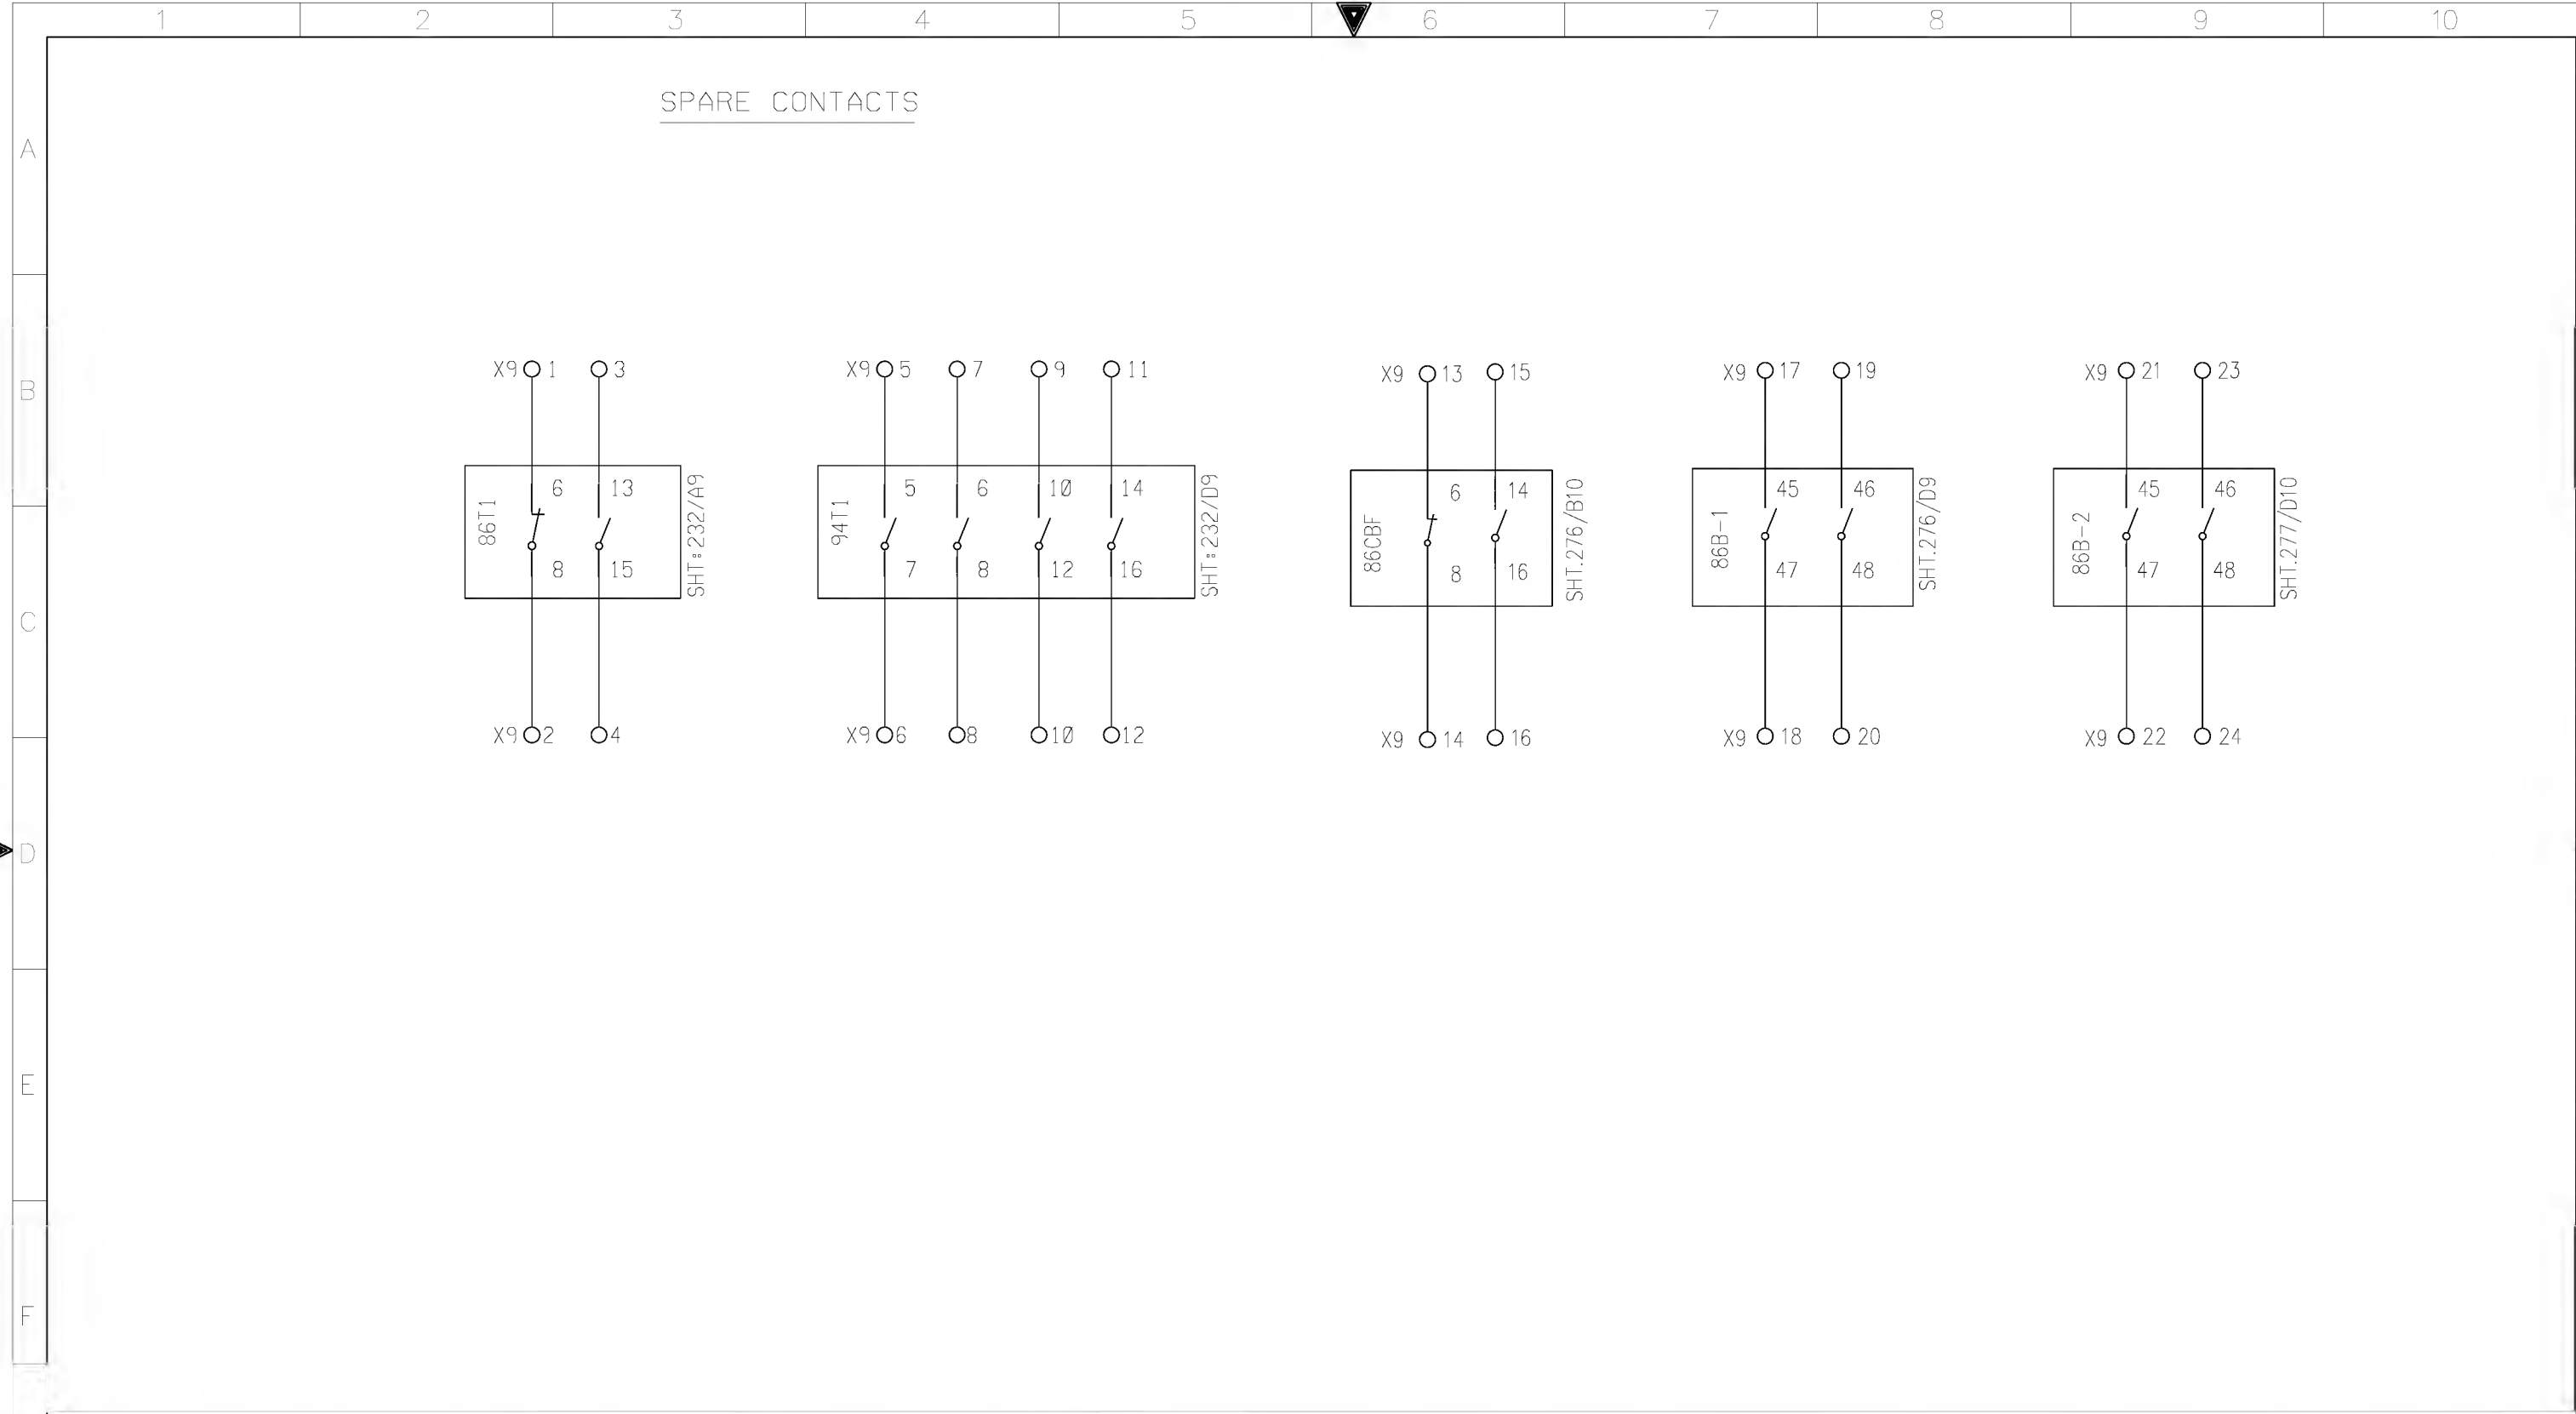

AS-BUILT BY _____ DATE _____ CONTRACT NO. 11131113/00 JOB ORDER NO. S-13656

01	13 49	FACTORY ASBUILT	DRAWN BY RIZ	CHECKED BY JKR
00	13 04	FOR APPROVAL	DATE STARTED 24.01.2013	DATE COMPLETED
REV. NO.	DATE	DESCRIPTION	OPRG. DEPT. CTPD	ENG. DEPT. AUT-PSAC

LOR SPARE CONTACTS

132/13.8kV GT-2 RELAY PANEL-1 +R01.1

S/S 8709-132/13.8KV IN AL-KHARJ CITY
RIYADH SAUDI ARABIA

الشركة الوطنية لنقل الكهرباء



National Grid sa


INDEX	PLANT NO.	DRAWING NUMBER	SHEET NO.	REV. NO.
-	C421	CD-322931	SHT 299	CONT. 301
				01

NG/D2-D (2012/01)

DMS

VECTOR

NGD200

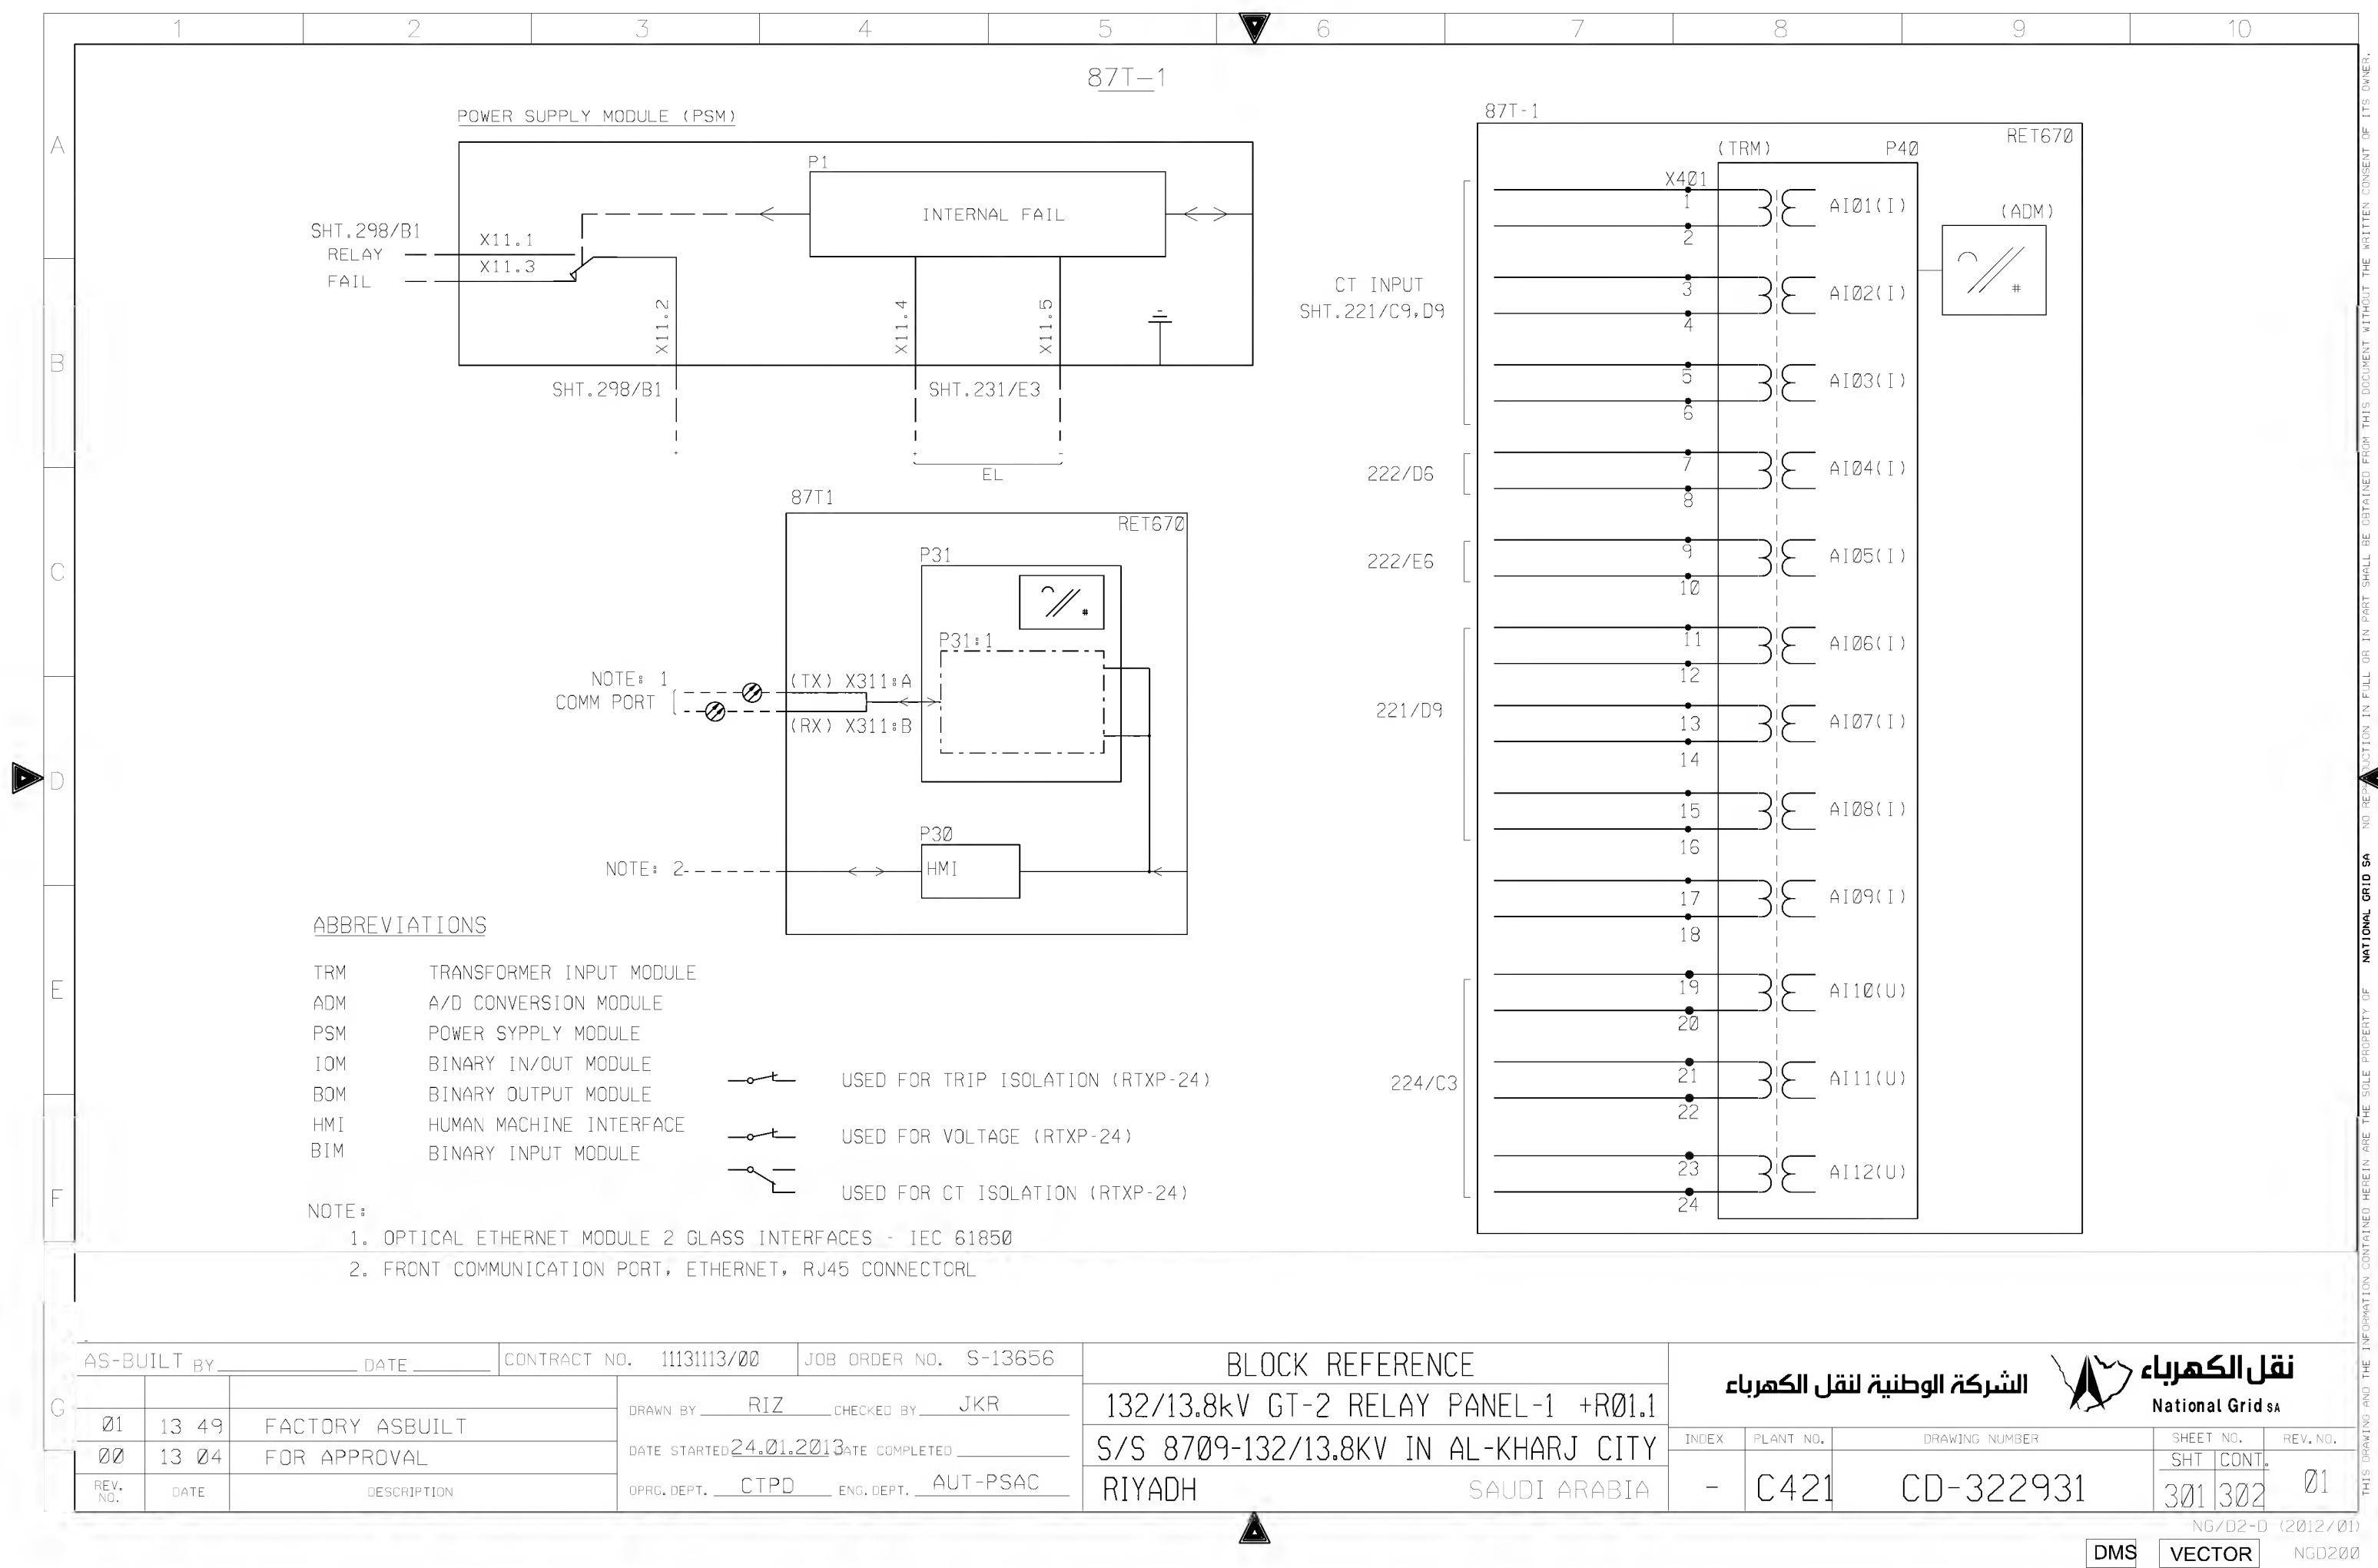

1

2

3

4

5

6

7

8

9

10

A

B

C

D

E

F

BINARY INPUT CARD

87T-1

BIM P3
RET670

LOCATION=P3

PLANT ADAPTED
CONFIGURATION

X31

1

BI.01

//

VT MCB FAIL

2

BI.02

//

SPARE

3

BI.03

//

SPARE

4

BI.04

//

SPARE

5

BI.05

//

SPARE

6

BI.06

//

SPARE

7

BI.07

//

CBF1 INITIATION

8

BI.08

//

SPARE

9

BI.09

//

SPARE

10

BI.10

//

SPARE

11

BI.11

//

SPARE

12

BI.12

//

SPARE

13

BI.13

//

SPARE

14

BI.14

//

SPARE

15

BI.15

//

SPARE

16

BI.16

//

SPARE

SHT.227/E3

SHT.228/E4

BINARY INPUT CARD

87T-1

BIM P5
RET670

LOCATION=P6

PLANT ADAPTED
CONFIGURATION

X51

1

BI.01

//

SPARE

2

BI.02

//

SPARE

3

BI.03

//

SPARE

4

BI.04

//

SPARE

5

BI.05

//

SPARE

6

BI.06

//

SPARE

7

BI.07

//

SPARE

8

BI.08

//

SPARE

9

BI.09

//

SPARE

10

BI.10

//

SPARE

11

BI.11

//

SPARE

12

BI.12

//

SPARE

13

BI.13

//

SPARE

14

BI.14

//

SPARE

15

BI.15

//

SPARE

16

BI.16

//

SPARE

SHT.228/E8

SHT.291/C9, C10


AS-BUILT BY _____ DATE _____ CONTRACT NO. 11131113/00 JOB ORDER NO. S-13656

01	13 49	FACTORY ASBUILT	DRAWN BY RIZ	CHECKED BY JKR
00	13 04	FOR APPROVAL	DATE STARTED 24.01.2013	DATE COMPLETED
REV. NO.	DATE	DESCRIPTION	OPRG. DEPT. CTPD	ENG. DEPT. AUT-PSAC

BLOCK REFERENCE	
132/13.8kV GT-2 RELAY PANEL-1 +R01.1	
S/S 8709-132/13.8KV IN AL-KHARJ CITY	
RIYADH	SAUDI ARABIA

الشركة الوطنية لنقل الكهرباء National Grid sa					
INDEX	PLANT NO.	DRAWING NUMBER	SHEET NO.		REV. NO.
-	C421	CD-322931	SHT 302	CONT. 303	01

NG/D2-D (2012/01)
DMS VECTOR NGD200

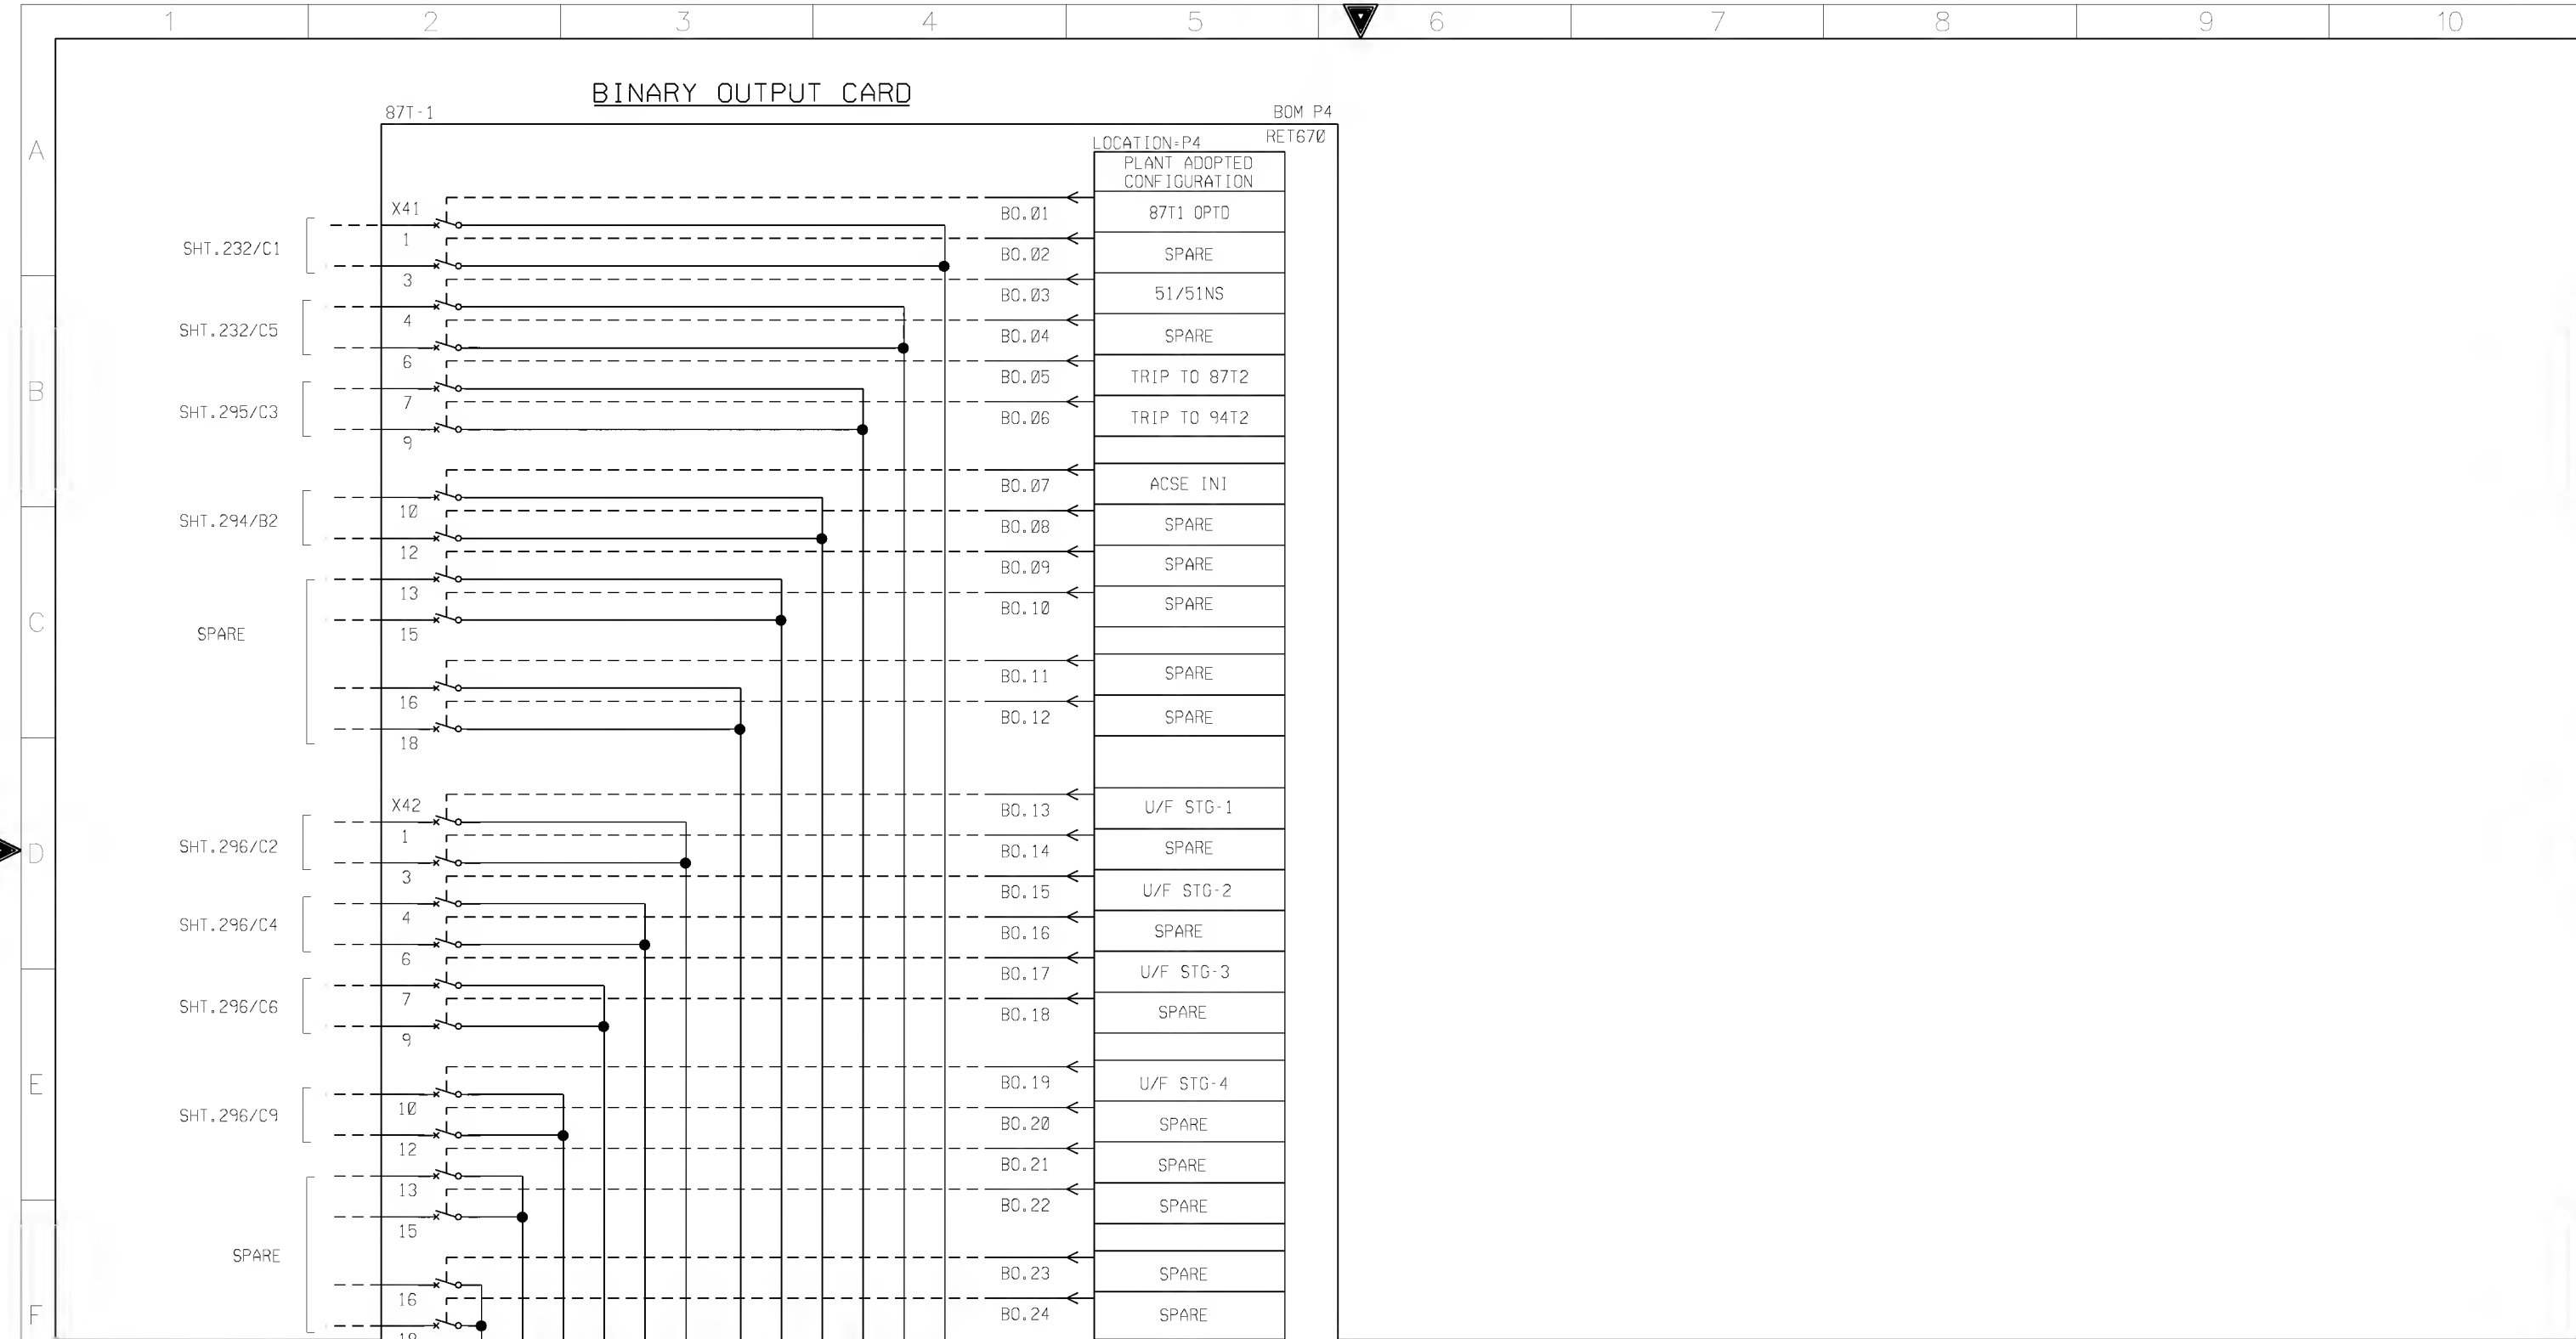

AS-BUILT BY _____ DATE _____ CONTRACT NO. 11131113/00 JOB ORDER NO. S-13656

BLOCK REFERENCE

132/13.8kV GT-2 RELAY PANEL-1 +R01.1

S/S 8709-132/13.8KV IN AL-KHARJ CITY

RIYADH SAUDI ARABIA

الشركة الوطنية لنقل الكهرباء


National Grid sa

INDEX	PLANT NO.	DRAWING NUMBER	SHEET NO.	REV. NO.
-	C421	CD-322931	303/304	01

NG/D2-D (2012/01)

DMS VECTOR

NGD200



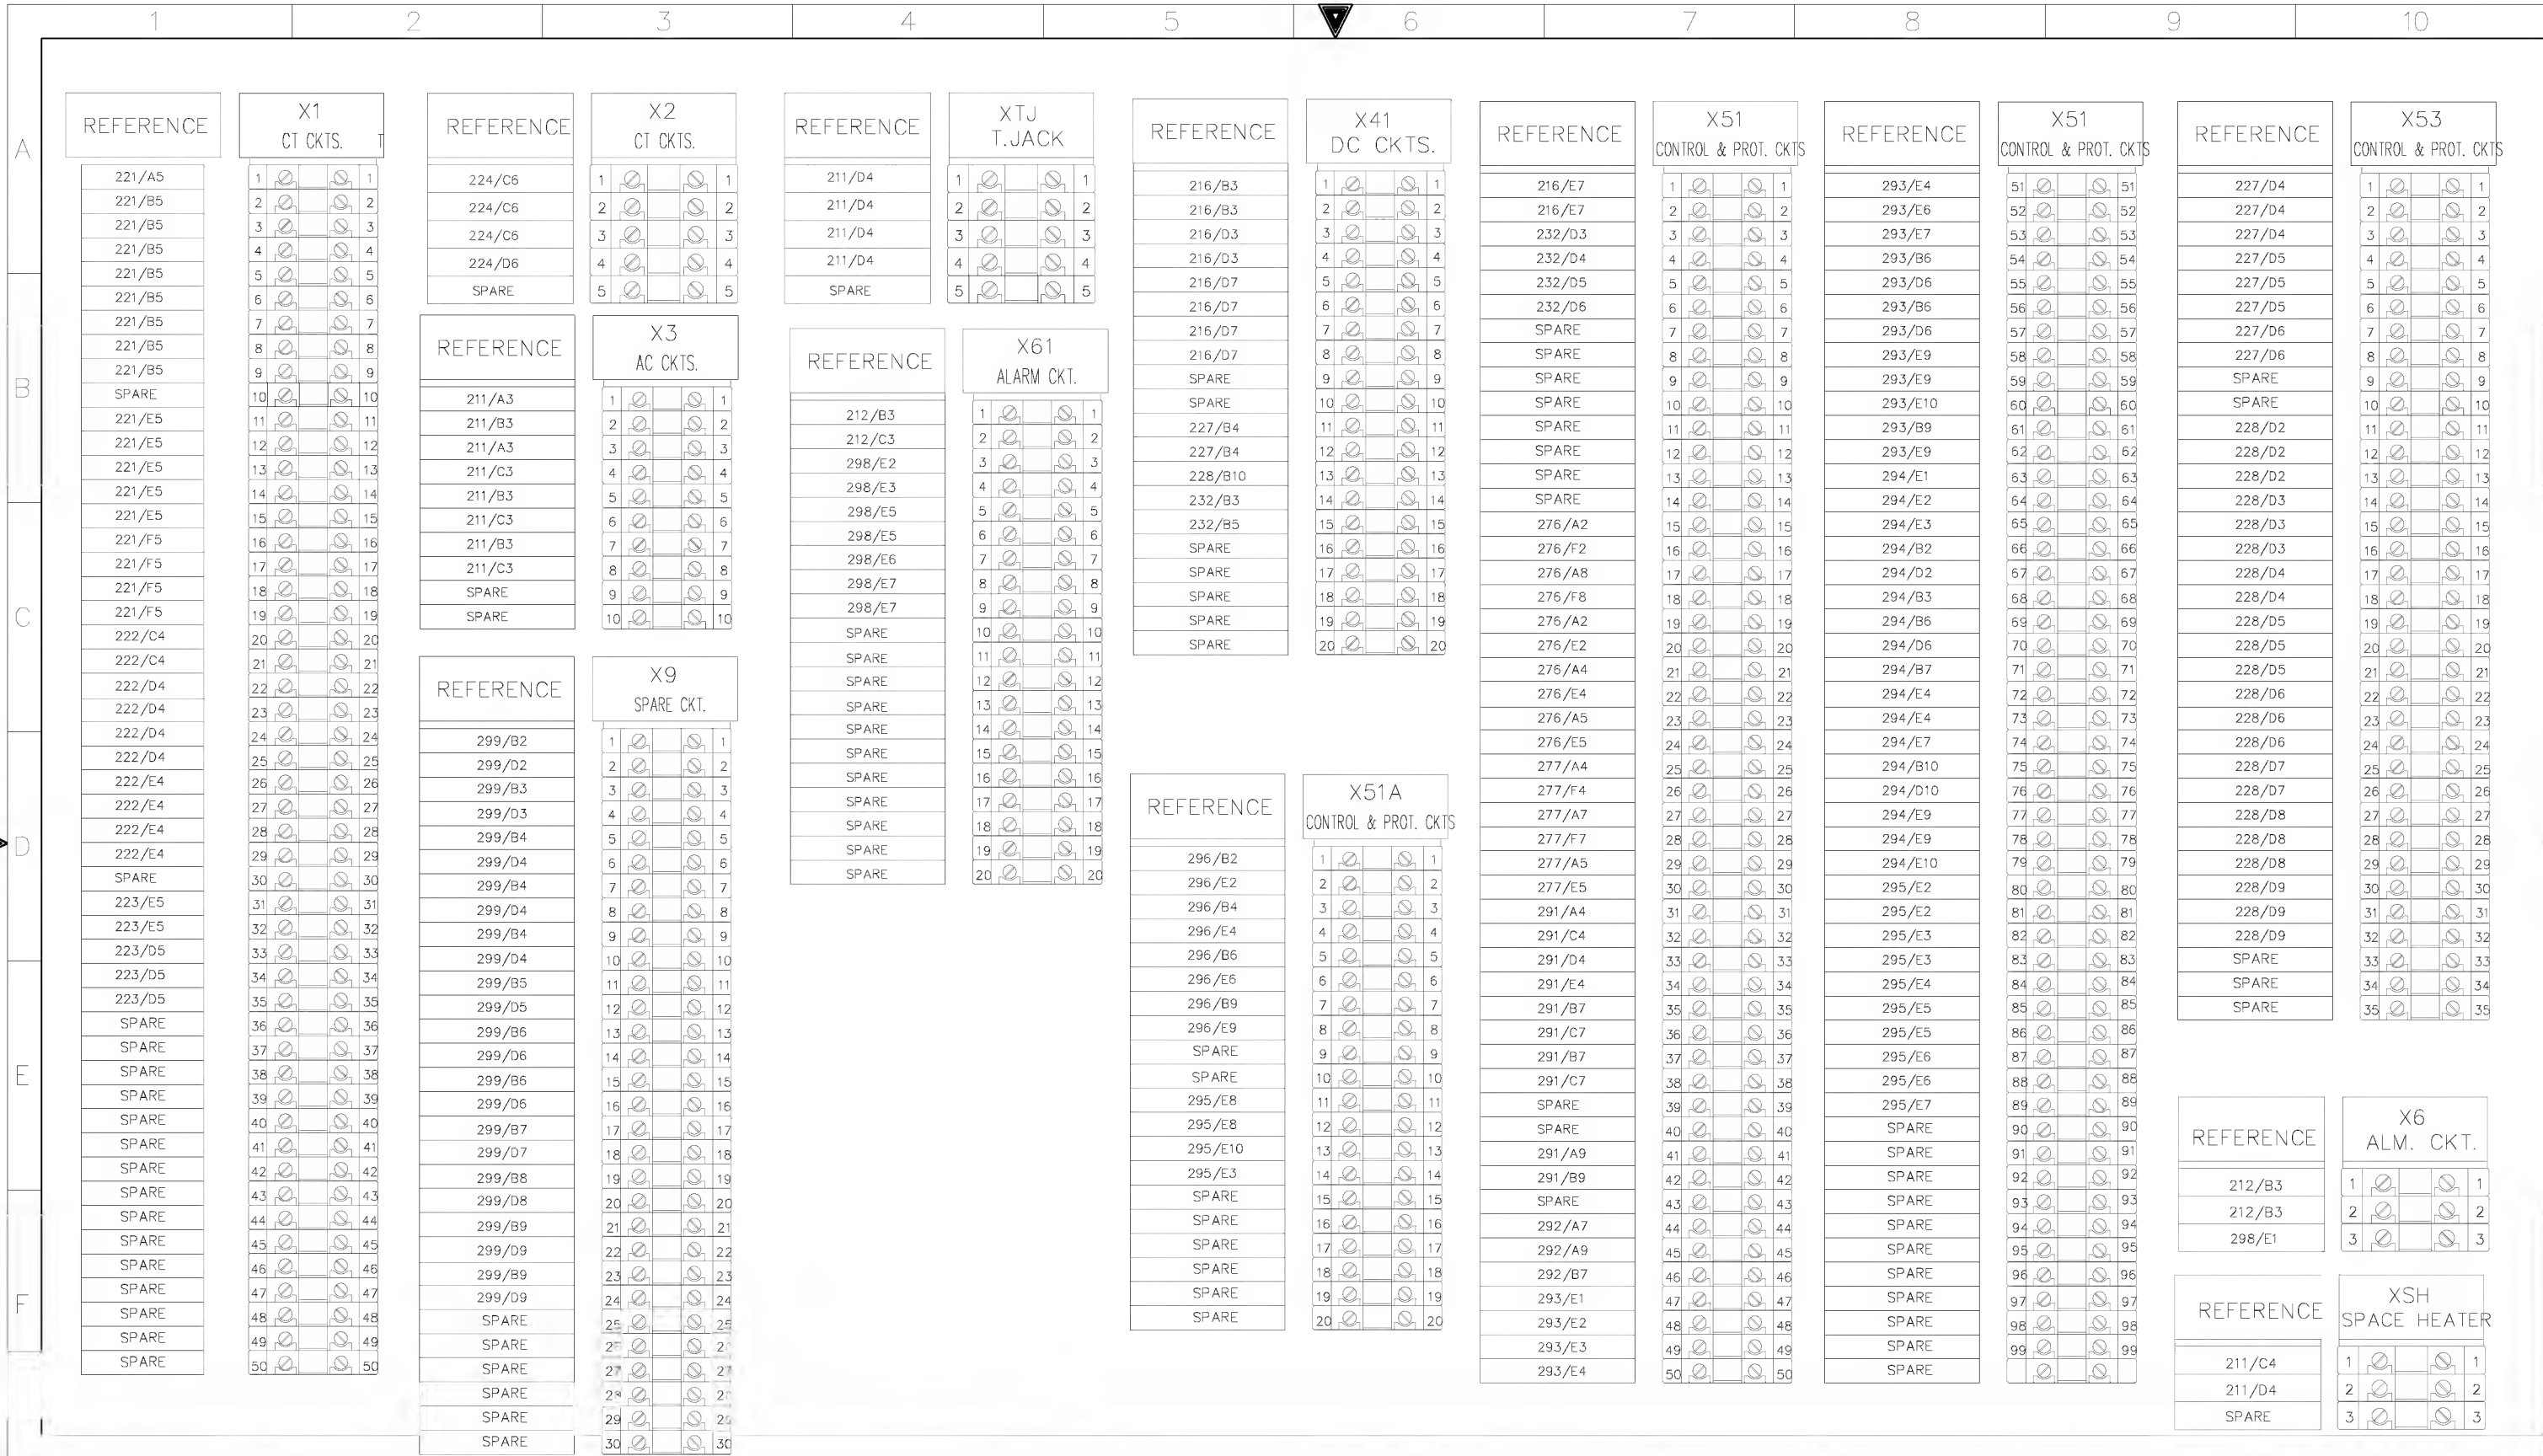


AS-BUILT BY _____ DATE _____ CONTRACT NO. 11131113/00 JOB ORDER NO. S-13656

01	13 49	FACTORY ASBUILT	DRAWN BY RIZ	CHECKED BY JKR
00	13 04	FOR APPROVAL	DATE STARTED 24.01.2013	DATE COMPLETED _____
REV. NO.	DATE	DESCRIPTION	OPRG. DEPT. CTPD	ENG. DEPT. AUT-PSAC

TERMINAL BLOCK REFERENCE
132/13.8kV GT-2 RELAY PANEL-1 +R01.1
S/S 8709-132/13.8KV IN AL-KHARJ CITY
RIYADH SAUDI ARABIA

الشركة الوطنية لنقل الكهرباء National Grid sa				
INDEX	PLANT NO.	DRAWING NUMBER	SHEET NO.	REV. NO.
-	C421	CD-322931	SHT 304	CONT. 411
			01	

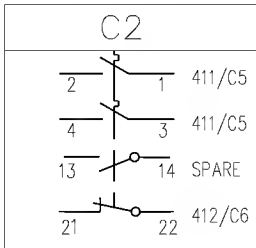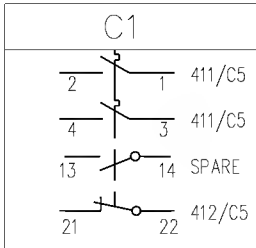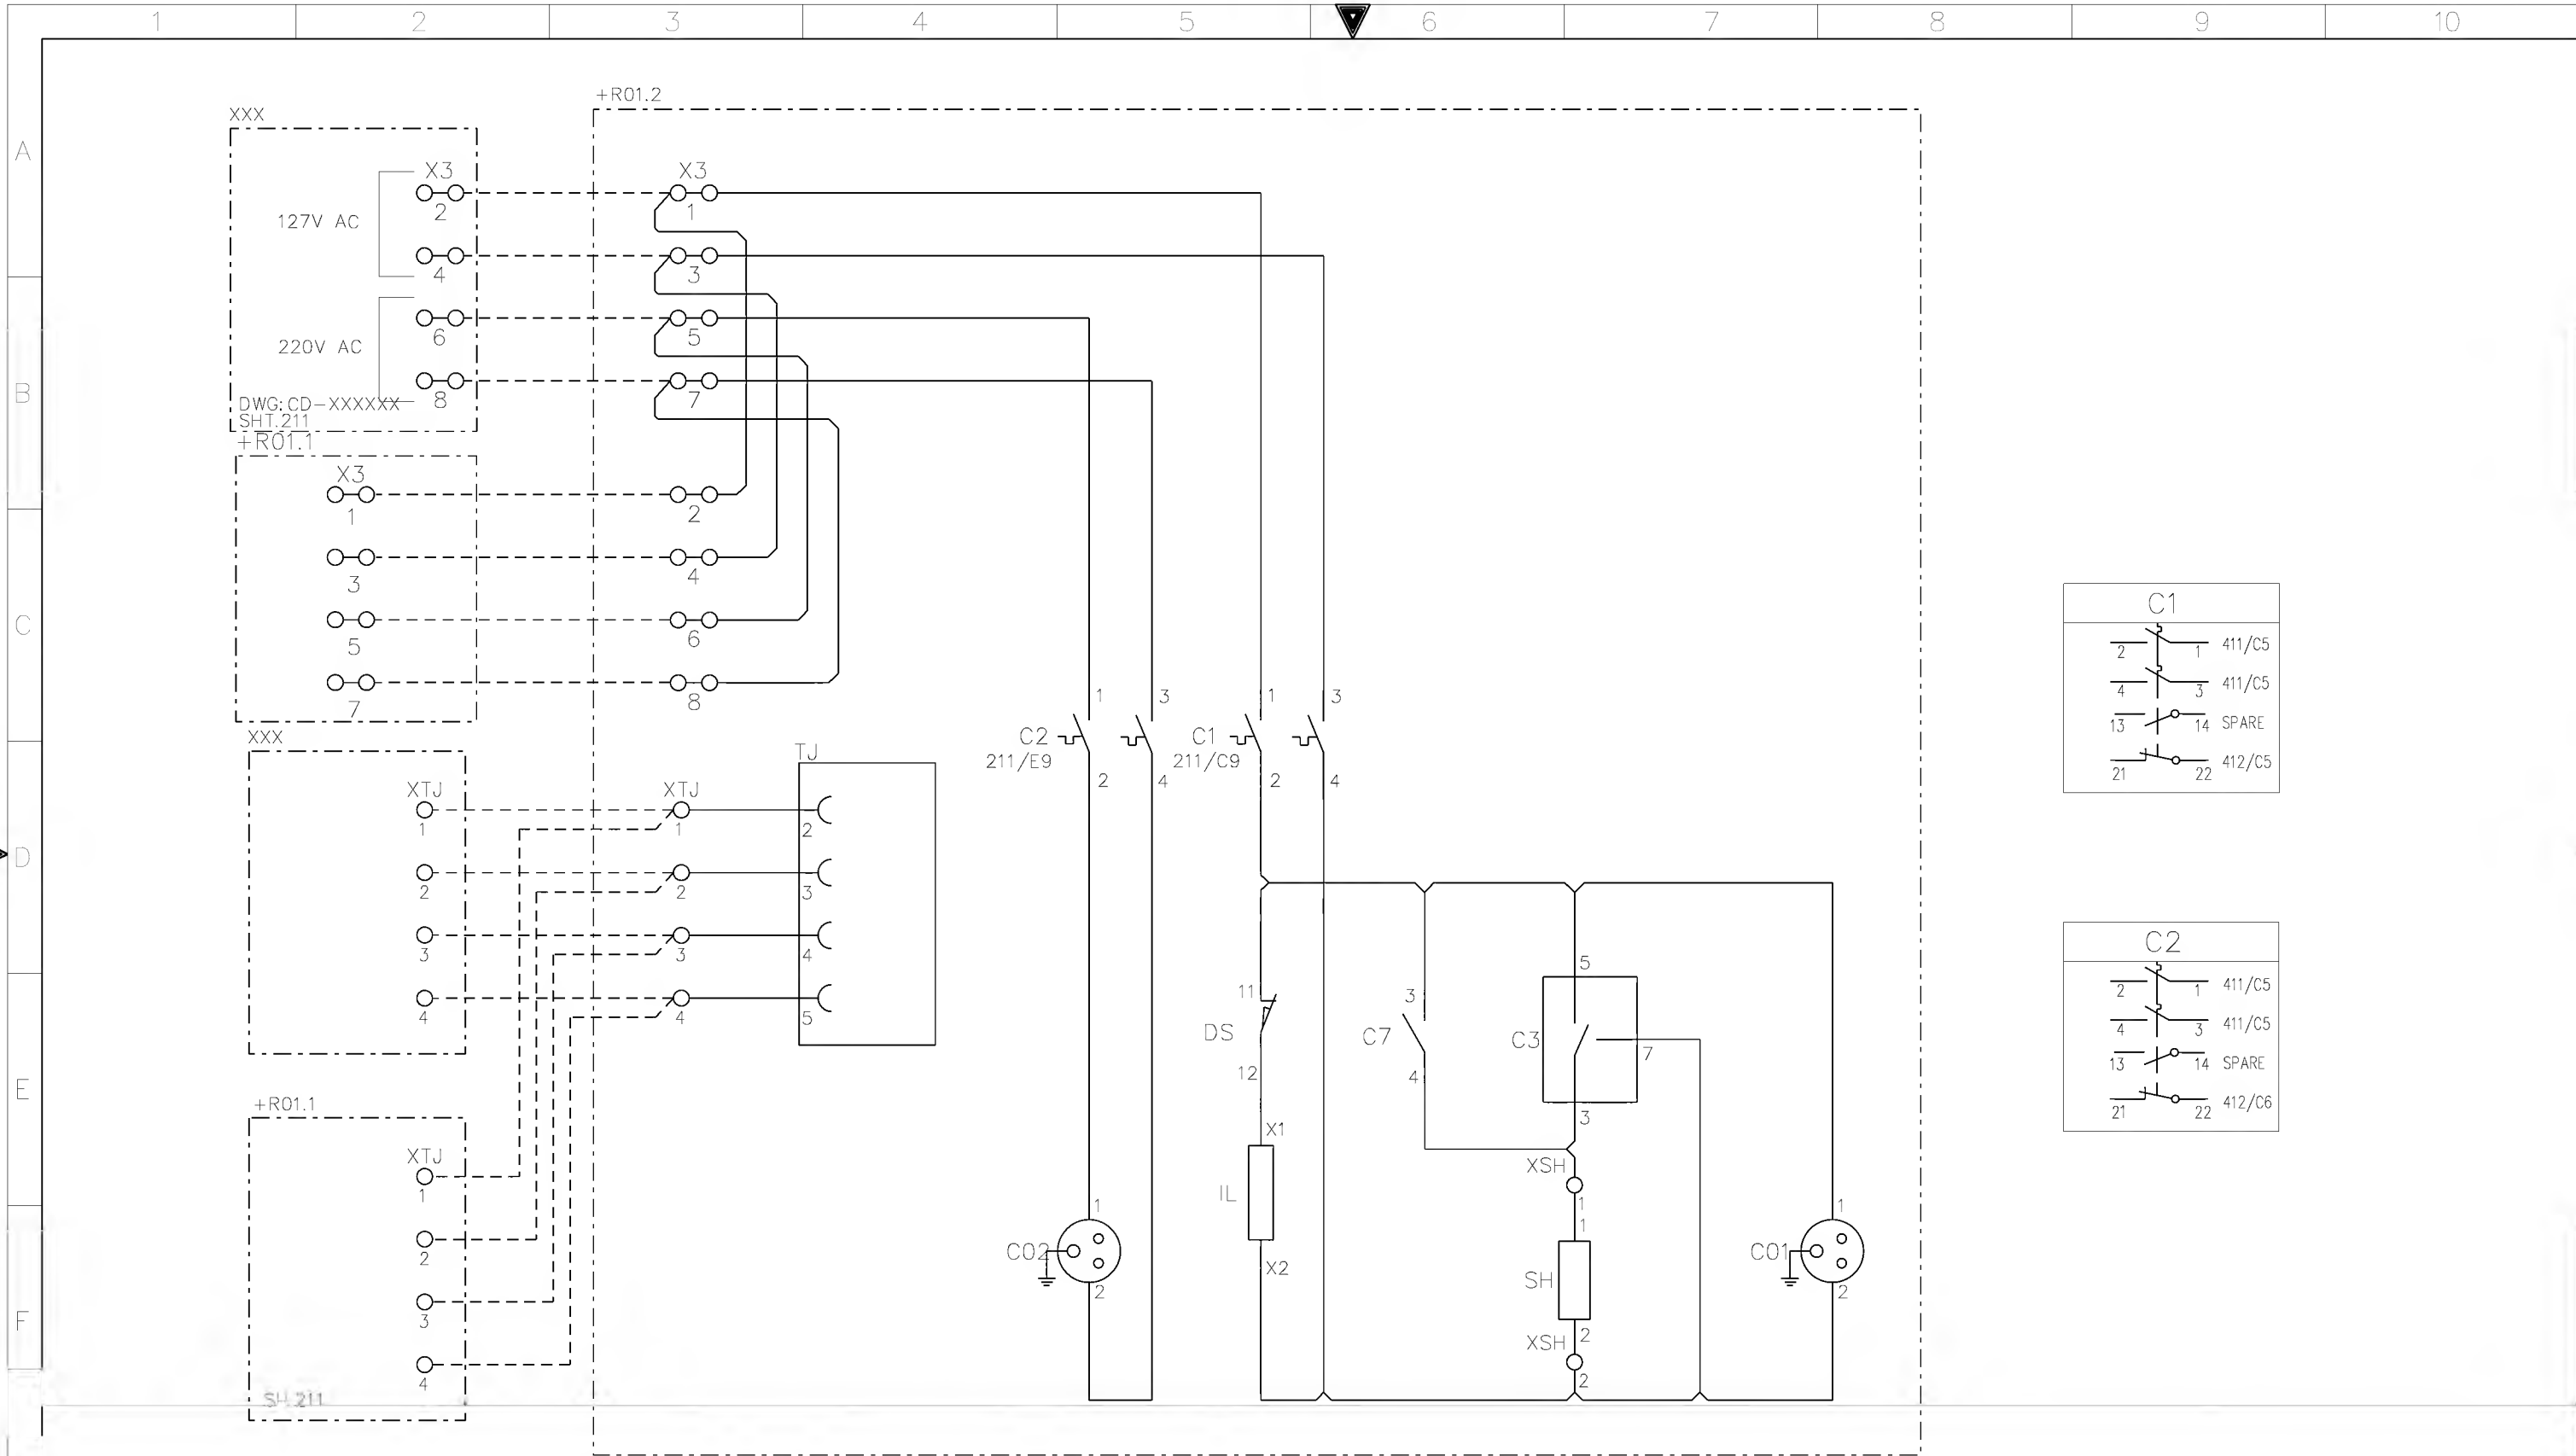


AS-BUILT BY _____ DATE _____			CONTRACT NO. 11131113/00		JOB ORDER NO. S-13656	
01	13 49	FACTORY ASBUILT	DRAWN BY RIZ		CHECKED BY JKR	
00	13 04	FOR APPROVAL	DATE STARTED 24.01.2013		DATE COMPLETED _____	
REV. NO.	DATE	DESCRIPTION	OPRG. DEPT. CTPD		ENG. DEPT. AUT-PSAC	

AC SUPPLY FOR ILLUMINATION & POWER SOCKET
132/13.8kV GT-2 RELAY PANEL-2 +R01.2
S/S 8709-132/13.8KV IN AL-KHARJ CITY
RIYADH SAUDI ARABIA

الشركة الوطنية لنقل الكهرباء				نقل الكهرباء	
				National Grid sa	
X	PLANT NO.	DRAWING NUMBER		SHEET NO.	
	C421	CD-322931		SHT	CONT.
				411	412
				01	

G

THIS DRAWING AND THE INFORMATION CONTAINED HEREIN ARE THE SOLE PROPERTY OF **NATIONAL GRID SA**. NO REPRODUCTION IN FULL OR IN PART SHALL BE OBTAINED FROM THIS DOCUMENT WITHOUT THE WRITTEN CONSENT OF ITS OWNER,

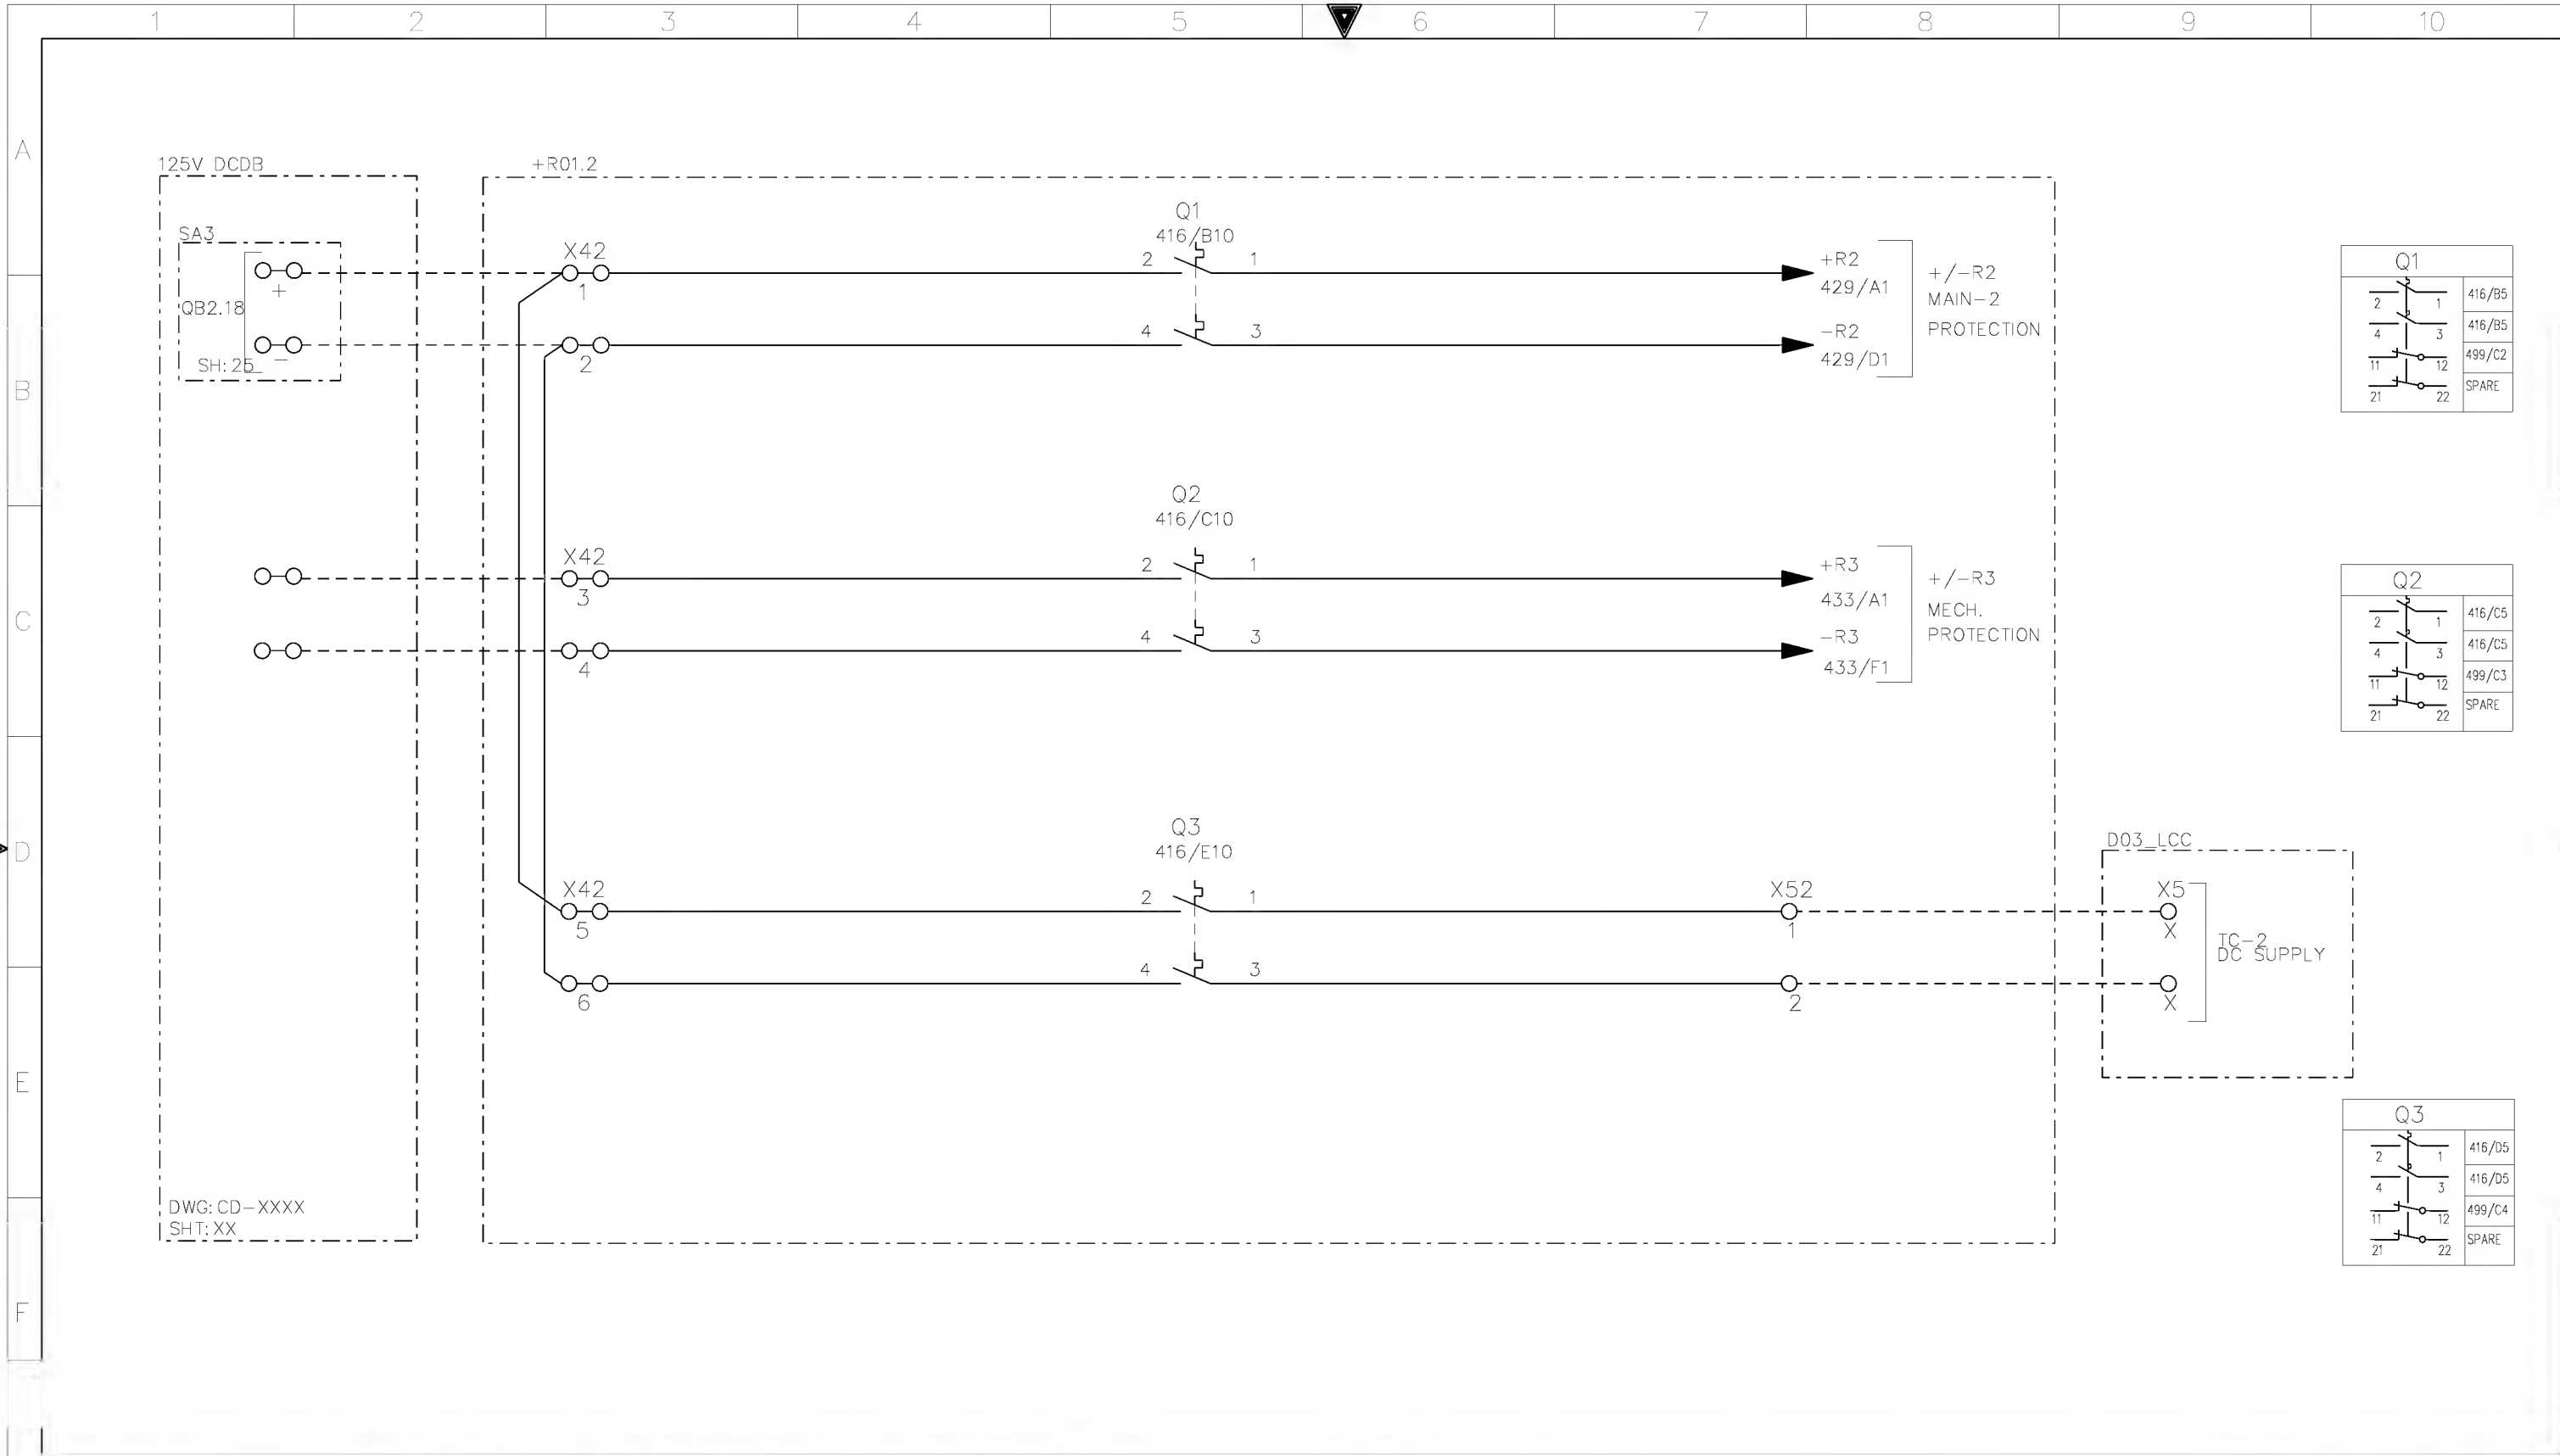

AS-BUILT BY _____ DATE _____ CONTRACT NO. 11131113/00 JOB ORDER NO. S-13656

01	13 49	FACTORY ASBUILT
00	13 04	FOR APPROVAL
REV. NO.	DATE	DESCRIPTION

DRAWN BY	RIZ	CHECKED BY	JKR
DATE STARTED	24.01.2013	DATE COMPLETED	
OPRG. DEPT.	CTPD	ENG. DEPT.	AUT-PSAC


DC SUPPLY DISTRIBUTION

132/13.8kV GT-2 RELAY PANEL-2 +R01.2

S/S 8709-132/13.8KV IN AL-KHARJ CITY

RIYADH SAUDI ARABIA


الشركة الوطنية لنقل الكهرباء				
National Grid sa				
INDEX	PLANT NO.	DRAWING NUMBER	SHEET NO.	
-	C421	CD-322931	SHT	CONT.
-	C421	CD-322931	416	421
				REV. NO.
				01

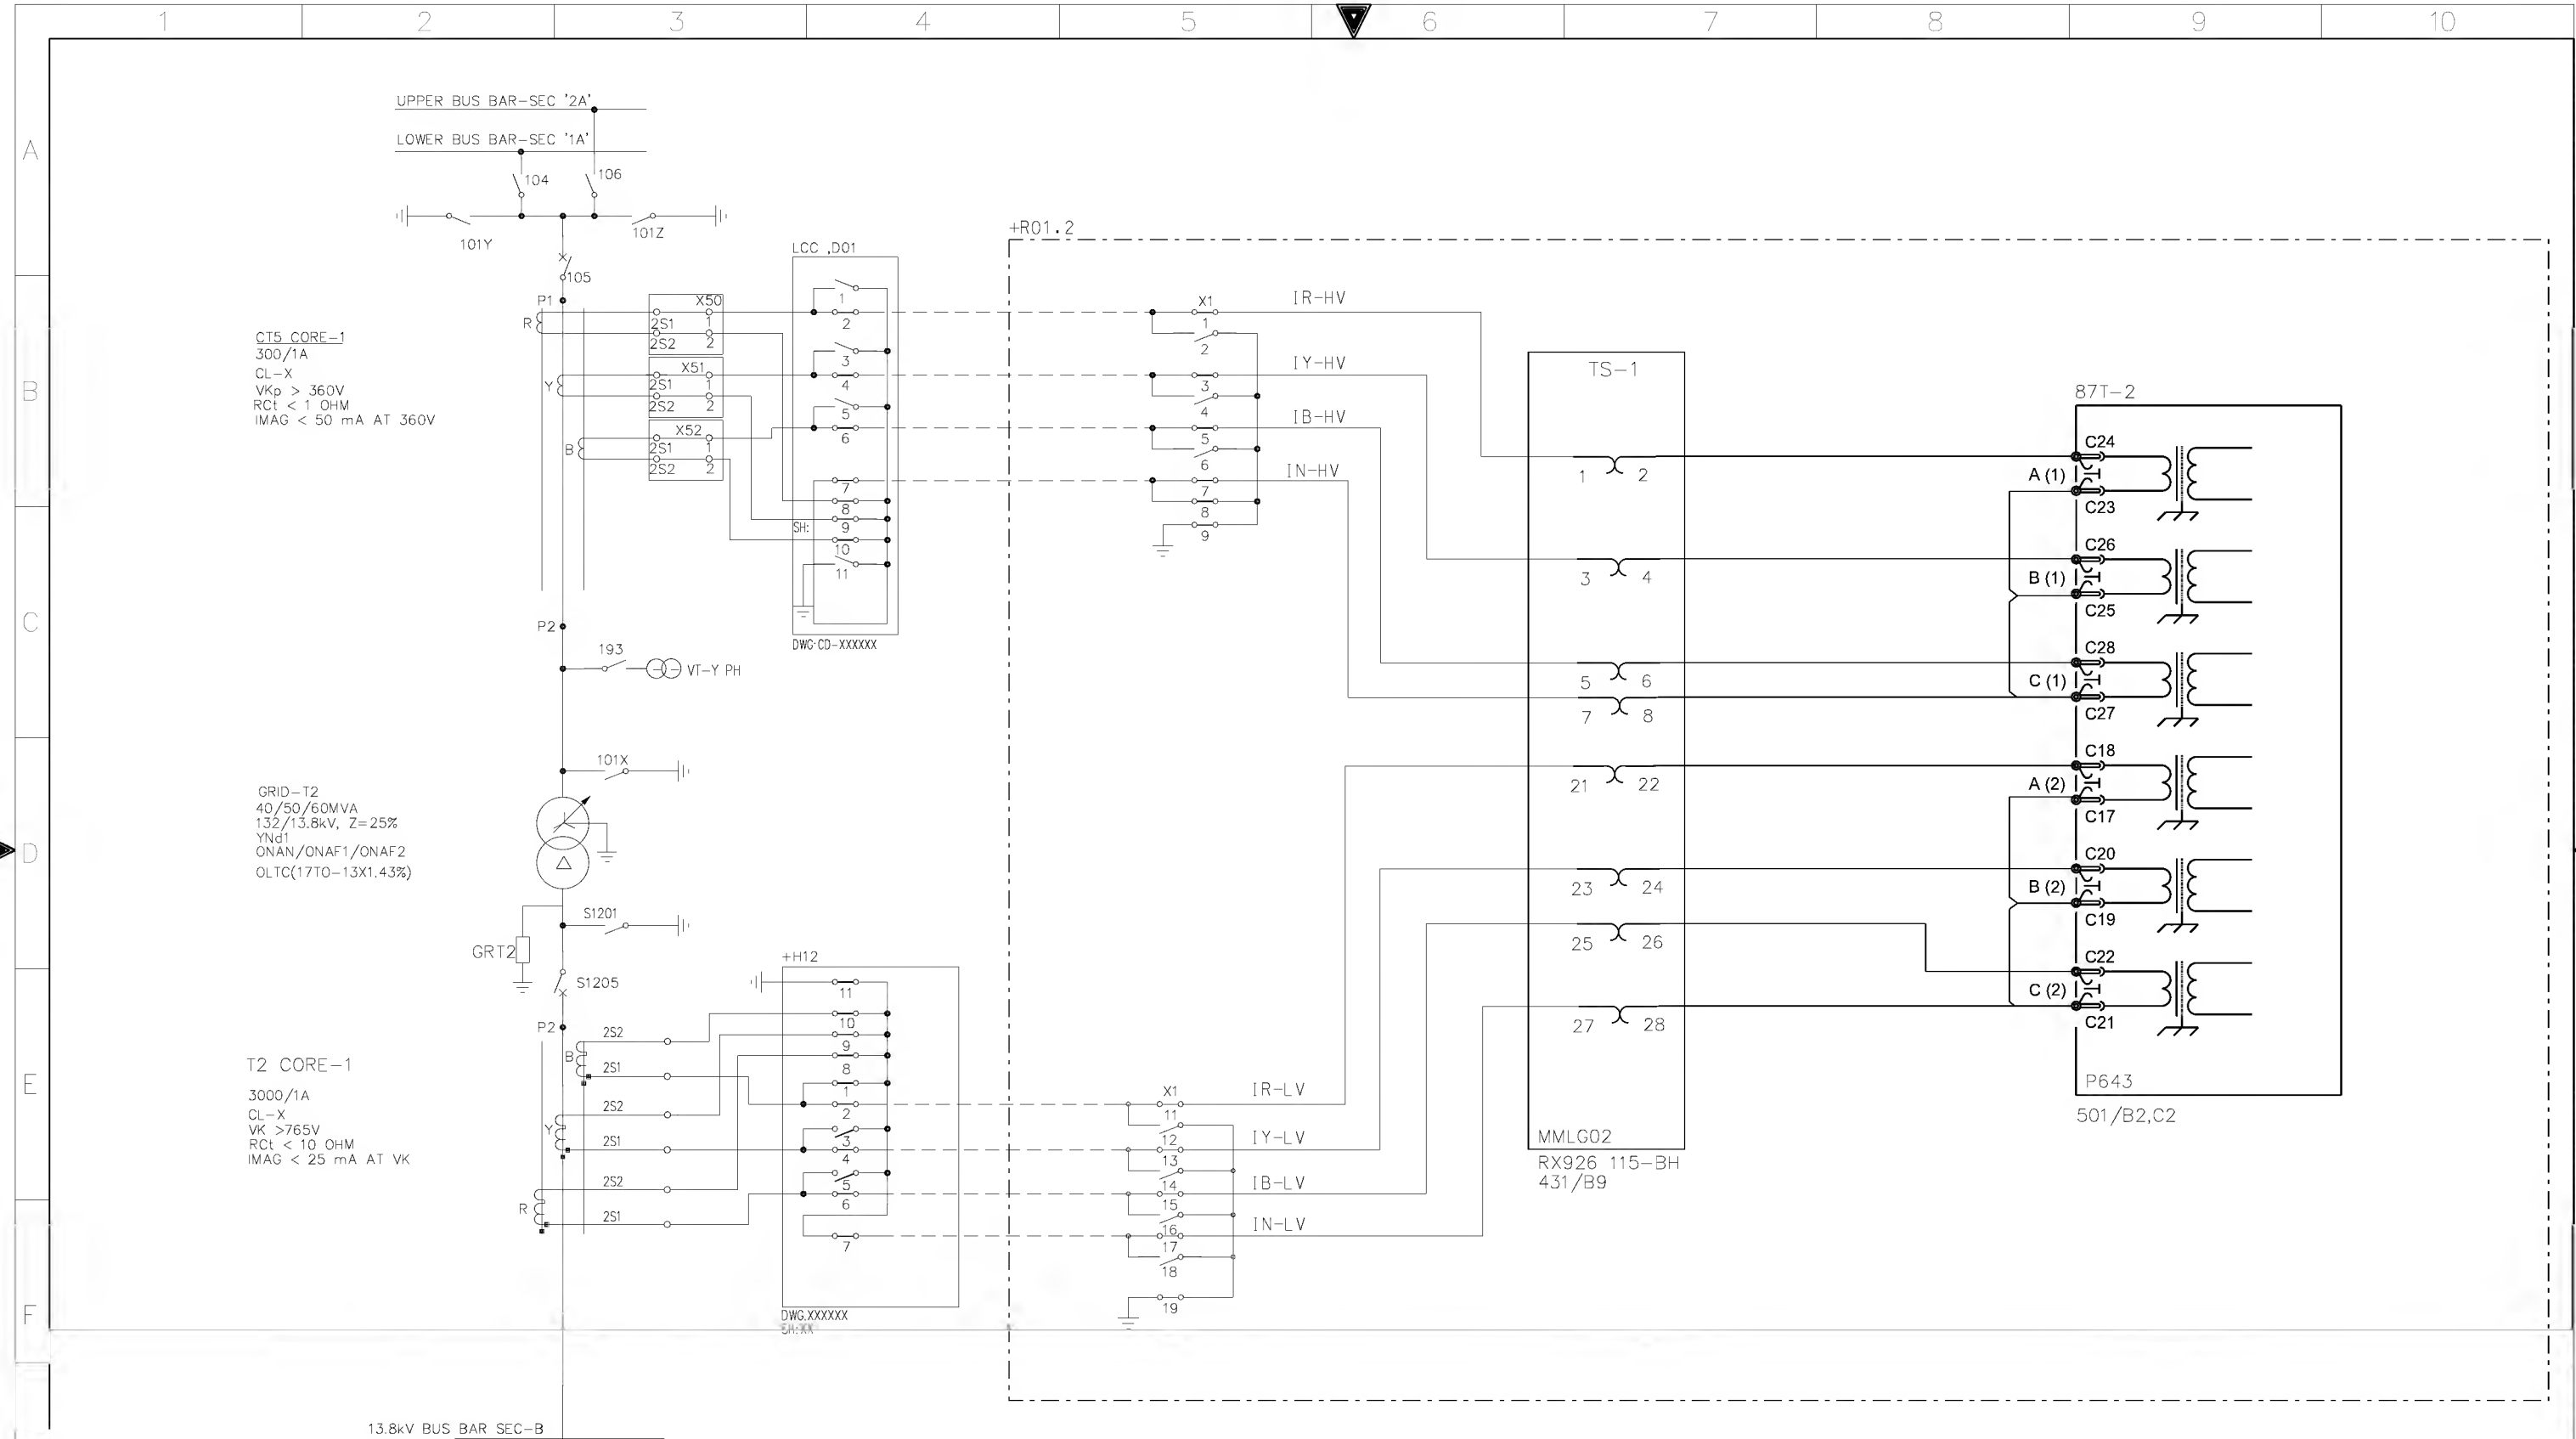

AS-BUILT BY _____ DATE _____			CONTRACT NO. 11131113/00		JOB ORDER NO. S-13656	
01	13 49	FACTORY ASBUILT	DRAWN BY RIZ		CHECKED BY JKR	
00	13 04	FOR APPROVAL	DATE STARTED 24.01.2013		DATE COMPLETED _____	
REV. NO.	DATE	DESCRIPTION	OPRG. DEPT. CTPD		ENG. DEPT. AUT-PSAC	

CT CIRCUITS 87T-2 RELAY	
132/13.8kV GT-2 RELAY PANEL-2 +R01.2	
S/S 8709-132/13.8KV IN AL-KHARJ CITY	
RIYADH SAUDI ARABIA	

الشركة الوطنية لنقل الكهرباء				نقل الكهرباء	
				National Grid SA	
INDEX	PLANT NO.	DRAWING NUMBER	SHEET NO.		REV. NO.
-	C421	CD-322931	SHT	CONT.	01
			421	422	

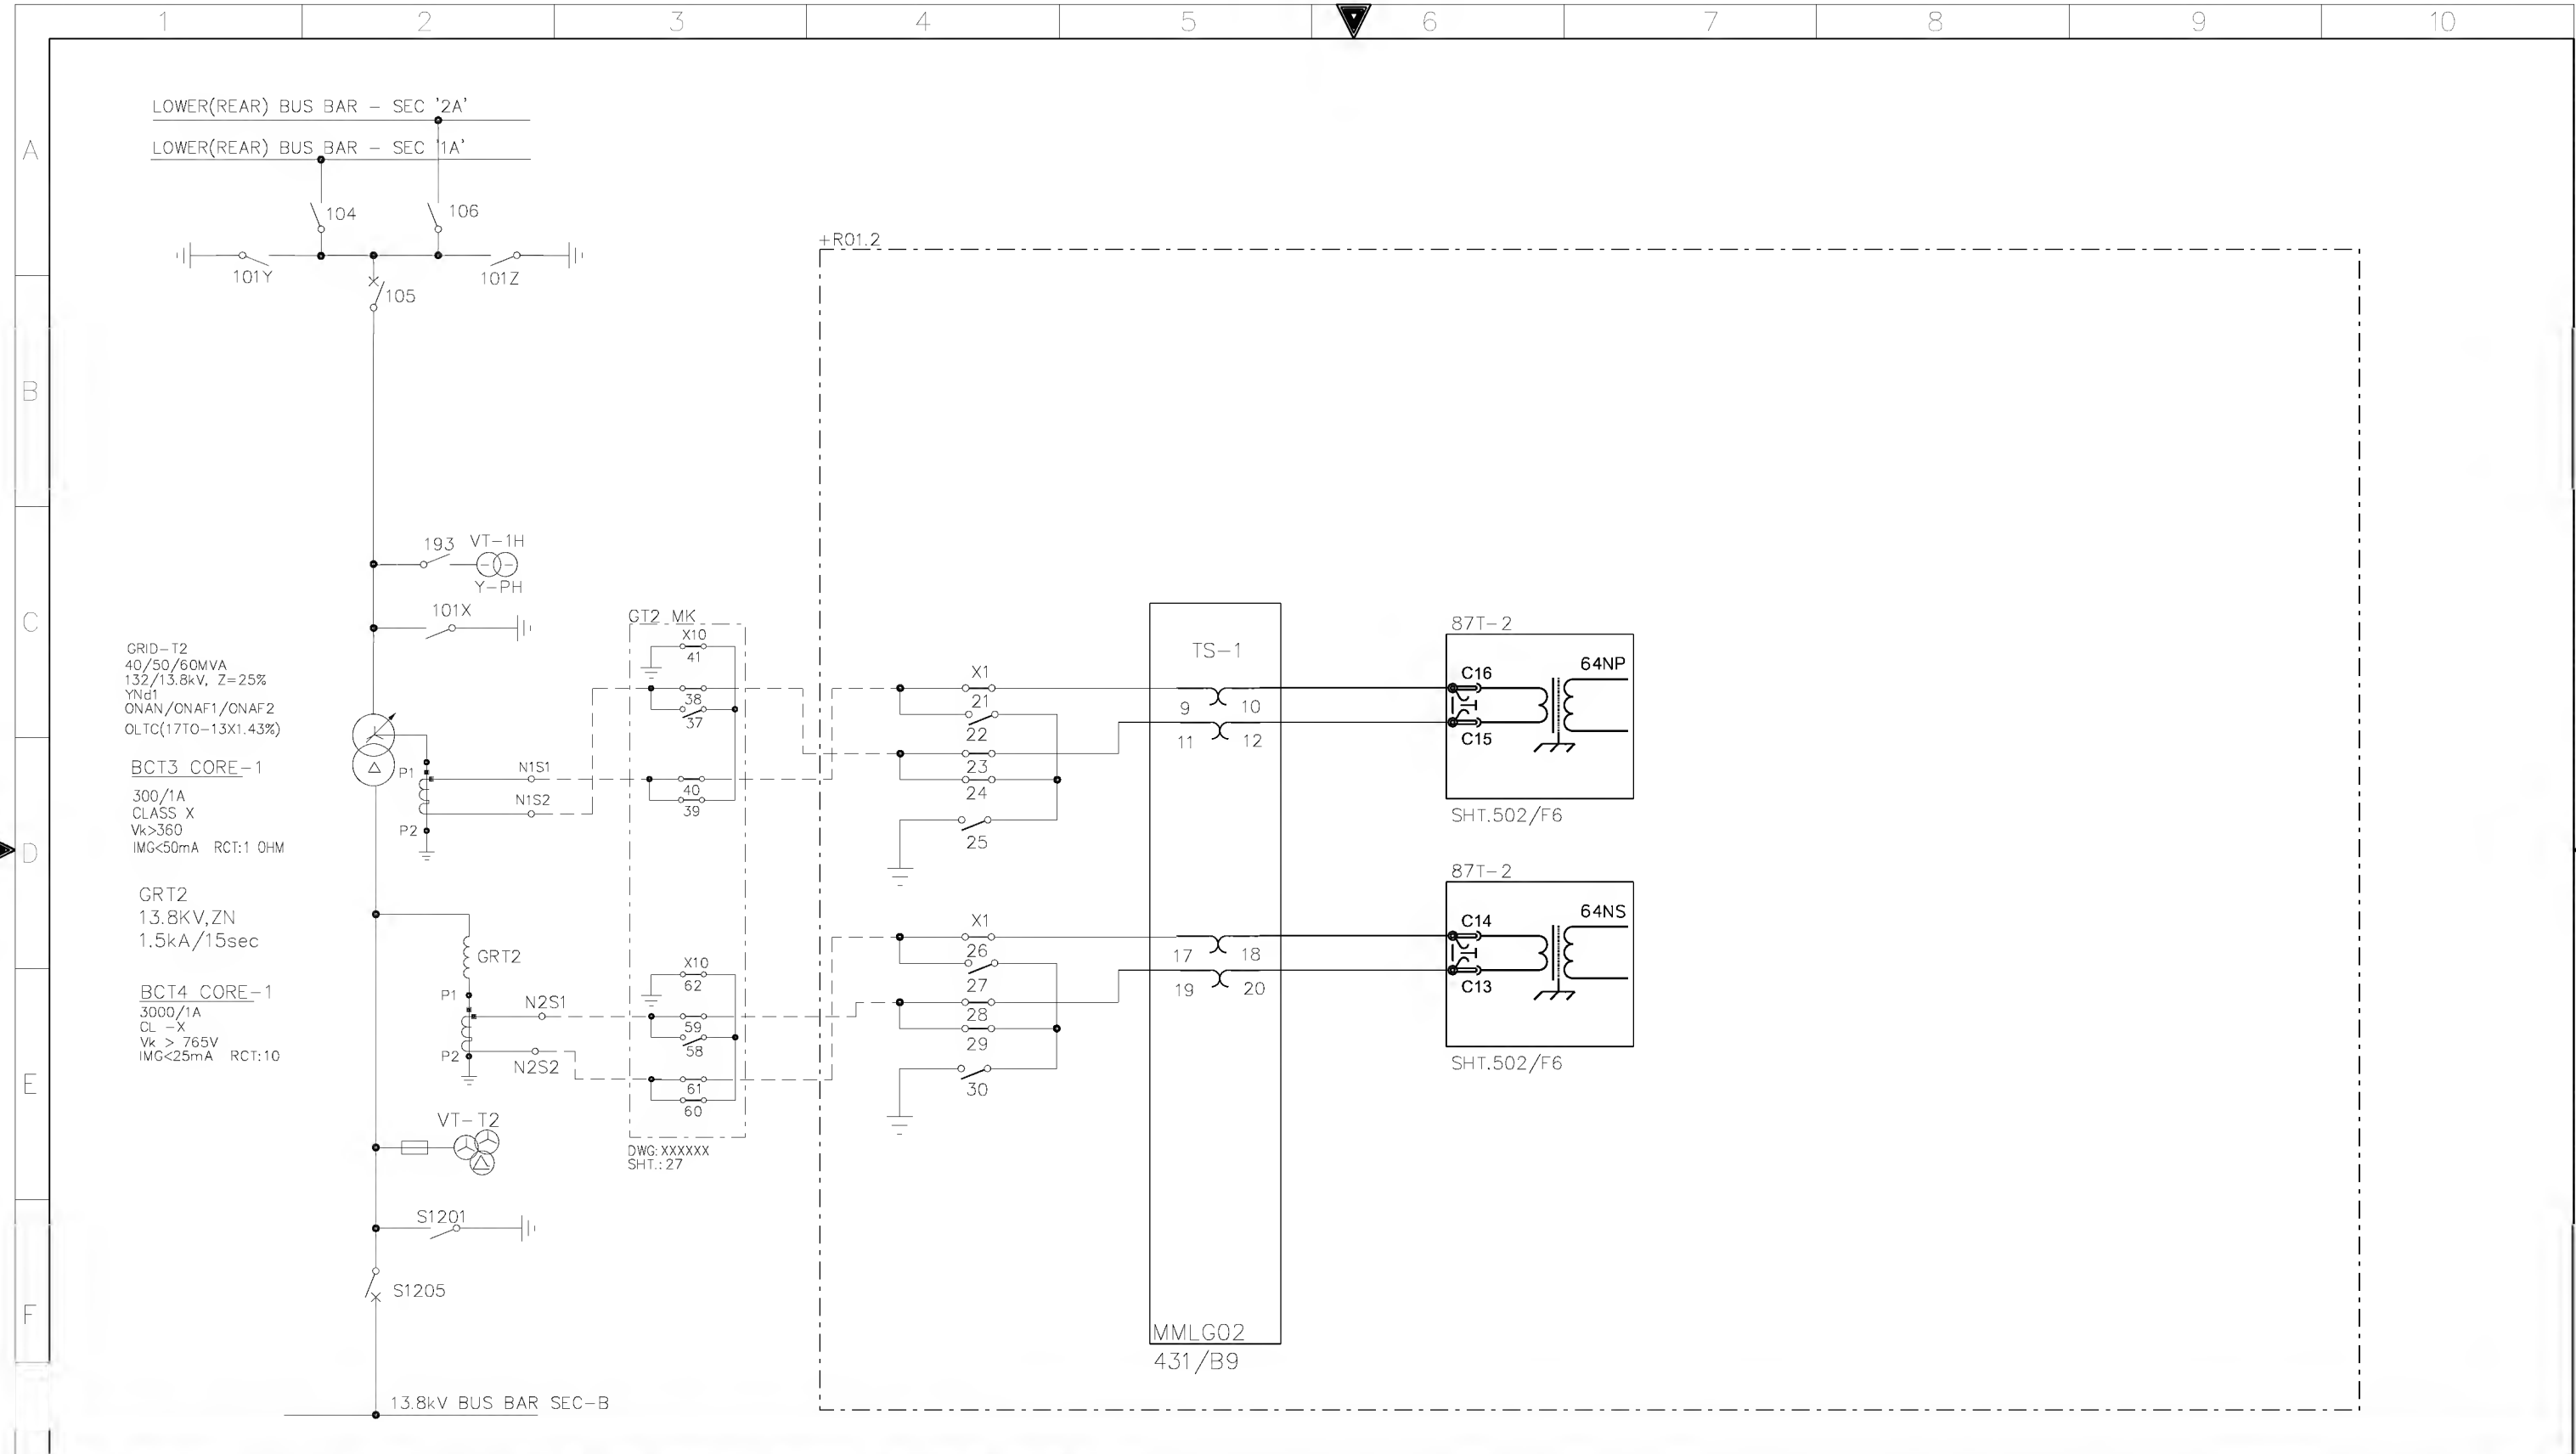

AS-BUILT BY _____ DATE _____ CONTRACT NO. 11131113/00 JOB ORDER NO. S-13656

01	13 49	FACTORY ASBUILT
00	13 04	FOR APPROVAL
REV. NO.	DATE	DESCRIPTION

DRAWN BY RIZ CHECKED BY JKR

DATE STARTED 24.01.2013 DATE COMPLETED _____

OPRG. DEPT. CTPD ENG. DEPT. AUT-PSAC


CT CIRCUITS 87T-2 RELAY

132/13.8kV GT-2 RELAY PANEL-2 +R01.2


S/S 8709-132/13.8KV IN AL-KHARJ CITY

RIYADH SAUDI ARABIA

الشركة الوطنية لنقل الكهرباء National Grid sa				
INDEX	PLANT NO.	DRAWING NUMBER	SHEET NO.	REV. NO.
-	C421	CD-322931	SHT 422	CONT. 423
			01	

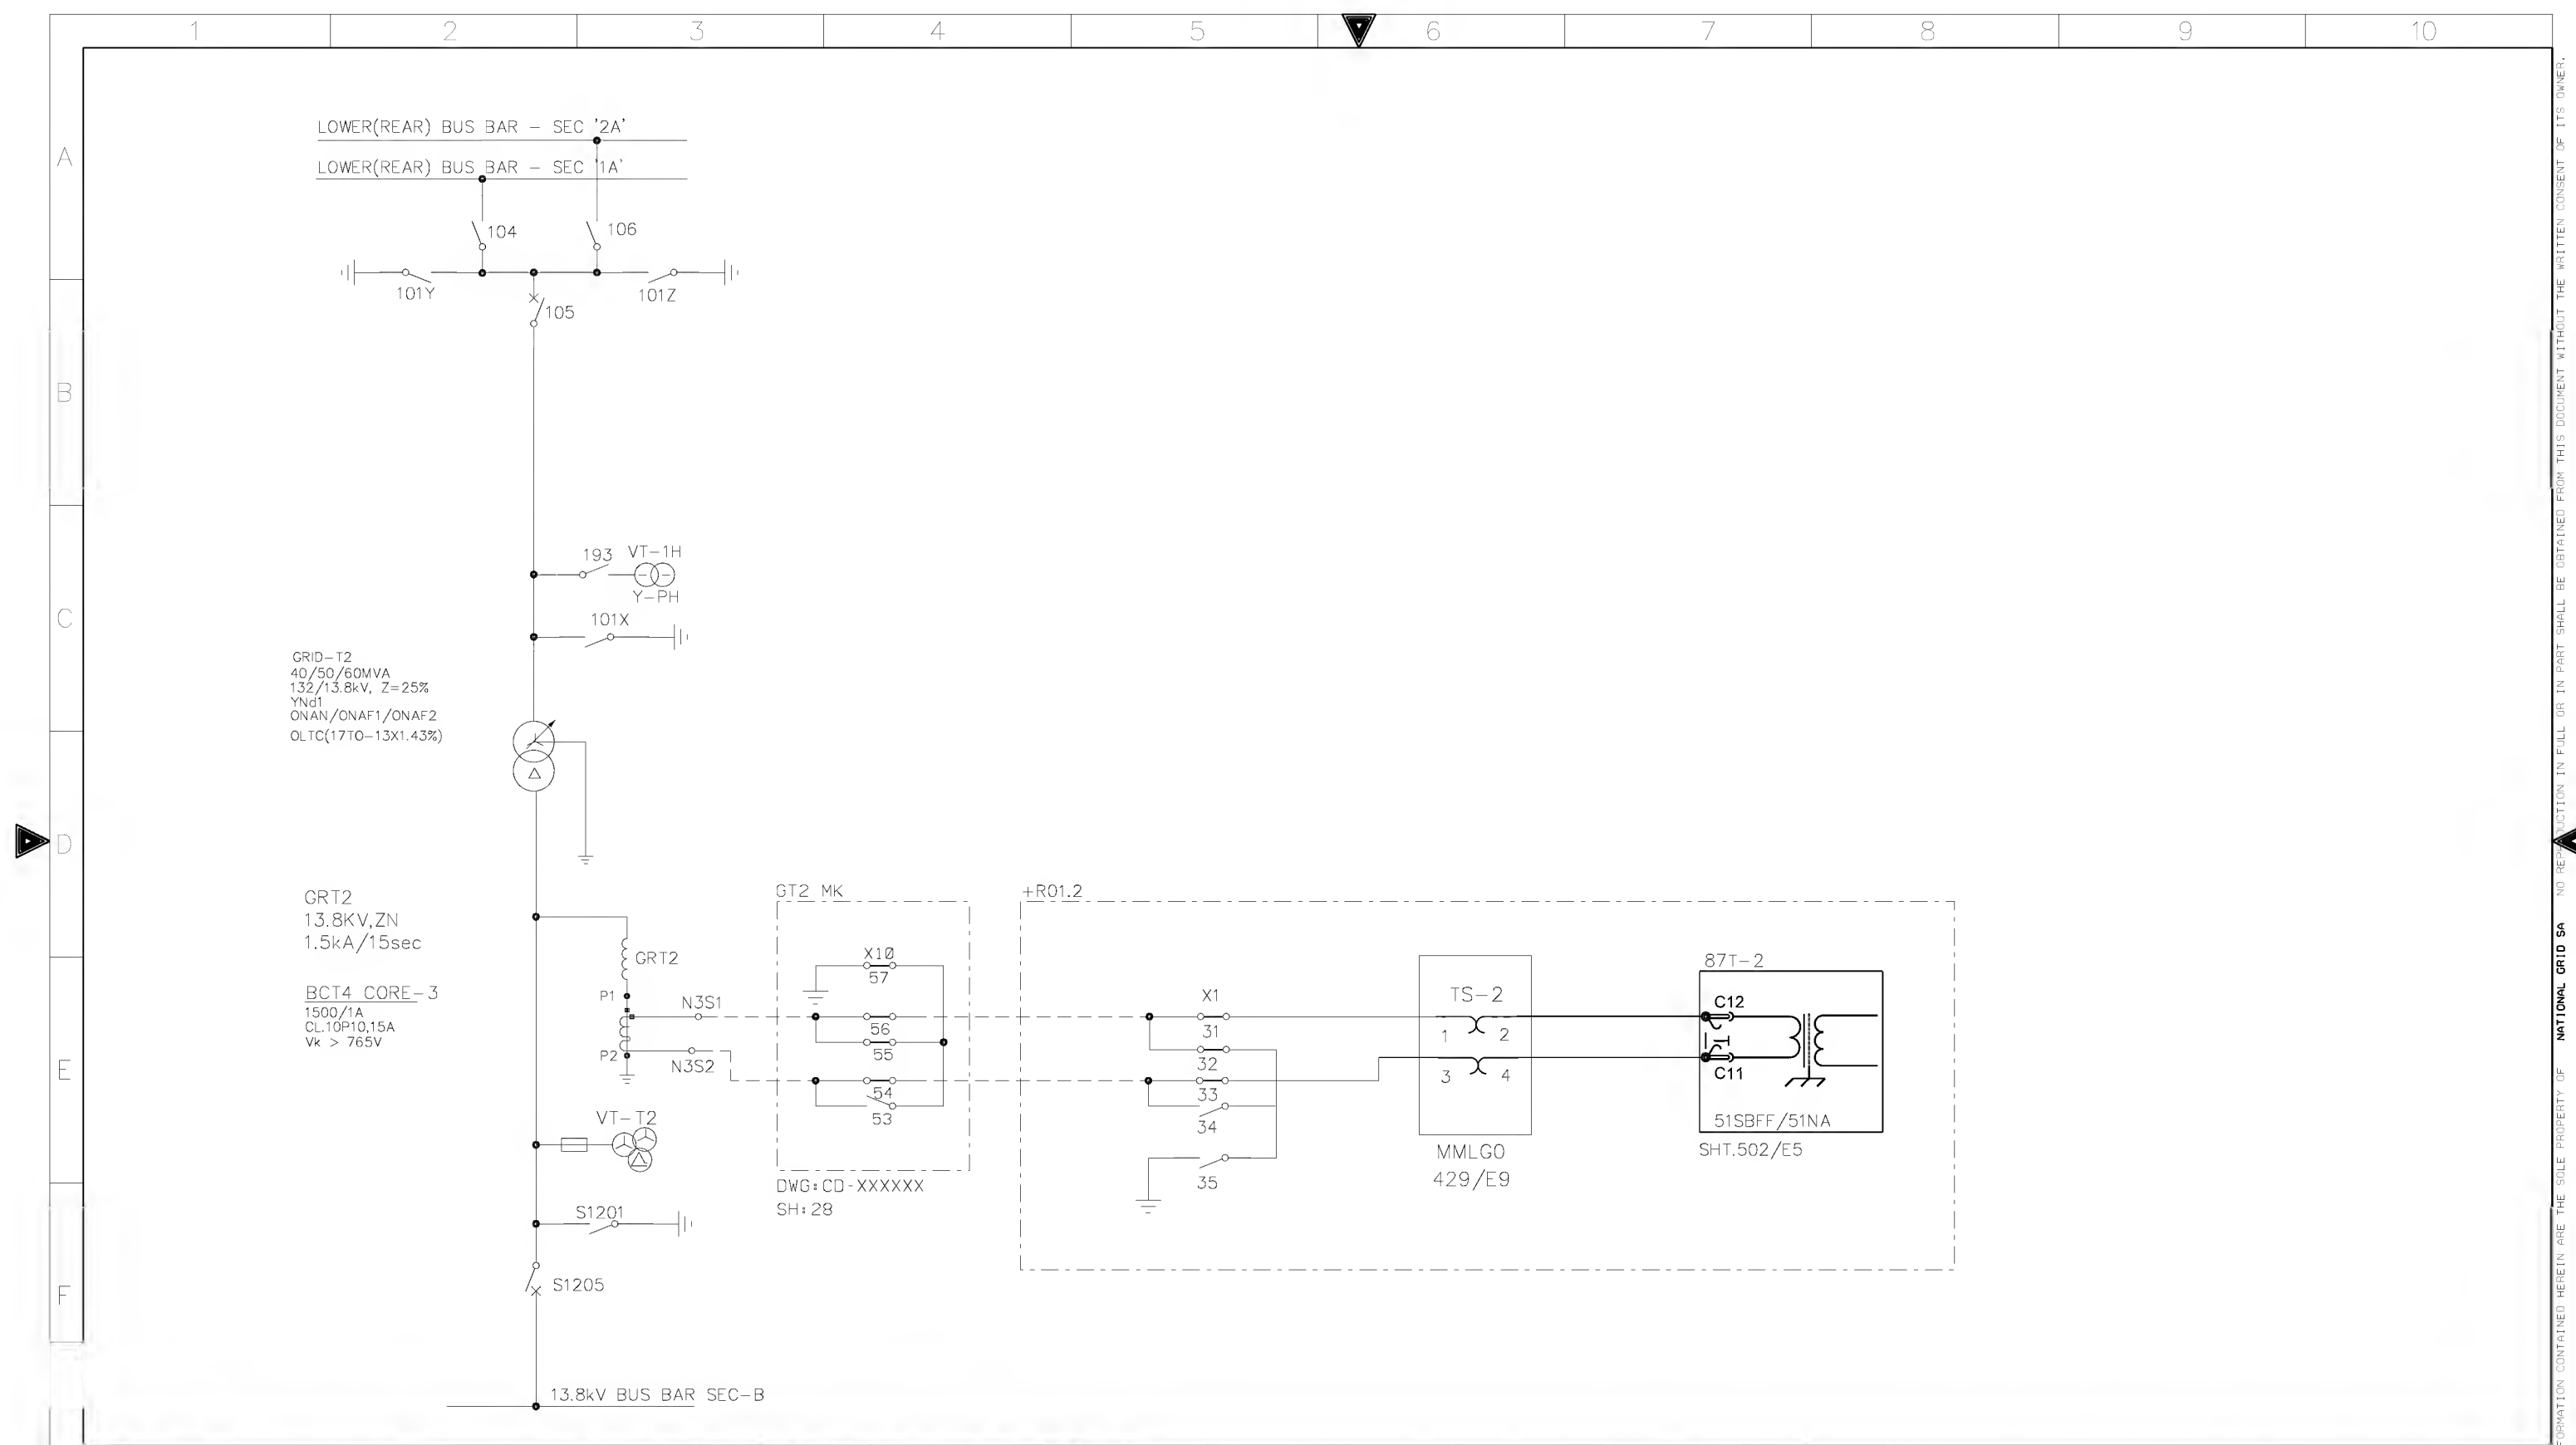


AS-BUILT BY _____ DATE _____			CONTRACT NO. 11131113/00		JOB ORDER NO. S-13656		CT CIRCUITS 87T-2 RELAY		<div>الشركة الوطنية لنقل الكهرباء</div> <div>نقل الكهرباء</div> <div>National Grid sa</div>				
			DRAWN BY _____ RIZ _____ CHECKED BY _____ JKR		132/13.8kV GT-2 RELAY PANEL-2 +R01.2								
01 13 49 FACTORY ASBUILT			DATE STARTED 24.01.2013 DATE COMPLETED _____		S/S 8709-132/13.8KV IN AL-KHARJ CITY		INDEX	PLANT NO.	DRAWING NUMBER		SHEET NO.		REV. NO.
00 13 04 FOR APPROVAL			OPRG. DEPT. _____ CTPD _____ ENG. DEPT. _____ AUT-PSAC		RIYADH SAUDI ARABIA		-	C421	CD-322931		SHT	CONT.	01
REV. NO. _____ DATE _____ DESCRIPTION _____											423	424	

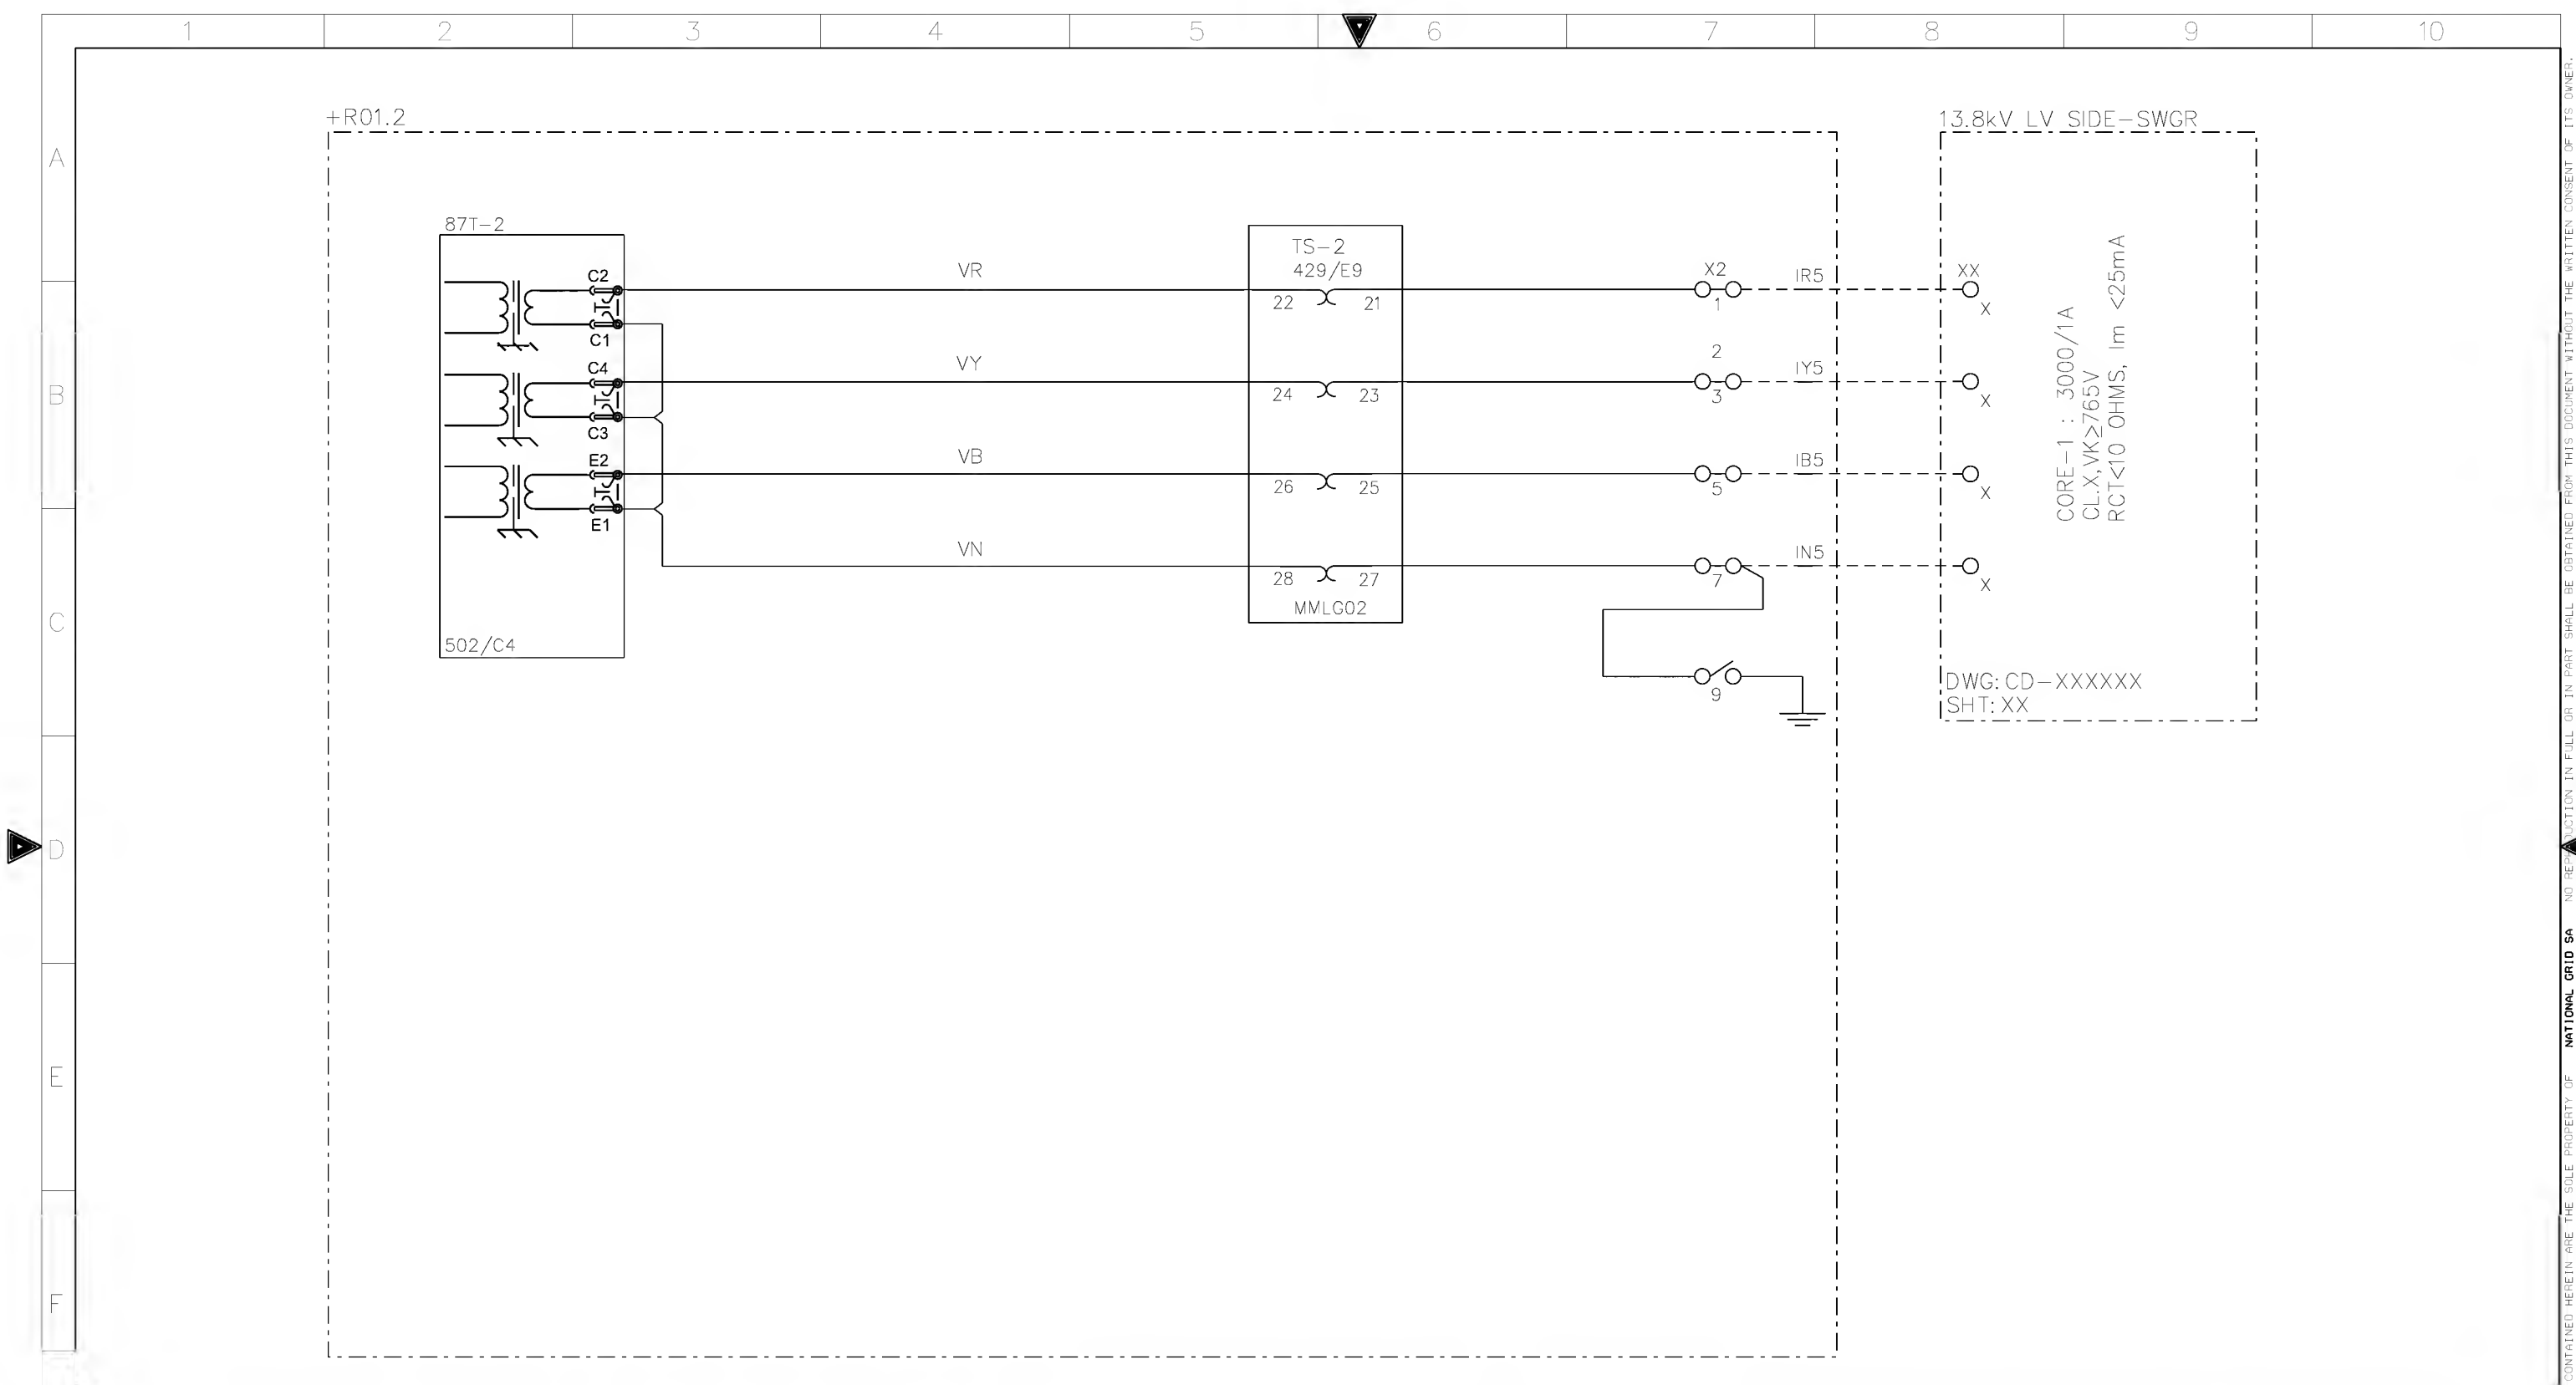

AS-BUILT BY _____ DATE _____			CONTRACT NO. 11131113/00	JOB ORDER NO. S-13656
01	13 49	FACTORY ASBUILT	DRAWN BY RIZ	CHECKED BY JKR
00	13 04	FOR APPROVAL	DATE STARTED 24.01.2013	DATE COMPLETED _____
REV. NO.	DATE	DESCRIPTION	OPRG. DEPT. CTPD	ENG. DEPT. AUT-PSAC

CT & VT CIRCUITS 87T-2 RELAY
132/13.8kV GT-2 RELAY PANEL-2 +R01.2
S/S 8709-132/13.8KV IN AL-KHARJ CITY
RIYADH SAUDI ARABIA

الشركة الوطنية لنقل الكهرباء		نقل الكهرباء		National Grid sa	
INDEX	PLANT NO.	DRAWING NUMBER	SHEET NO.	REV. NO.	
-	C421	CD-322931	SHT 424	CONT. 429	01

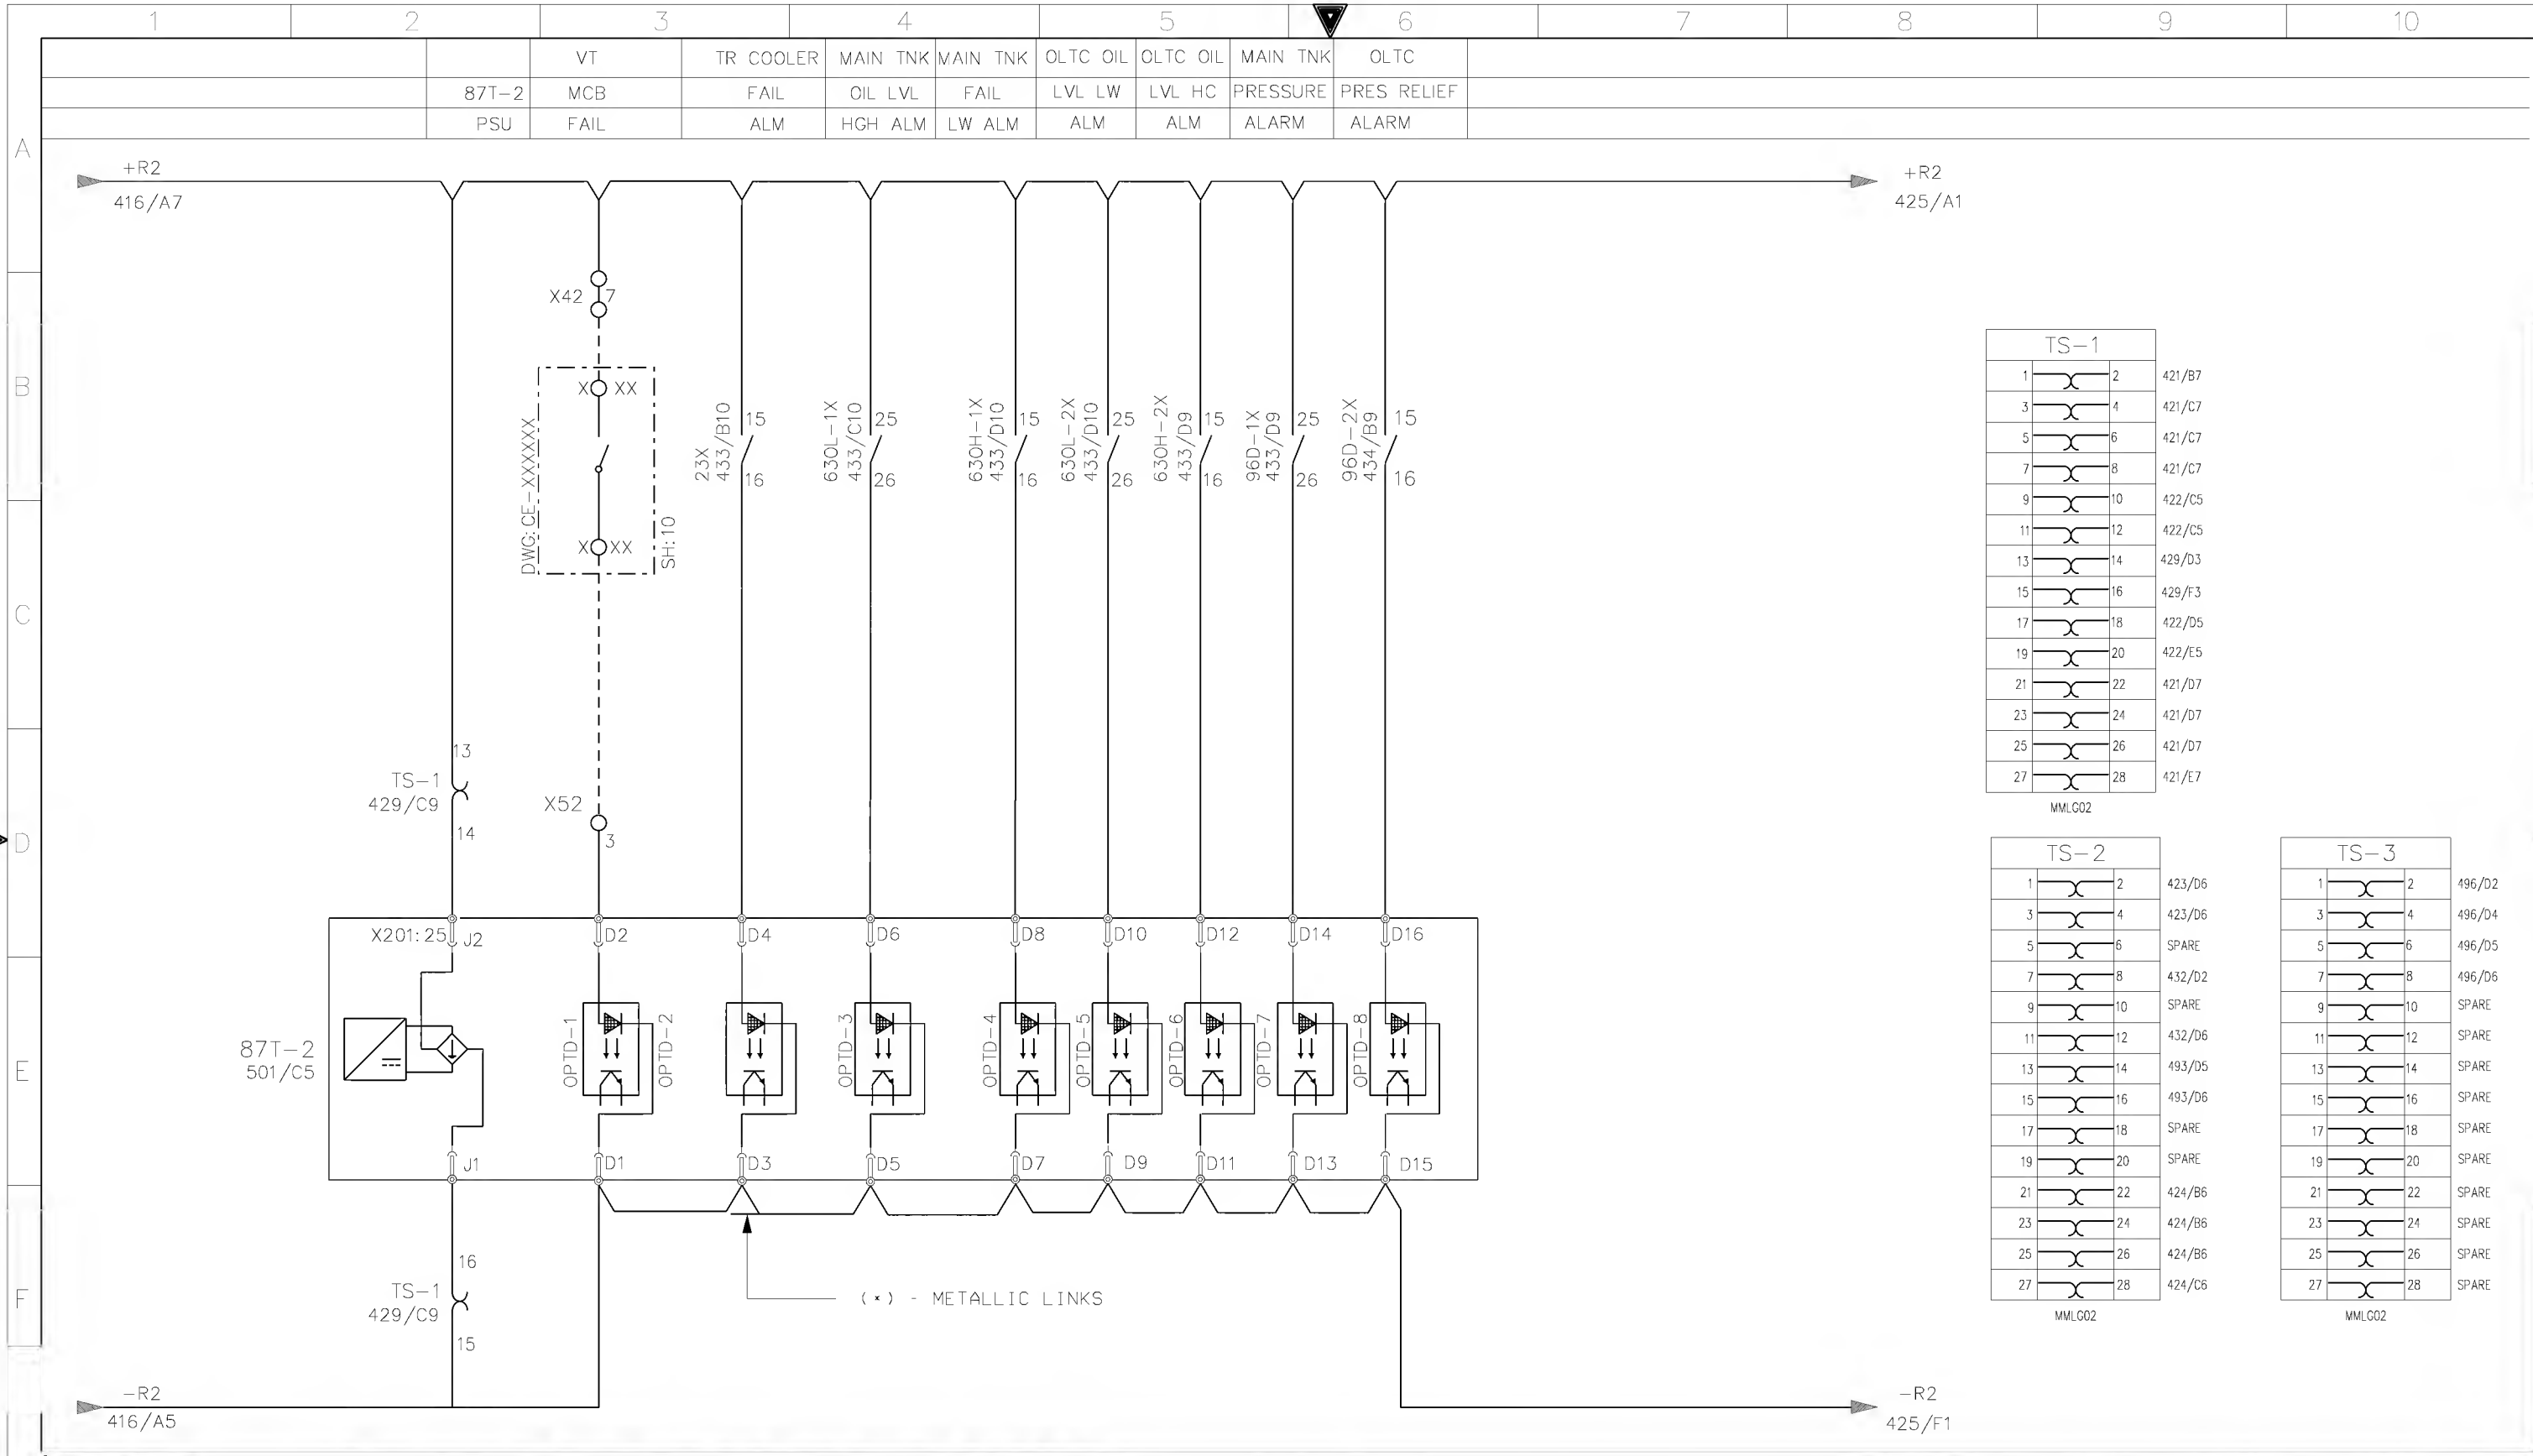


TS-1		
1	2	421/B7
3	4	421/C7
5	6	421/C7
7	8	421/C7
9	10	422/C5
11	12	422/C5
13	14	429/D3
15	16	429/F3
17	18	422/D5
19	20	422/E5
21	22	421/D7
23	24	421/D7
25	26	421/D7
27	28	421/E7




TS-2		
1	2	423/D6
3	4	423/D6
5	6	SPARE
7	8	432/D2
9	10	SPARE
11	12	432/D6
13	14	493/D5
15	16	493/D6
17	18	SPARE
19	20	SPARE
21	22	424/B6
23	24	424/B6
25	26	424/B6
27	28	424/C6

TS-3		
1	2	496/D2
3	4	496/D4
5	6	496/D5
7	8	496/D6
9	10	SPARE
11	12	SPARE
13	14	SPARE
15	16	SPARE
17	18	SPARE
19	20	SPARE
21	22	SPARE
23	24	SPARE
25	26	SPARE
27	28	SPARE



AS-BUILT BY _____ DATE _____			CONTRACT NO. 11131113/00		JOB ORDER NO. S-13656		87T-2 BINARY INPUTS		<div>الشركة الوطنية لنقل الكهرباء</div> <div>National Grid sa</div>	
DRAWN BY RIZ CHECKED BY JKR			DATE STARTED 24.01.2013 DATE COMPLETED _____		132/13.8kV GT-2 RELAY PANEL-2 +R01.2					
01 13 49 FACTORY ASBUILT			OPRG. DEPT. CTPD ENG. DEPT. AUT-PSAC		S/S 8709-132/13.8KV IN AL-KHARJ CITY		RIYADH		SAUDI ARABIA	
00 13 04 FOR APPROVAL									INDEX PLANT NO. DRAWING NUMBER SHEET NO. REV. NO.	
									- C421 CD-322931 429/430 01	

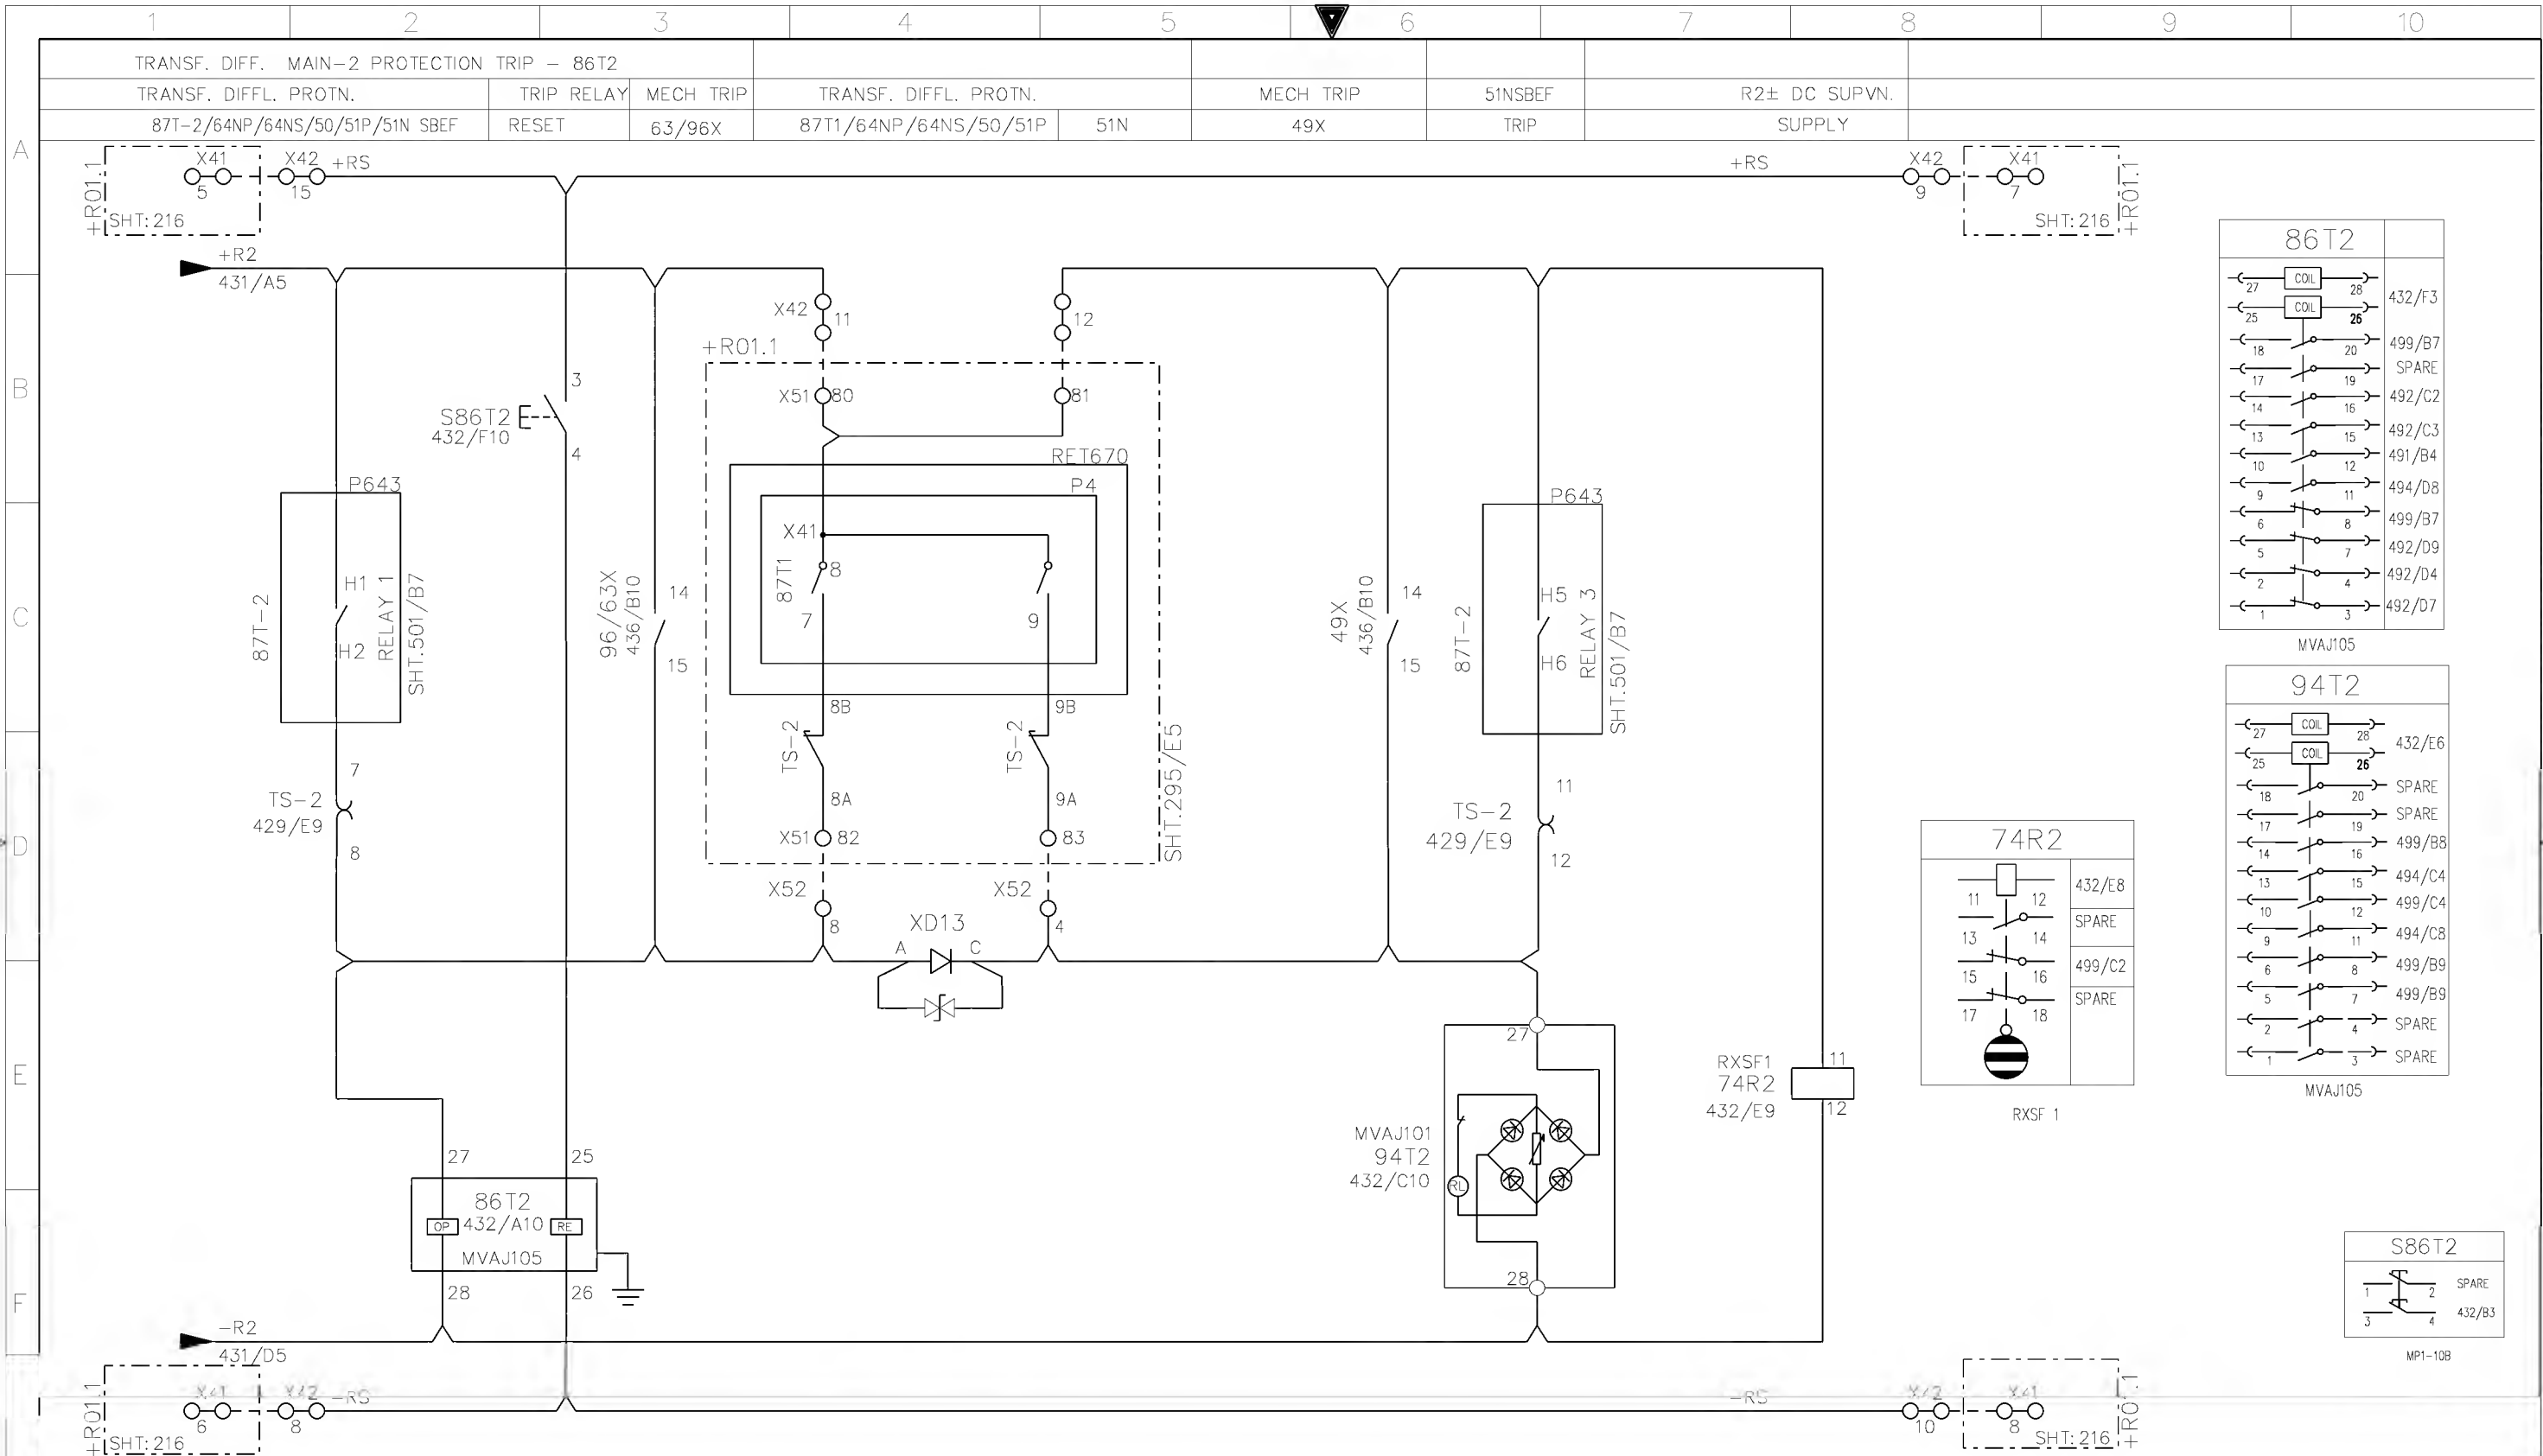



AS-BUILT BY _____ DATE _____			CONTRACT NO. 11131113/00		JOB ORDER NO. S-13656		MAIN-2 TRANSF DIFFL PROT TRIP RELAY CIRCUIT				<div>نقل الكهرباء</div> <div>الشركة الوطنية لنقل الكهرباء</div> <div>National Grid sa</div>						
			DRAWN BY RIZ CHECKED BY JKR				132/13.8kV GT-2 RELAY PANEL-2 +R01.2										
01 13 49 FACTORY ASBUILT			DATE STARTED 24.01.2013		DATE COMPLETED _____		S/S 8709-132/13.8KV IN AL-KHARJ CITY				INDEX	PLANT NO.	DRAWING NUMBER		SHEET NO.	REV. NO.	
00 13 04 FOR APPROVAL							RIYADH SAUDI ARABIA				-	C421	CD-322931		SHT	CONT.	01
REV. NO. DATE DESCRIPTION			OPRG. DEPT. CTPD		ENG. DEPT. AUT-PSAC										432	433	

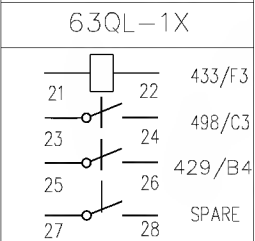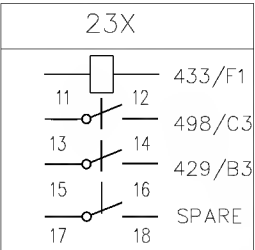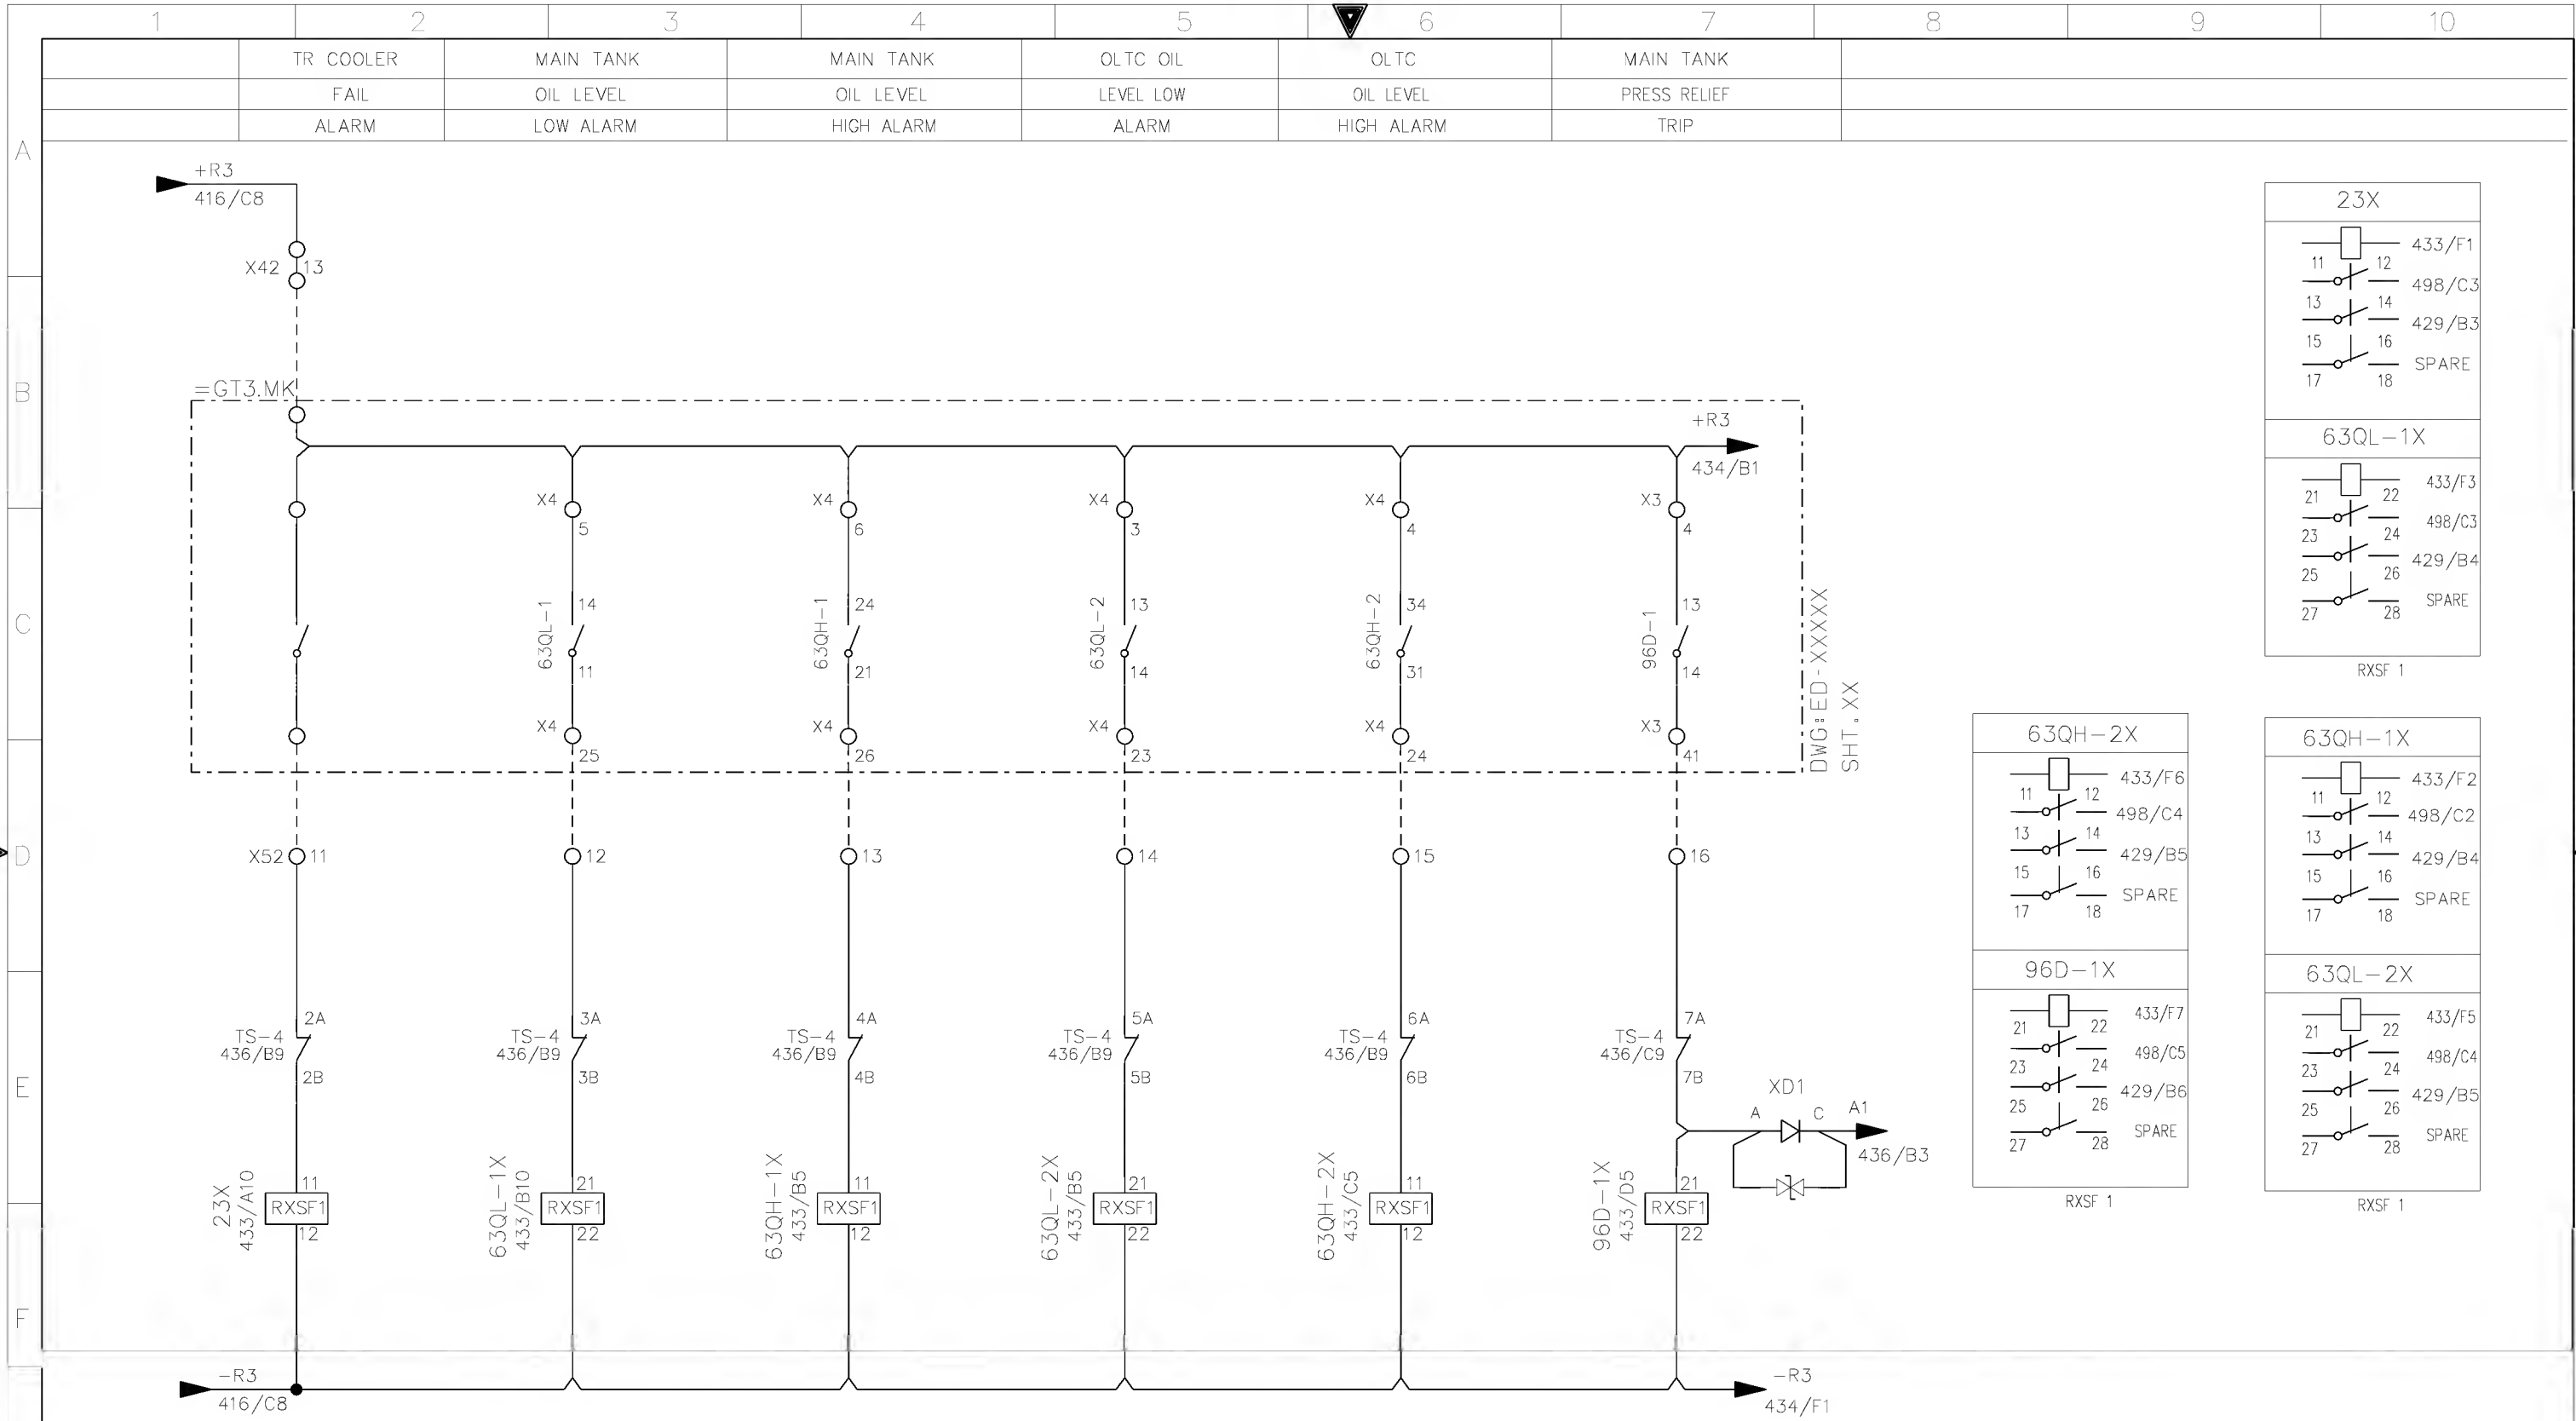

RXS F 1

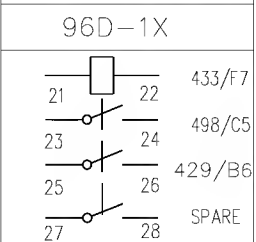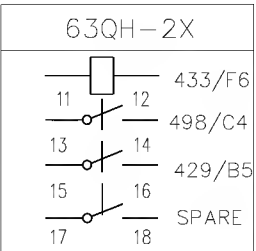

RXS F 1

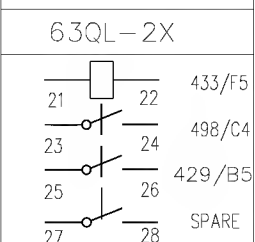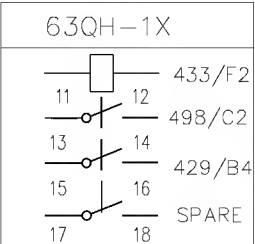


RXS F 1

AS-BUILT BY _____ DATE _____			CONTRACT NO. 11131113/00		JOB ORDER NO. S-13656	
01	13 49	FACTORY ASBUILT	DRAWN BY RIZ		CHECKED BY JKR	
00	13 04	FOR APPROVAL	DATE STARTED 24.01.2013		DATE COMPLETED _____	
REV. NO.	DATE	DESCRIPTION	OPRG. DEPT. CTPD		ENG. DEPT. AUT-PSAC	

TRANS .MECH.PROTN.CONTACT MULTI.CKT
132/13.8kV GT-2 RELAY PANEL-2 +R01.2
S/S 8709-132/13.8KV IN AL-KHARJ CITY
RIYADH SAUDI ARABIA





الشركة الوطنية لنقل الكهرباء National Grid sa				
INDEX	PLANT NO.	DRAWING NUMBER	SHEET NO.	REV. NO.
-	C421	CD-322931	SHT 433	CONT. 434
			01	

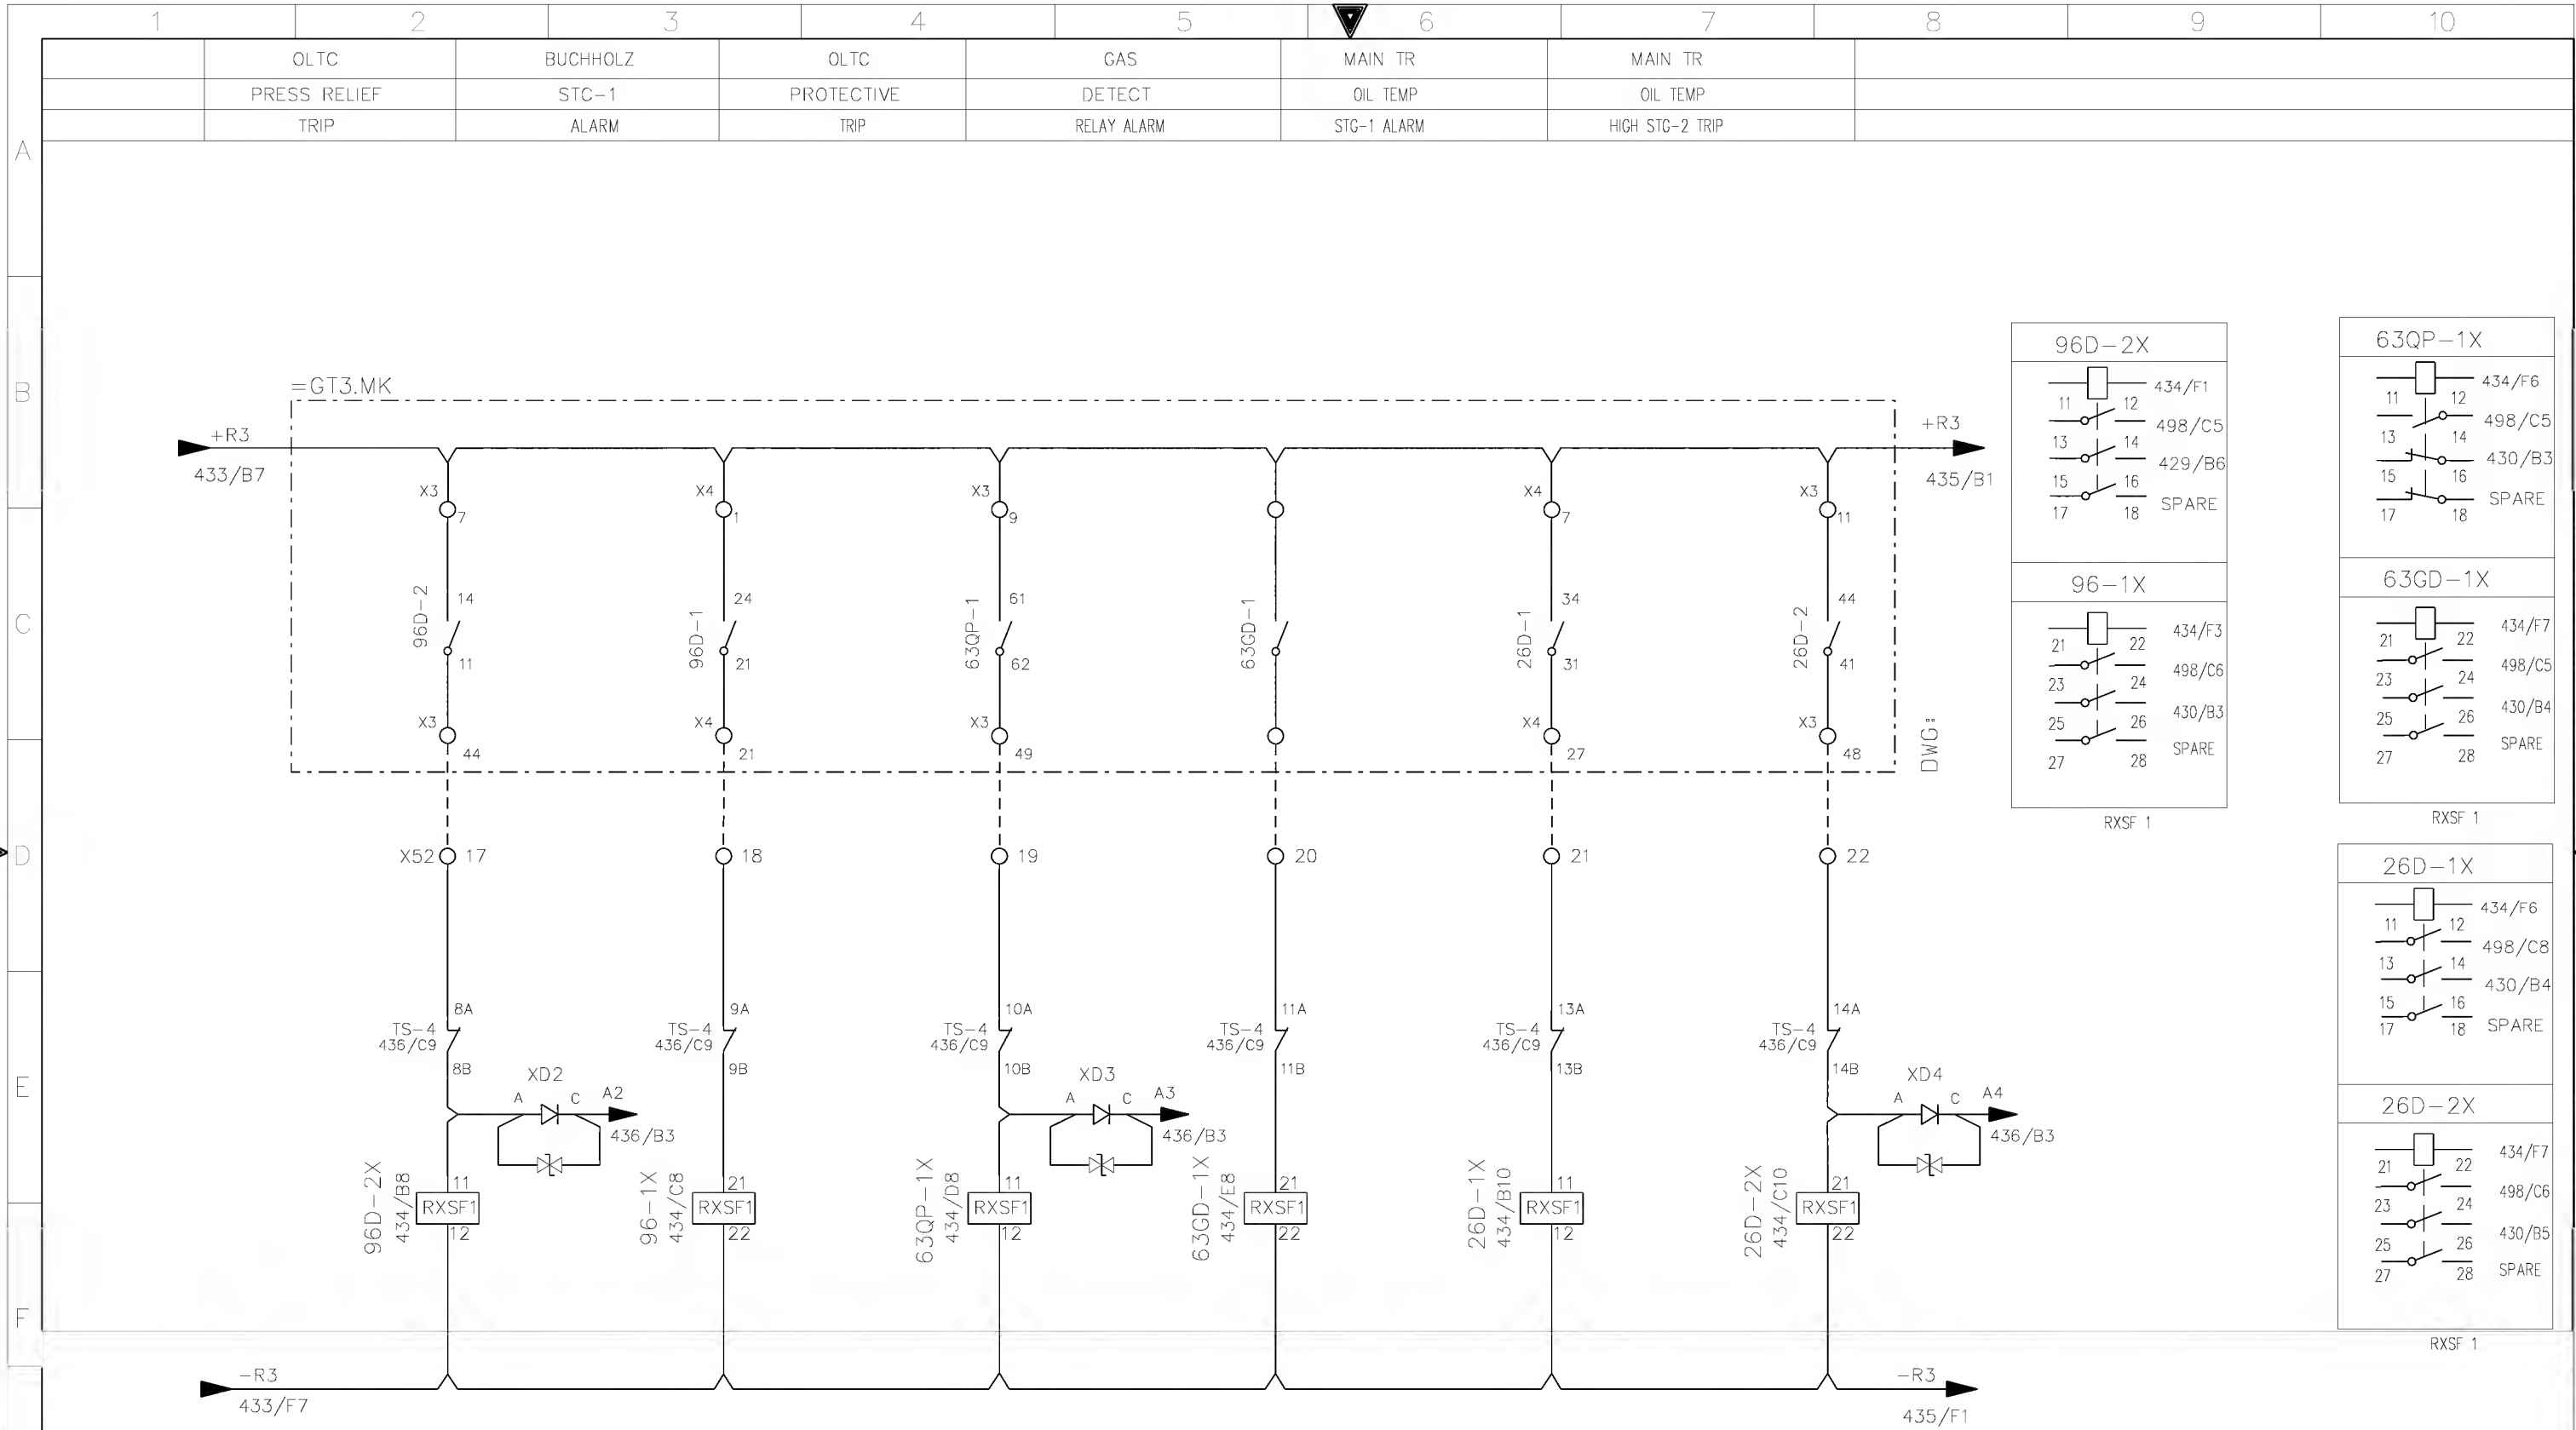


AS-BUILT BY _____ DATE _____			CONTRACT NO. 11131113/00		JOB ORDER NO. S-13656	
01	13 49	FACTORY ASBUILT	DRAWN BY RIZ		CHECKED BY JKR	
00	13 04	FOR APPROVAL	DATE STARTED 24.01.2013		DATE COMPLETED _____	
REV. NO.	DATE	DESCRIPTION	OPRG. DEPT. CTPD		ENG. DEPT. AUT-PSAC	

TRANS .MECH.PROTN.CONTACT MULTI.CKT	
132/13.8kv GT-2 RELAY PANEL-2 +R01.2	
S/S 8709-132/13.8KV IN AL-KHARJ CITY	
RIYADH SAUDI ARABIA	

الشركة الوطنية لنقل الكهرباء		نقل الكهرباء	
National Grid sa		National Grid sa	
INDEX	PLANT NO.	DRAWING NUMBER	SHEET NO.
-	C421	CD-322931	434 435
		REV. NO.	
		01	

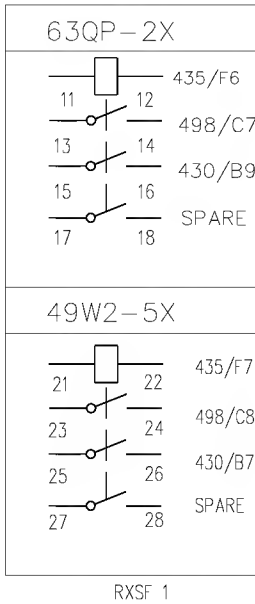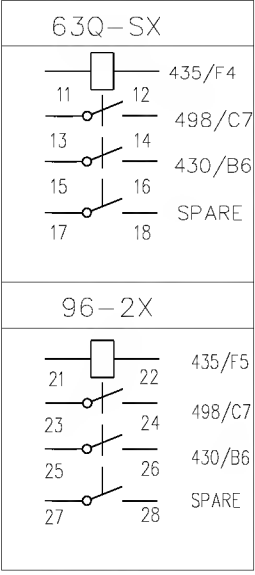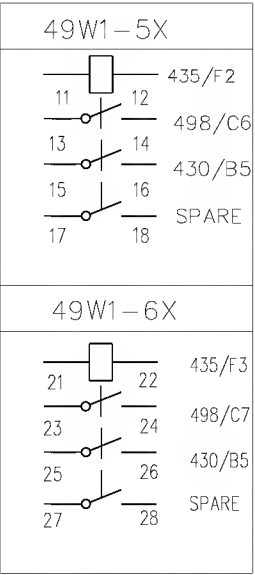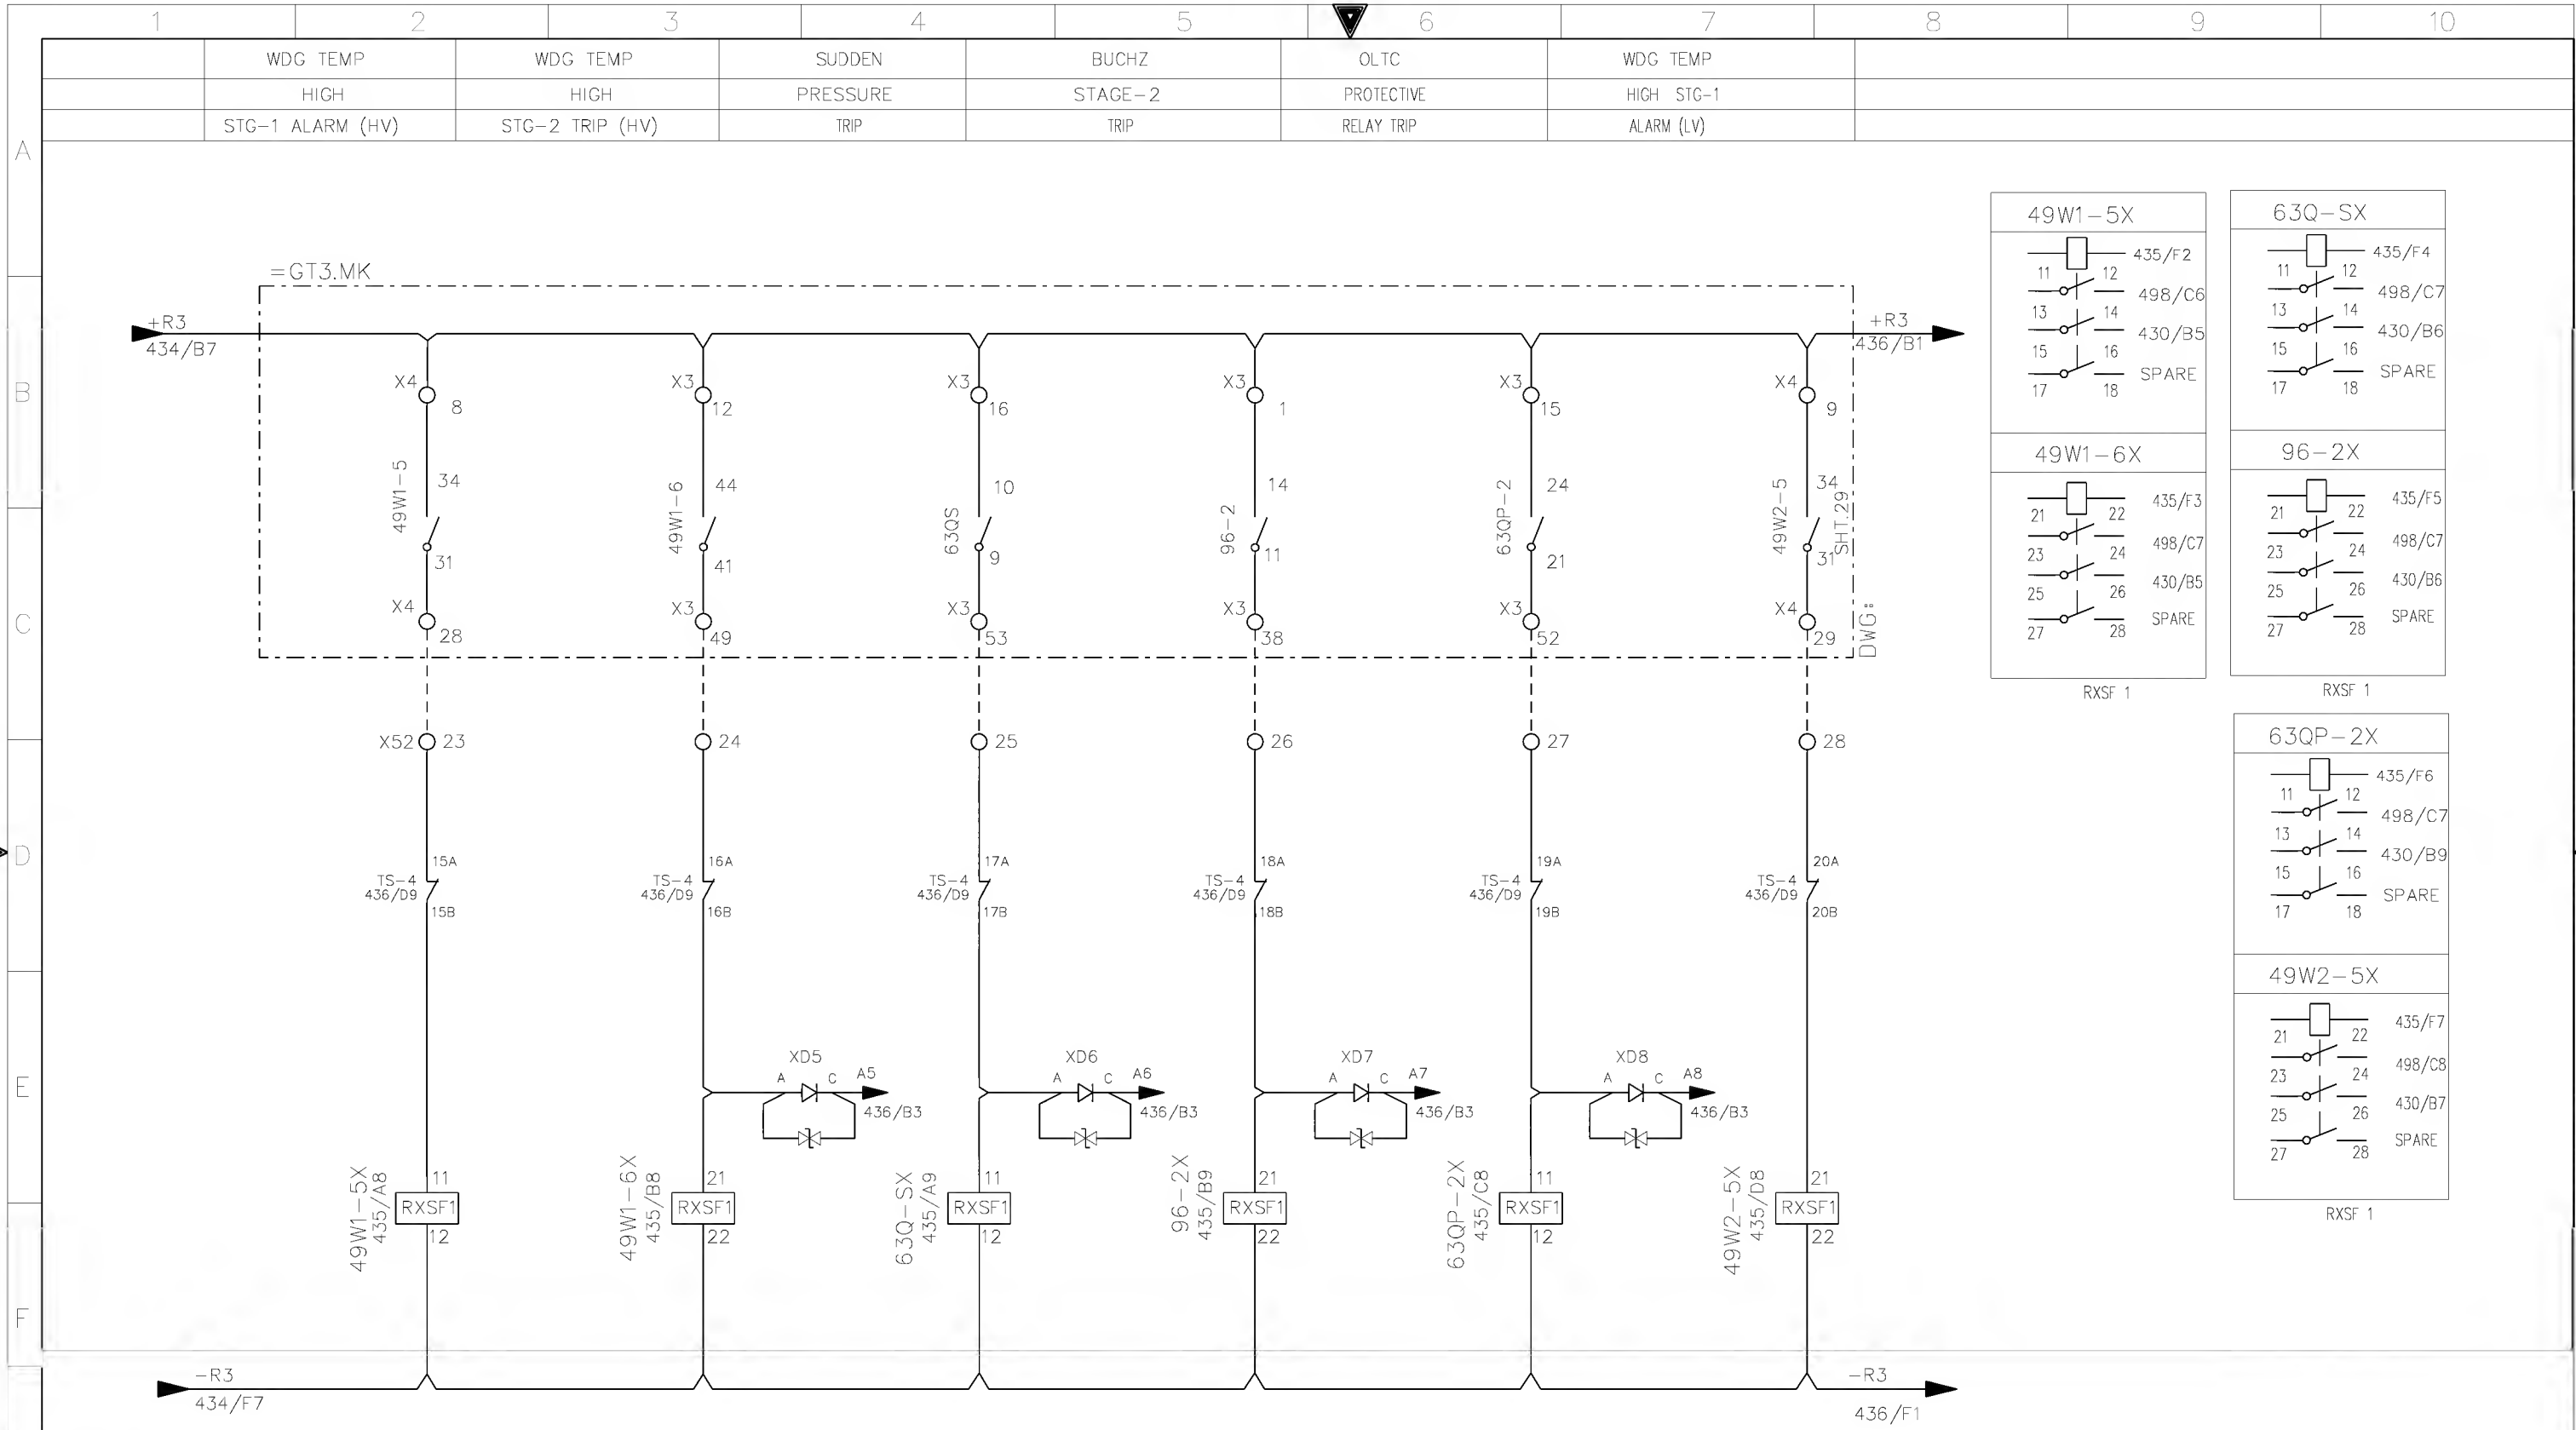

AS-BUILT BY _____ DATE _____			CONTRACT NO. 11131113/00		JOB ORDER NO. S-13656		TRANS.MECH.PROTN.CONTACT.MULTI.CKT			<div>نقل الكهرباء</div> <div>الشركة الوطنية لنقل الكهرباء</div> <div>National Grid sa</div>								
			DRAWN BY RIZ		CHECKED BY JKR		132/13.8kV GT-2 RELAY PANEL-2 +R01.2											
01 13 49			FACTORY ASBUILT		DATE STARTED 24.01.2013		DATE COMPLETED _____		S/S 8709-132/13.8KV IN AL-KHARJ CITY			INDEX	PLANT NO.	DRAWING NUMBER		SHEET NO.		REV. NO.
00 13 04			FOR APPROVAL		OPRG. DEPT. CTPD		ENG. DEPT. AUT-PSAC		RIYADH			-	C421	CD-322931		SHT	CONT.	01
REV. NO.			DATE		DESCRIPTION									435	436			

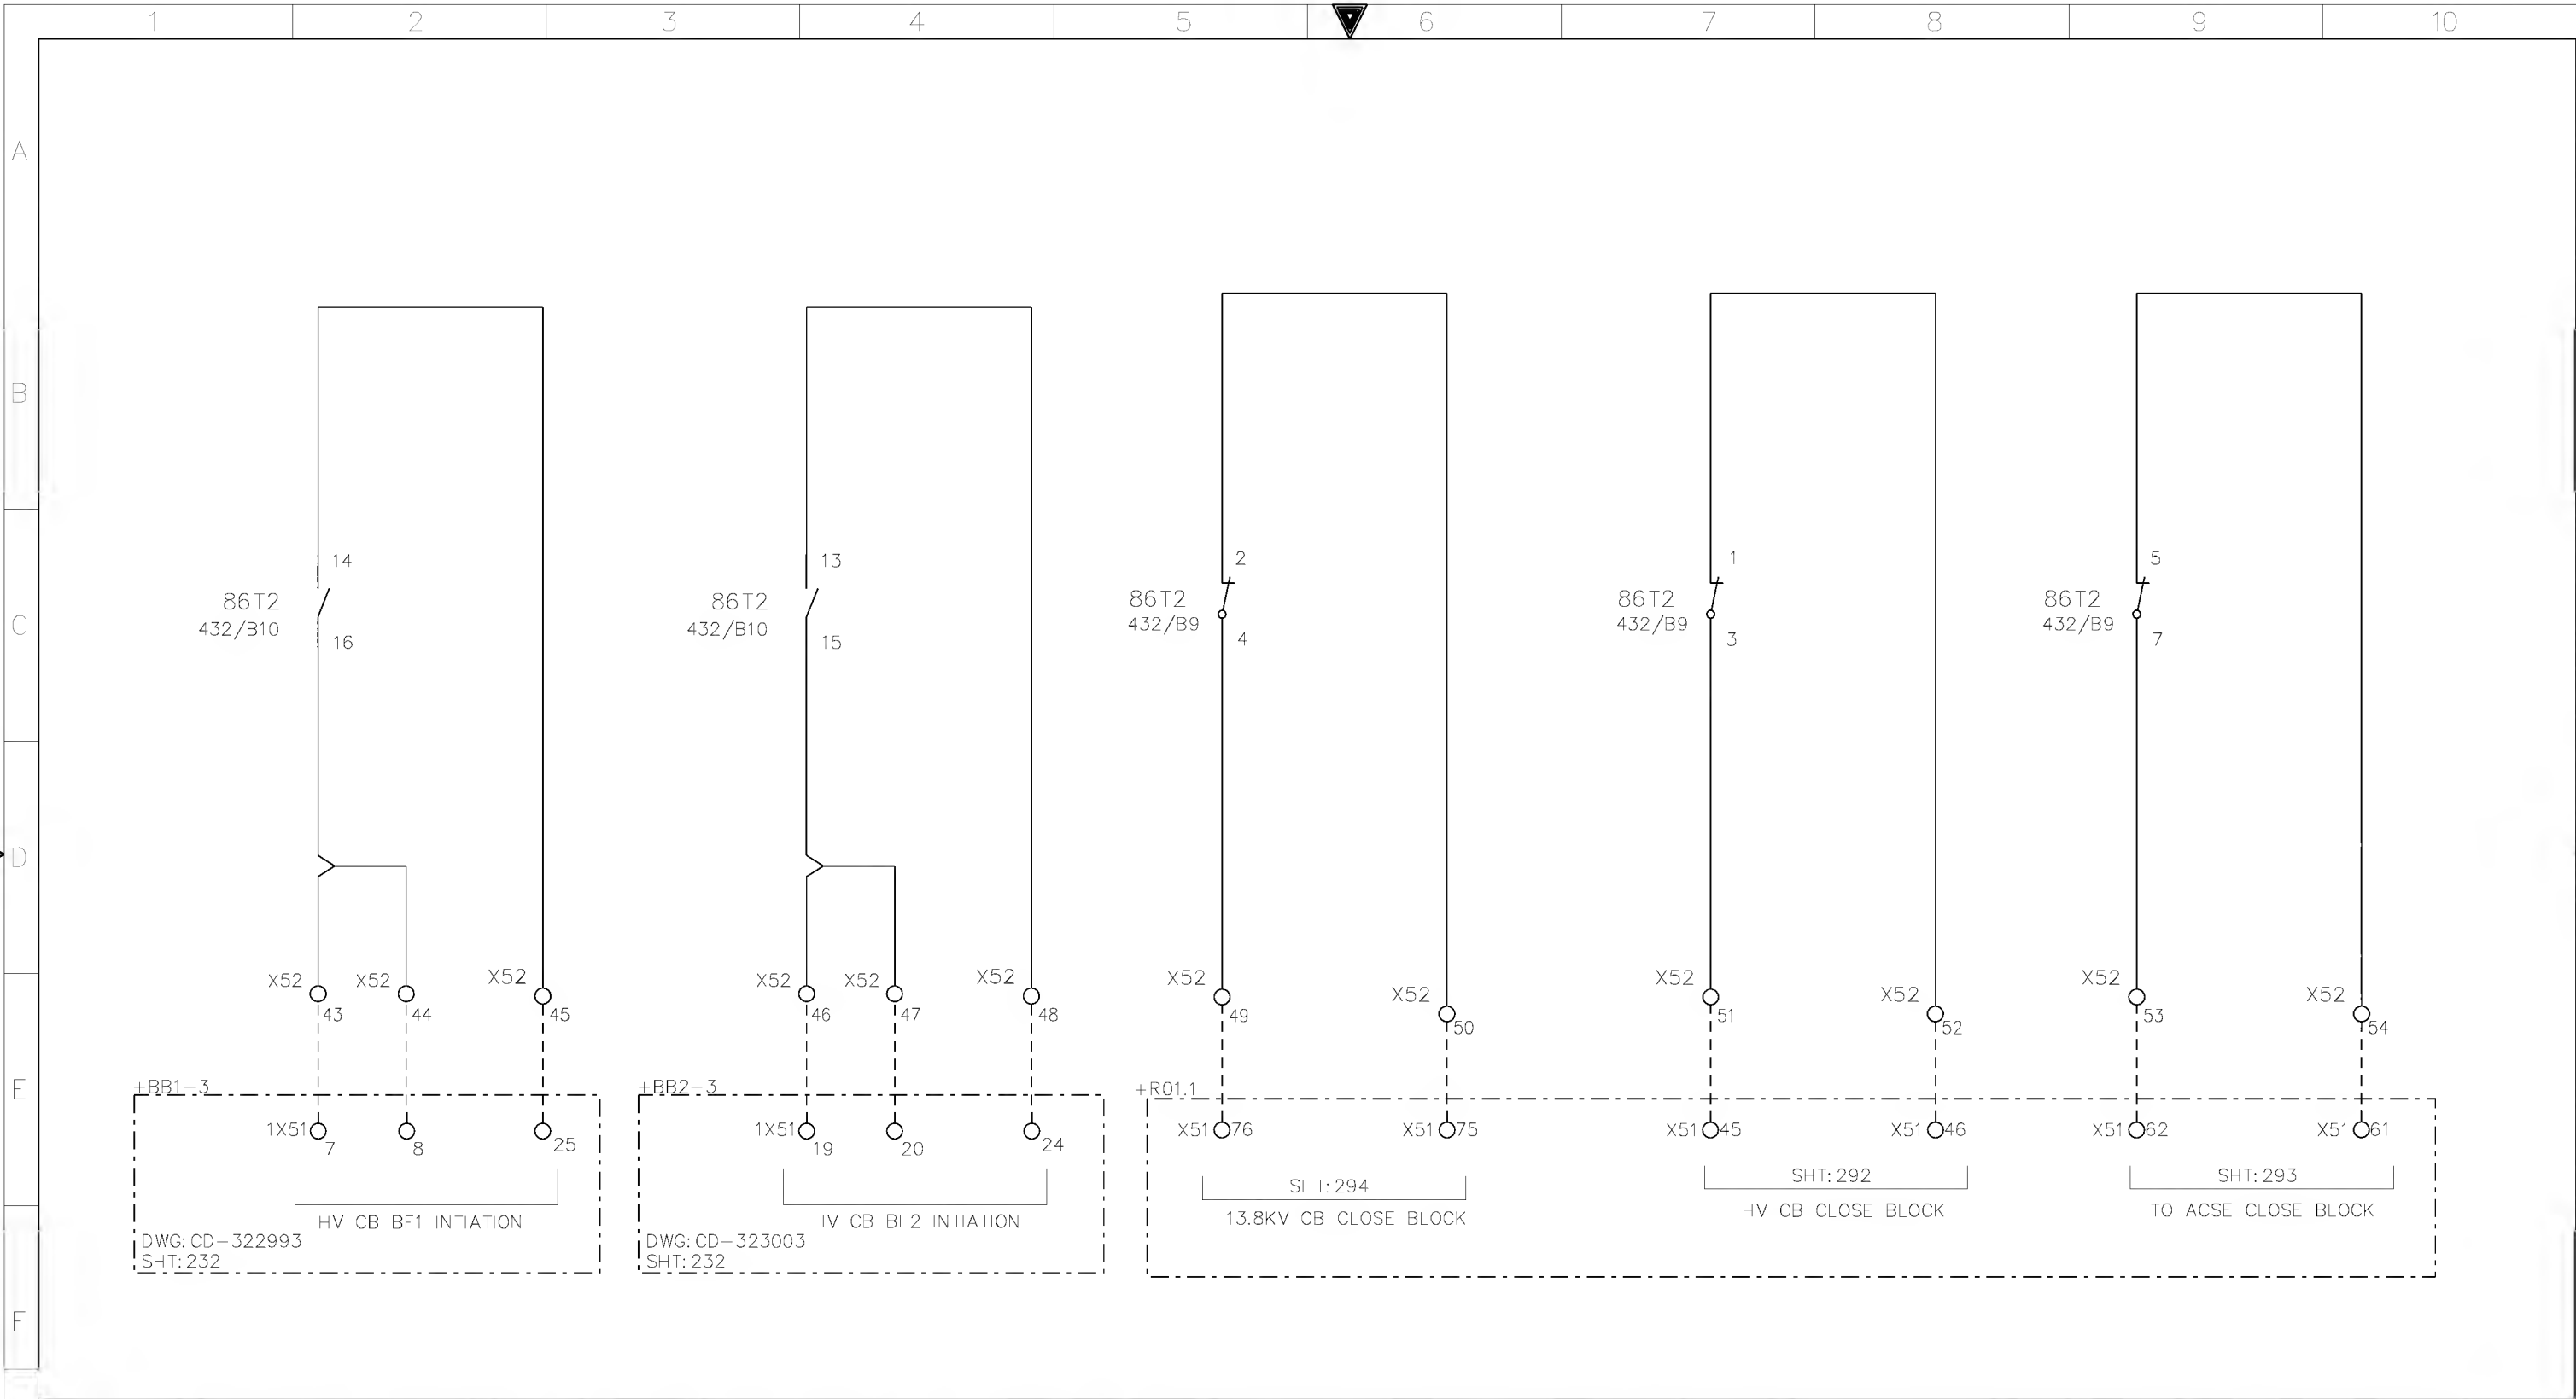

AS-BUILT BY _____ DATE _____			CONTRACT NO. 11131113/00		JOB ORDER NO. S-13656		BF INI & CLOSE BLOCK CIRCUIT		<div>الشركة الوطنية لنقل الكهرباء</div> <div>National Grid sa</div>								
			DRAWN BY RIZ		CHECKED BY JKR		132/13.8kV GT-2 RELAY PANEL-2 +R01.2										
01 13 49			FACTORY ASBUILT		DATE STARTED 24.01.2013		DATE COMPLETED _____		S/S 8709-132/13.8KV IN AL-KHARJ CITY		INDEX	PLANT NO.	DRAWING NUMBER		SHEET NO.		REV. NO.
00 13 04			FOR APPROVAL		OPRG. DEPT. CTPD		ENG. DEPT. AUT-PSAC		RIYADH SAUDI ARABIA		-	C421	CD-322931		SHT 492	CONT. 493	01
REV. NO.			DATE		DESCRIPTION												

A


B

C

D

E


F

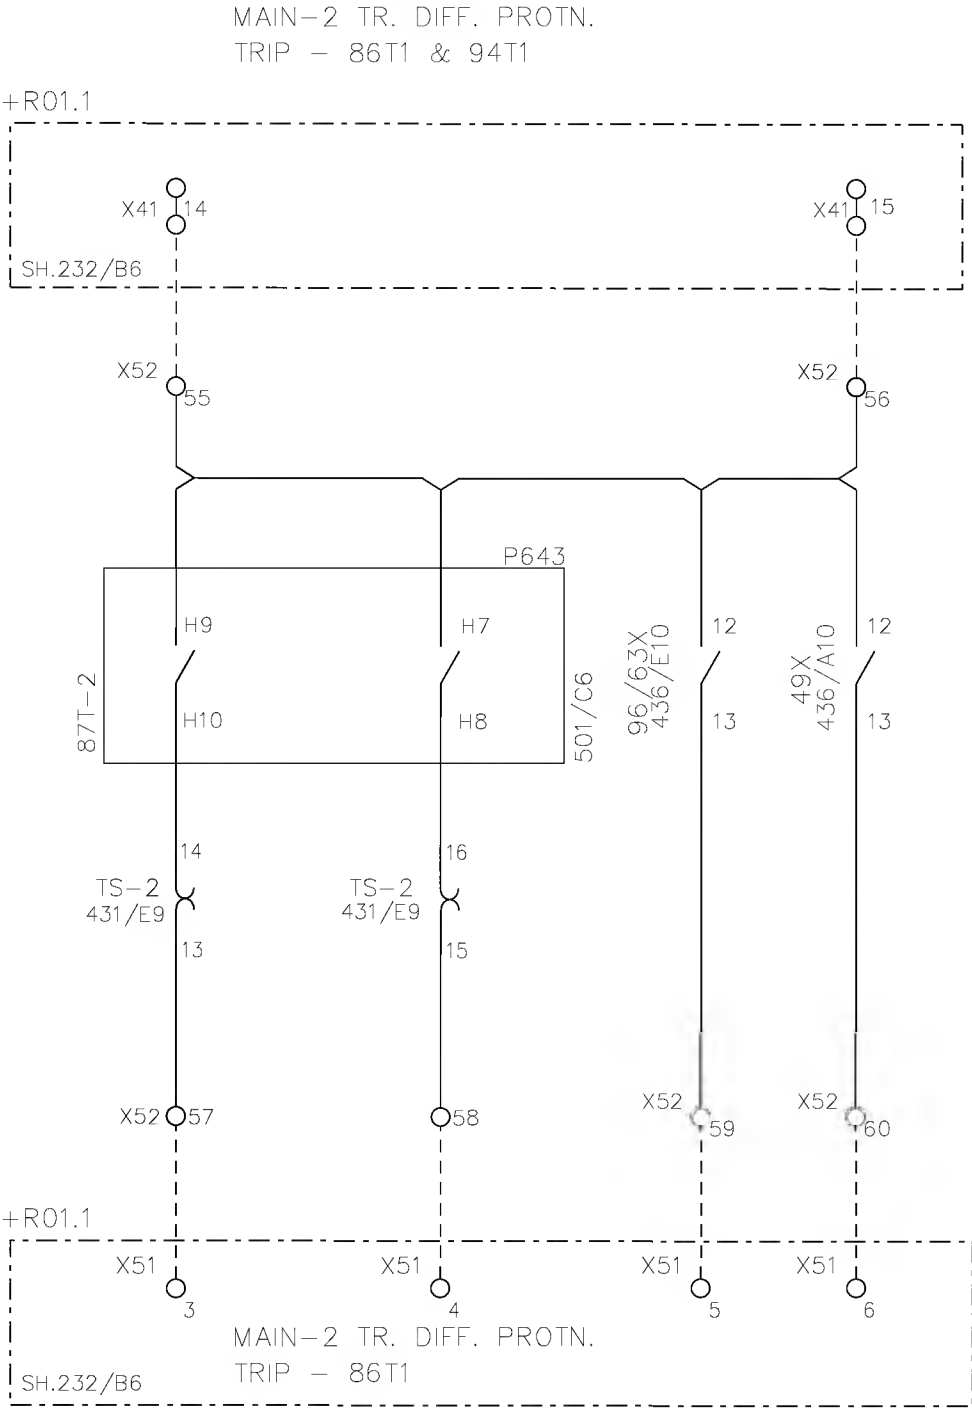


+R01.2

G

AS-BUILT BY _____ DATE _____			CONTRACT NO. 11131113/00		JOB ORDER NO. S-13656		TRANSFORMER MECHANICAL PROTN.		<div>الشركة الوطنية لنقل الكهرباء</div> <div>National Grid sa</div>						
01	13 49	FACTORY ASBUILT	DRAWN BY RIZ		CHECKED BY JKR		132/13.8kV GT-2 RELAY PANEL-2 +R01.2								
00	13 04	FOR APPROVAL	DATE STARTED 24.01.2013		DATE COMPLETED _____		S/S 8709-132/13.8KV IN AL-KHARJ CITY		INDEX	PLANT NO.	DRAWING NUMBER		SHEET NO.		REV. NO.
REV. NO.	DATE	DESCRIPTION	OPRG. DEPT. CTPD		ENG. DEPT. AUT-PSAC		RIYADH SAUDI ARABIA		-	C421	CD-322931		SHT	CONT.	01
													493	494	

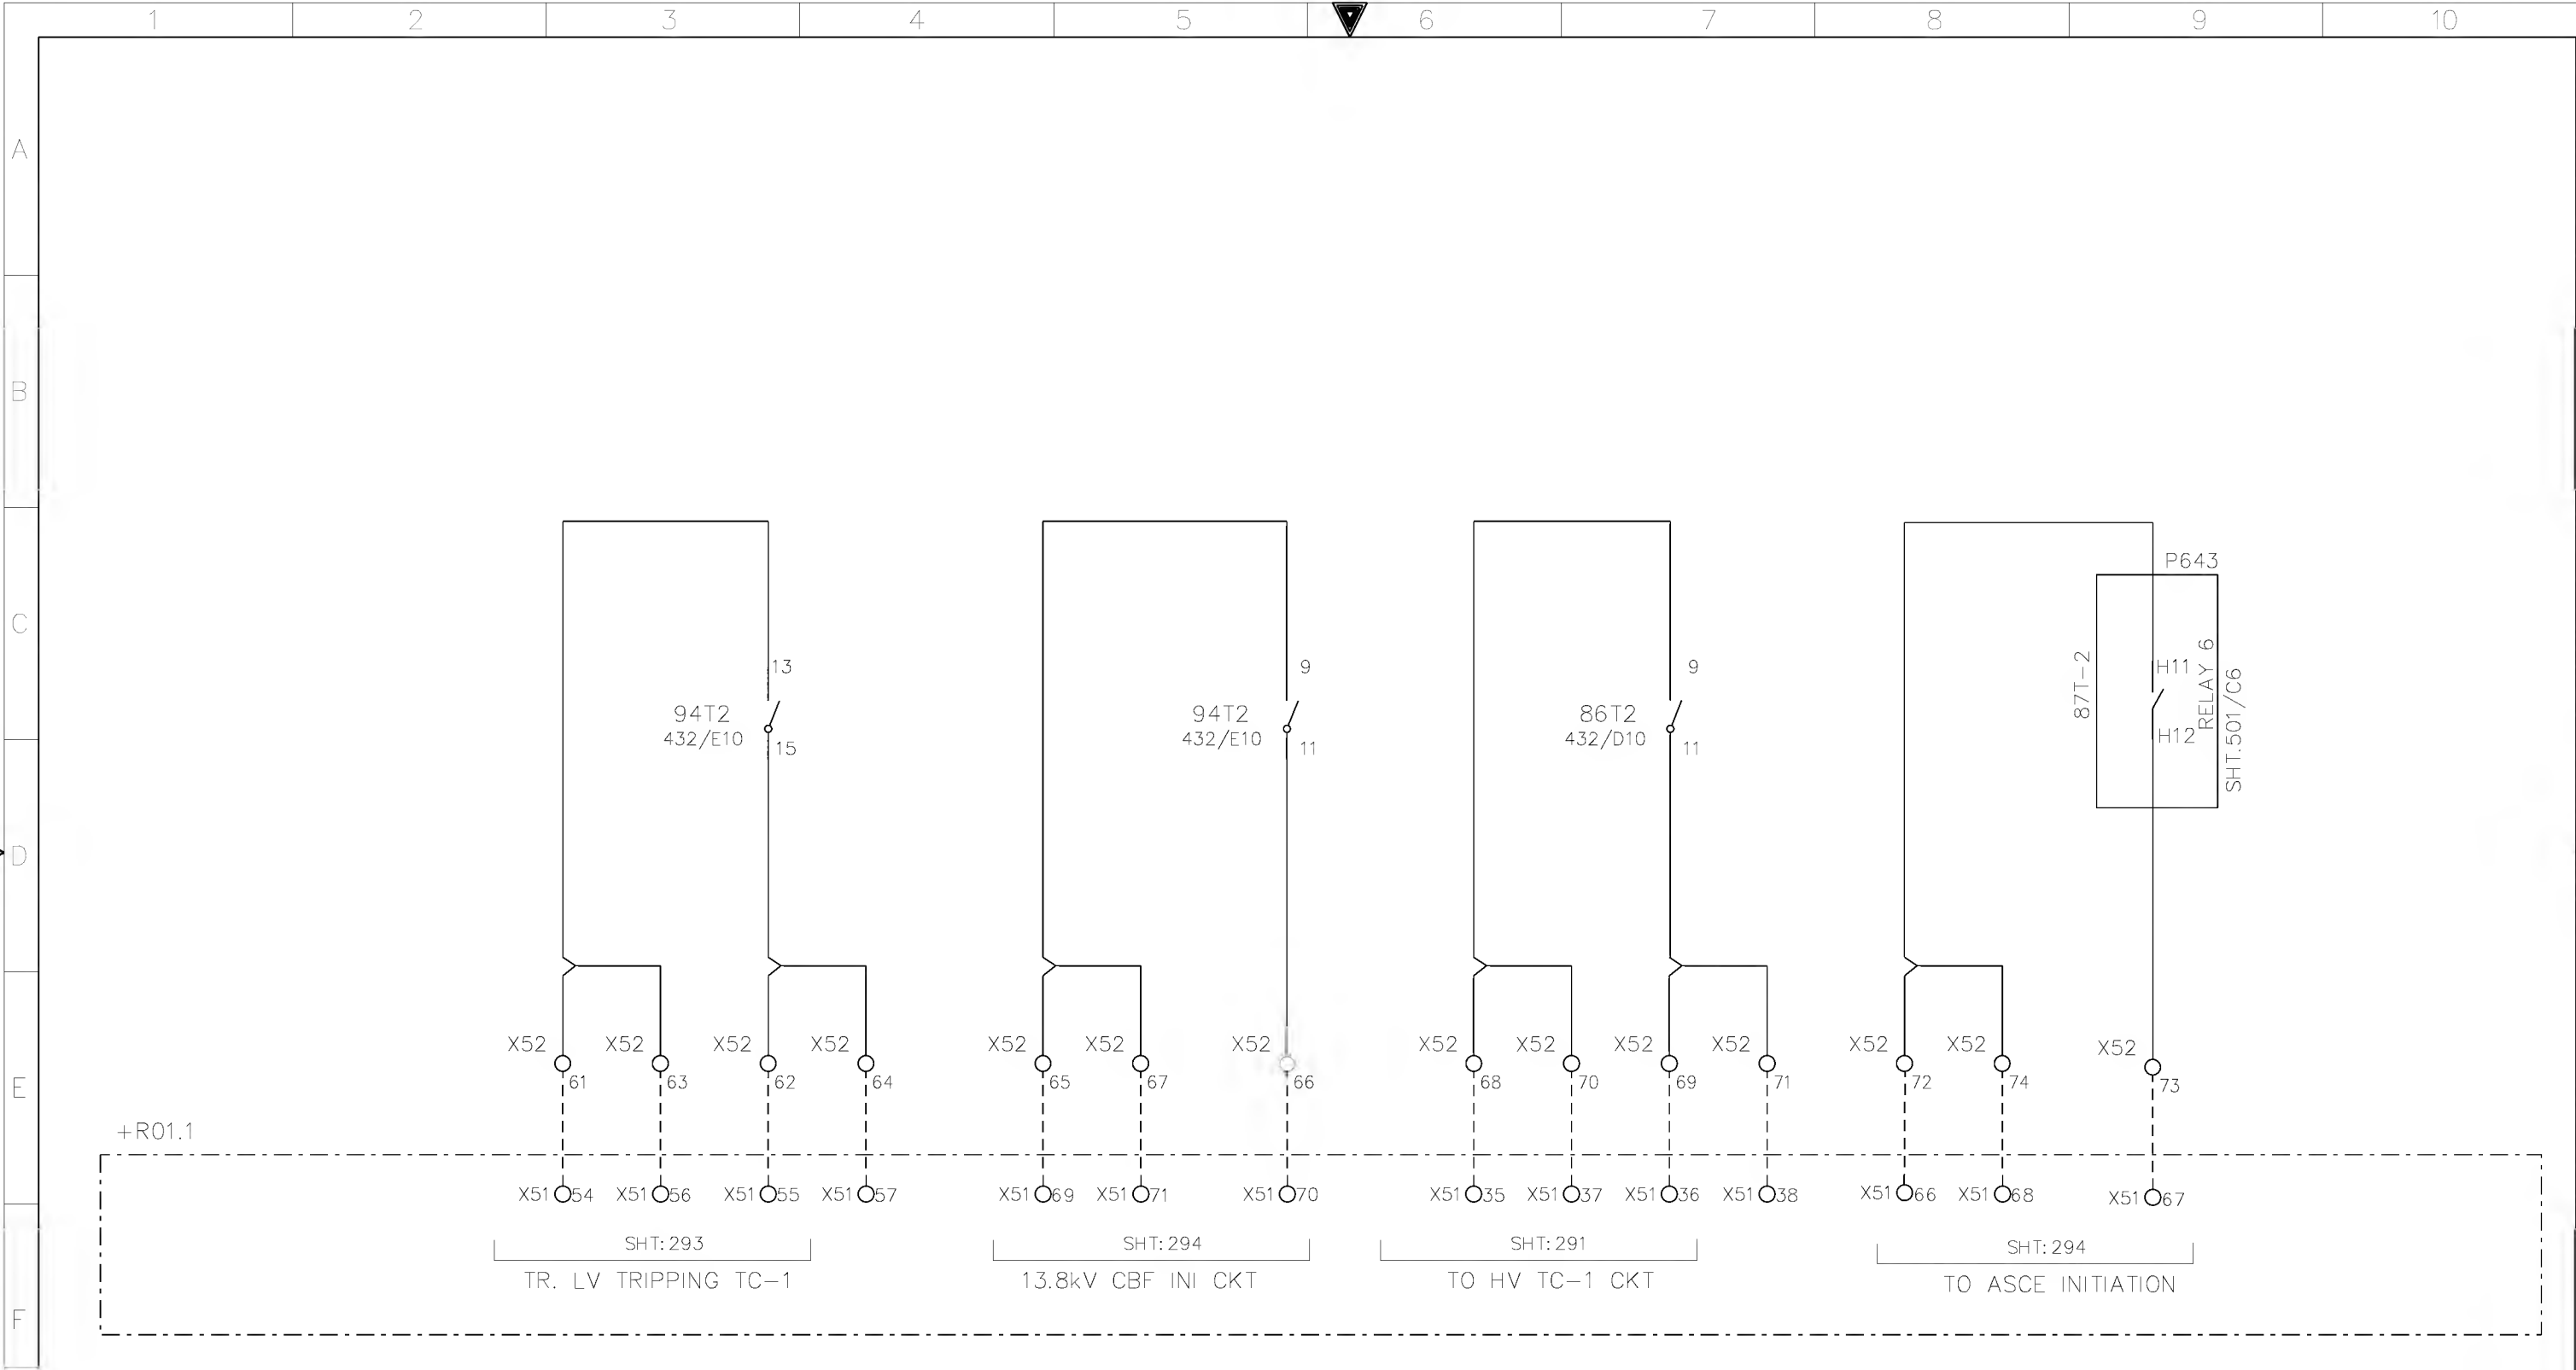

G	AS-BUILT BY _____ DATE _____		CONTRACT NO. 11131113/00		JOB ORDER NO. S-13656		CONTACTS FOR TRIP AND CLOSE BLOCK		<div>الشركة الوطنية لنقل الكهرباء</div> <div>نقل الكهرباء</div> <div>National Grid sa</div>						
							132/13.8kV GT-2 RELAY PANEL-2 +R01.2								
	01	13 49	FACTORY ASBUILT		DRAWN BY RIZ CHECKED BY JKR		S/S 8709-132/13.8KV IN AL-KHARJ CITY		INDEX	PLANT NO.	DRAWING NUMBER		SHEET NO.		REV. NO.
	00	13 04	FOR APPROVAL		DATE STARTED 24.01.2013 DATE COMPLETED _____		RIYADH SAUDI ARABIA		-	C421	CD-322931		SHT 494	CONT. 496	01
	REV. NO.	DATE	DESCRIPTION		OPRG. DEPT. CTPD ENG. DEPT. AUT-PSAC										

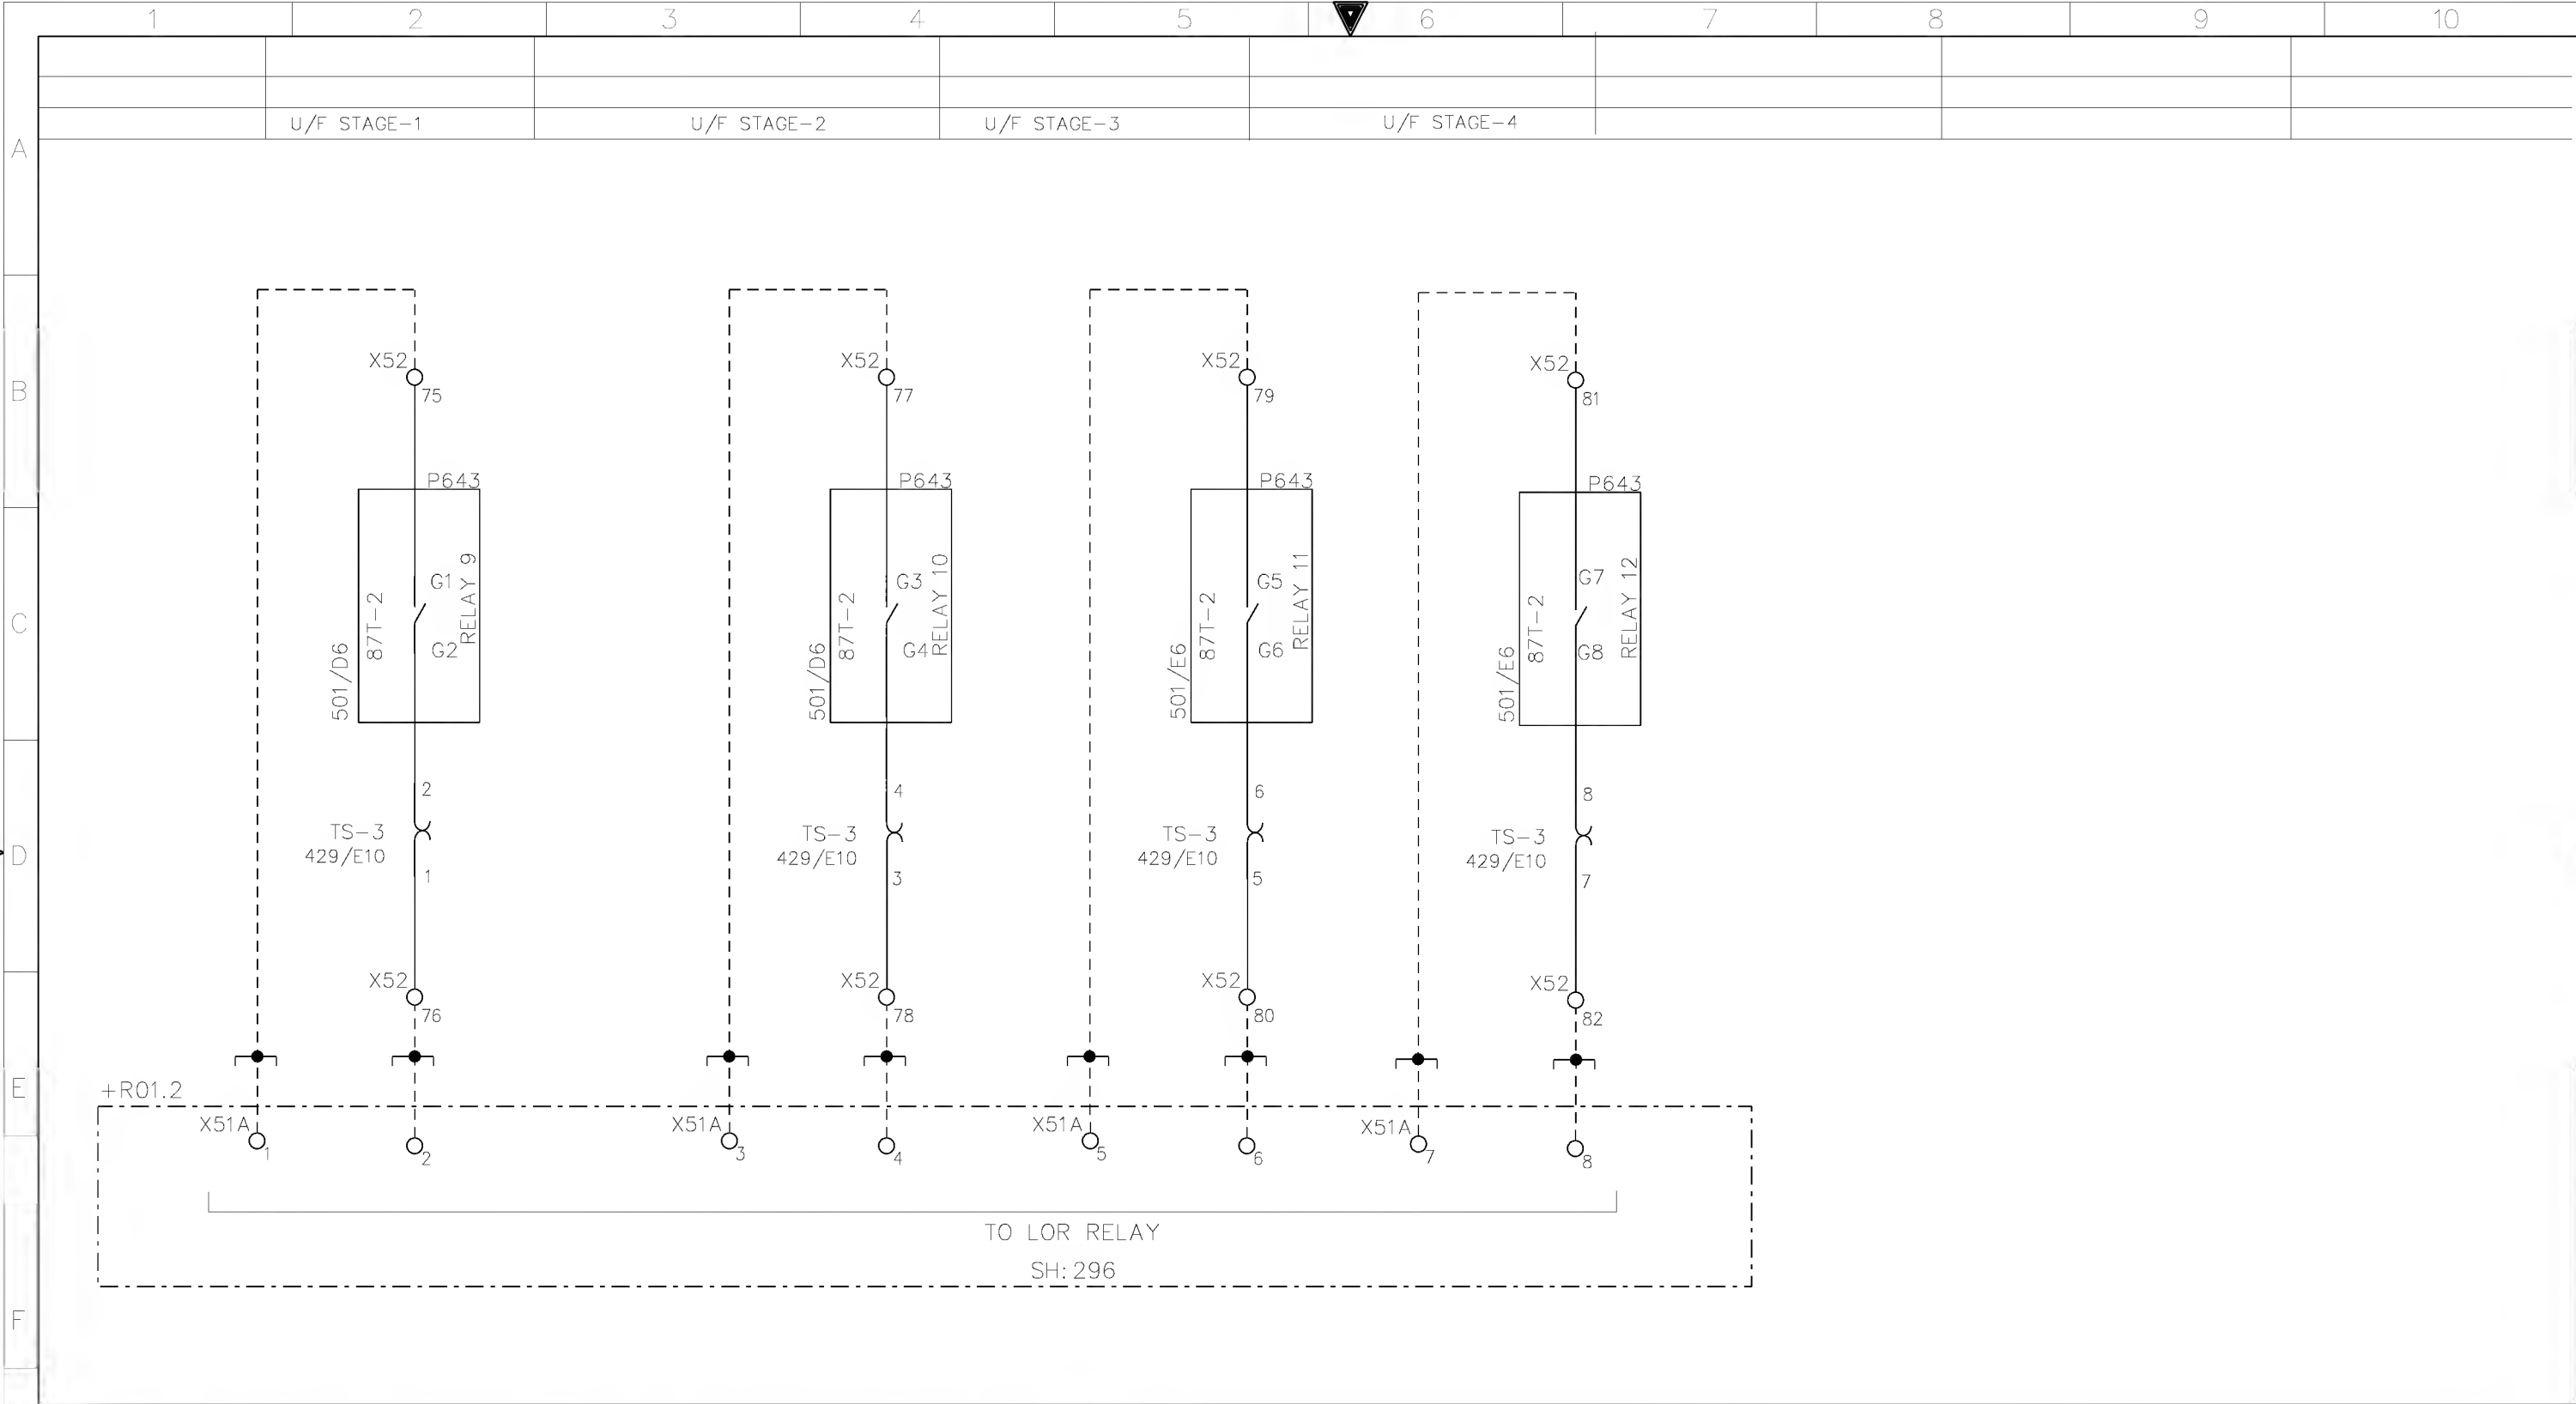

AS-BUILT BY _____ DATE _____ CONTRACT NO. 11131113/00 JOB ORDER NO. S-13656

01	13 49	FACTORY ASBUILT	DRAWN BY RIZ CHECKED BY JKR
00	13 04	FOR APPROVAL	DATE STARTED 24.01.2013 DATE COMPLETED _____
REV. NO.	DATE	DESCRIPTION	OPRG. DEPT. CTPD ENG. DEPT. AUT-PSAC

CONTACTS FOR U/F LOAD SHEDDING

132/13.8kV GT-2 RELAY PANEL-2 +R01.2

S/S 8709-132/13.8KV IN AL-KHARJ CITY
RIYADH SAUDI ARABIA

الشركة الوطنية لنقل الكهرباء



نقل الكهرباء
National Grid sa


INDEX	PLANT NO.	DRAWING NUMBER	SHEET NO.	REV. NO.
-	C421	CD-322931	SHT CONT.	01
			496498	


DMS

VECTOR


NG/D2-D (2012/01)

NGD200

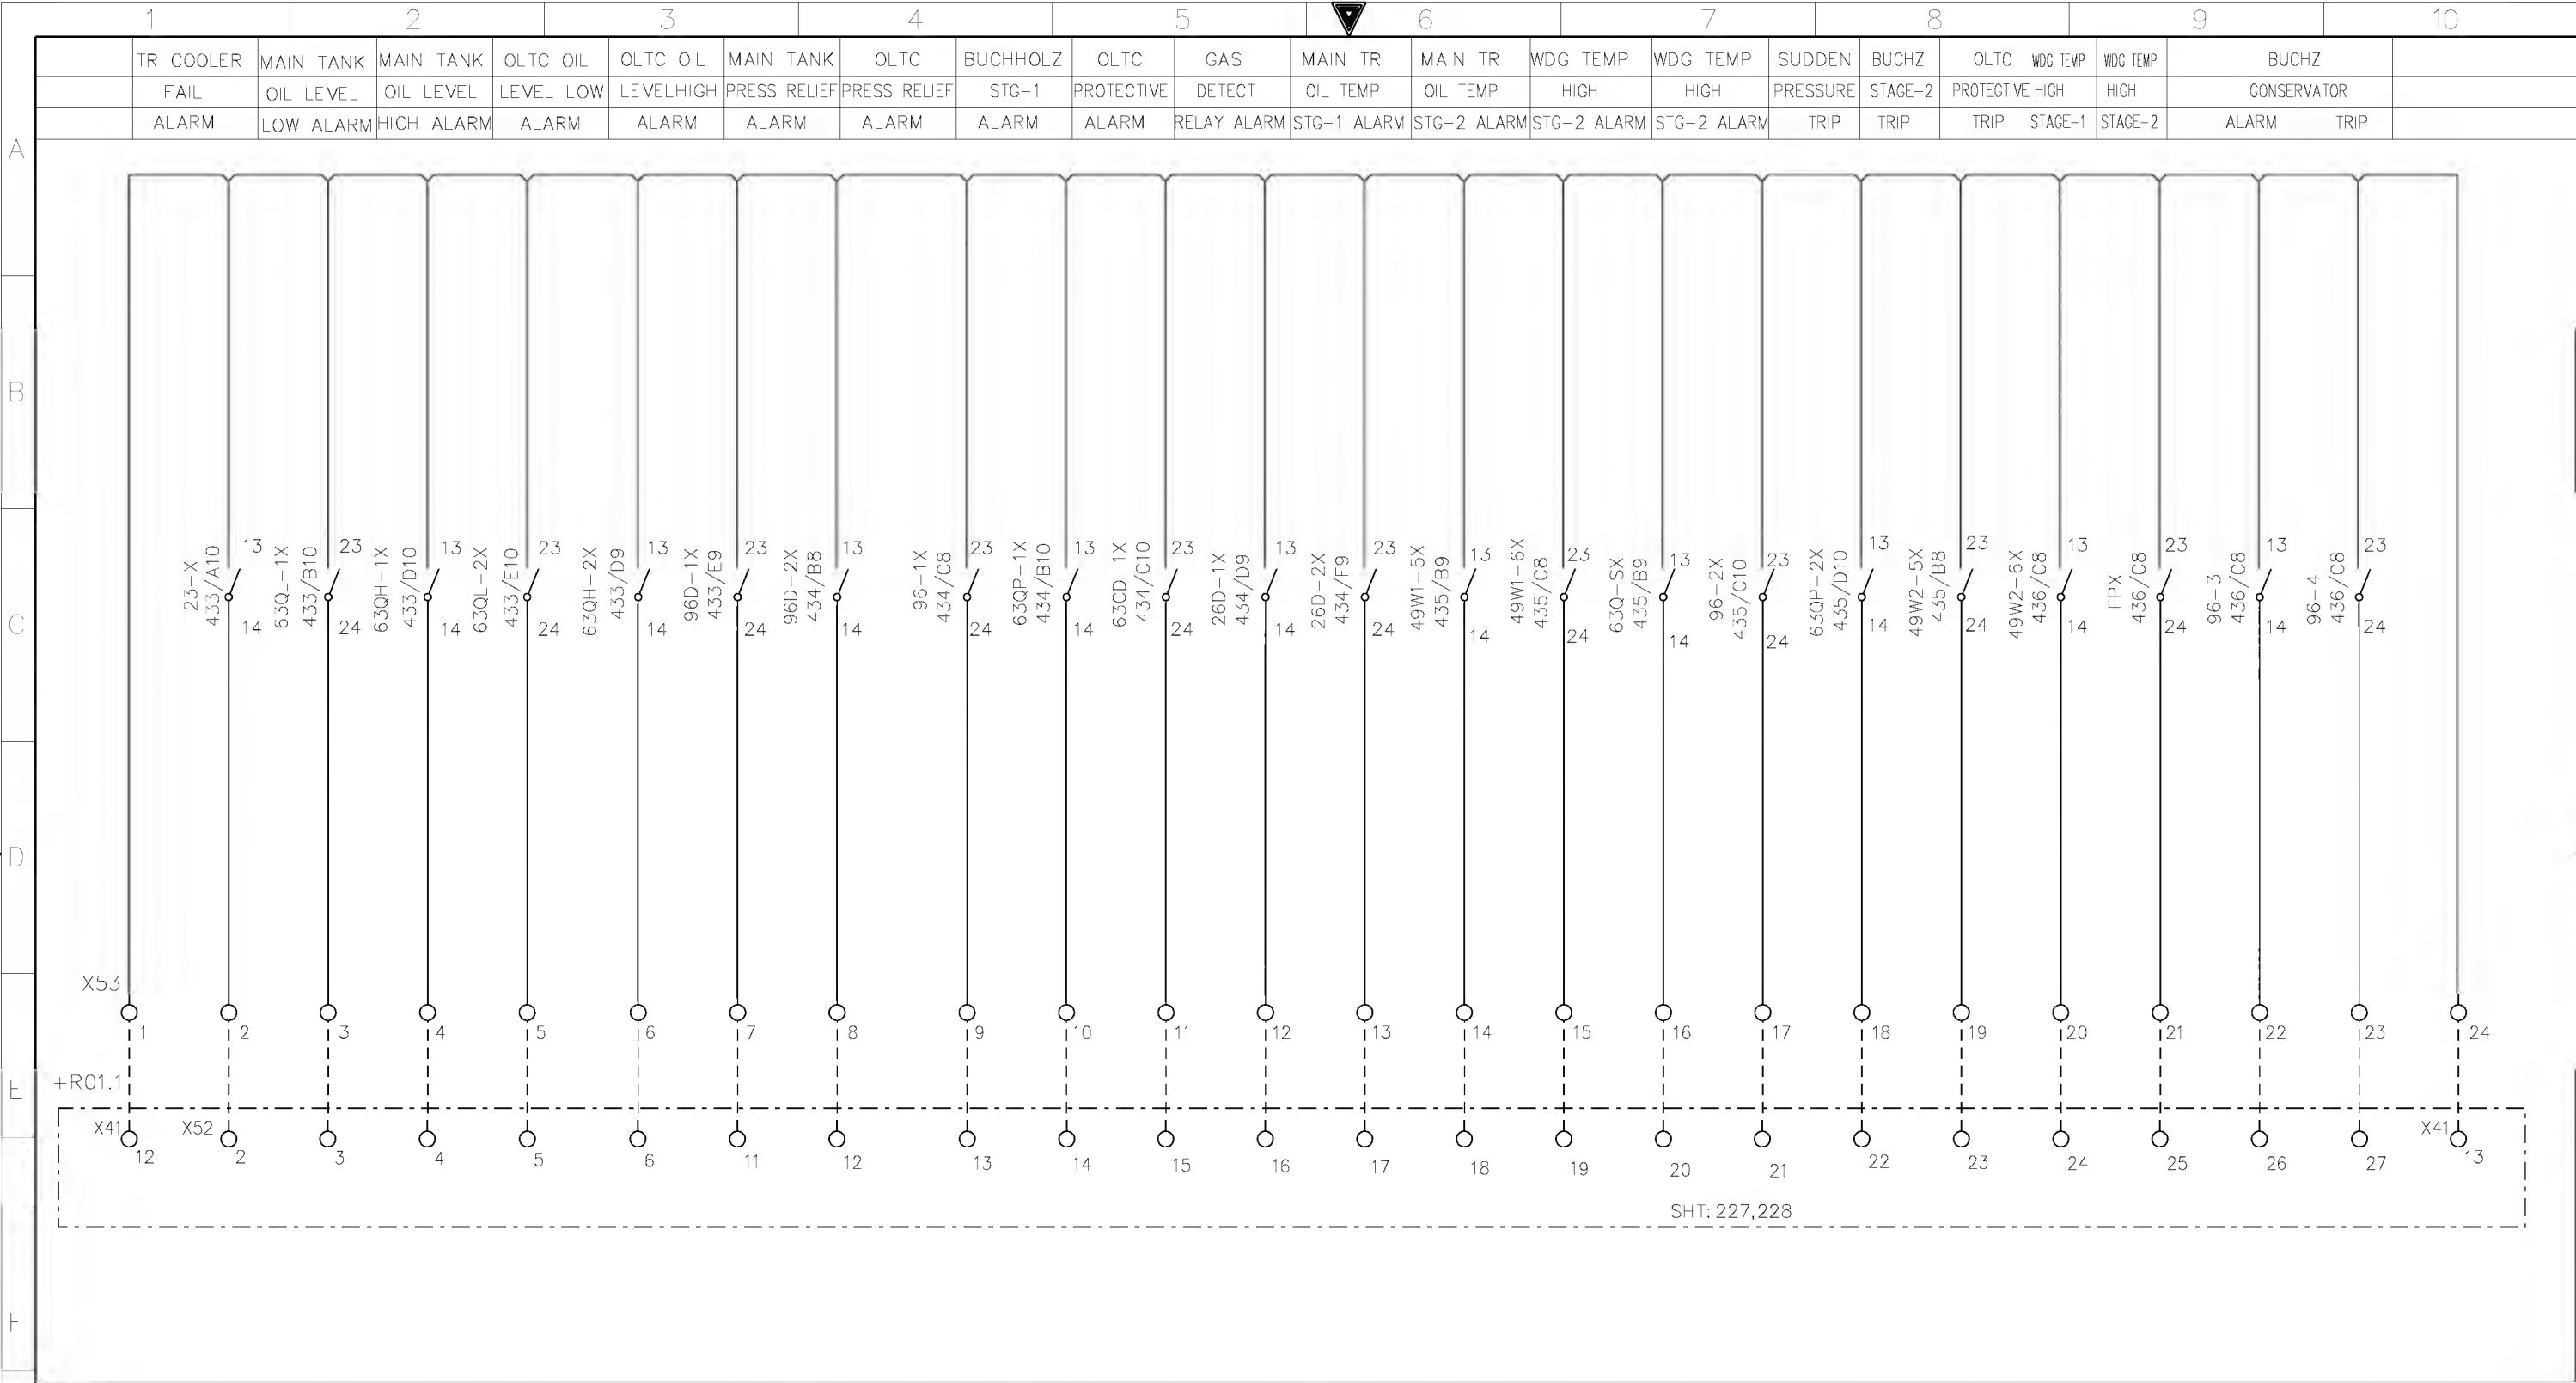


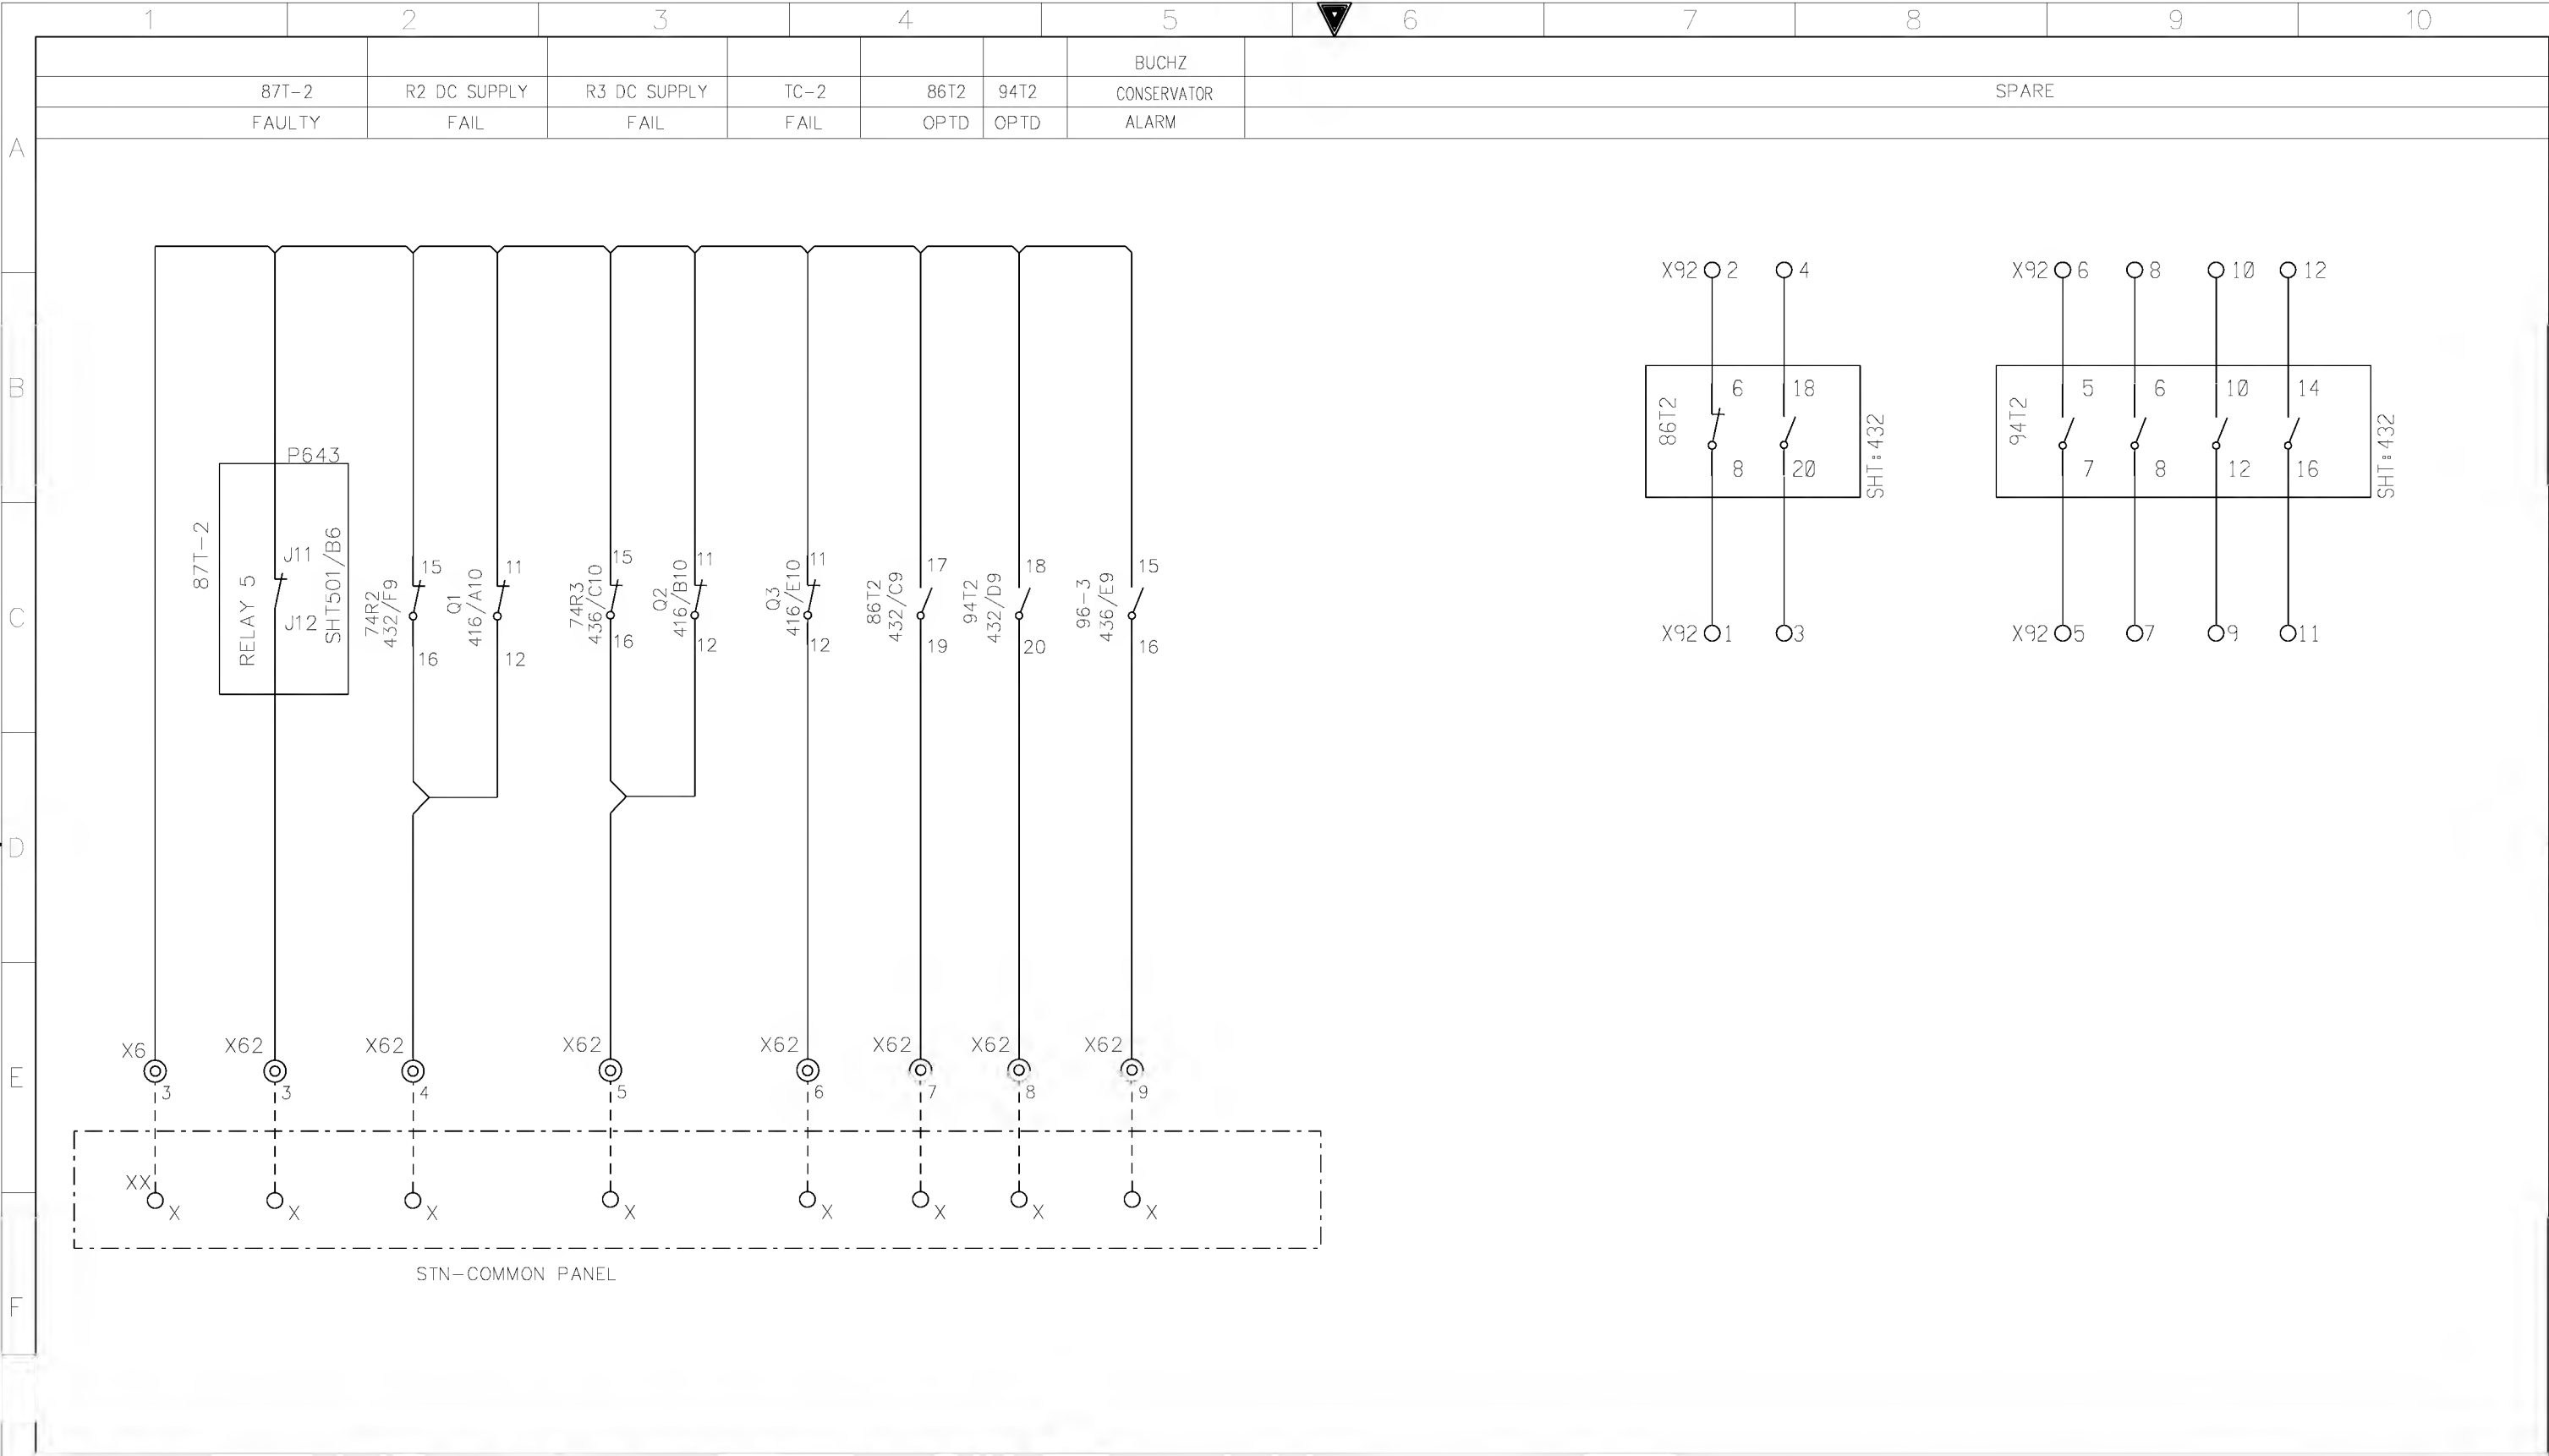

AS-BUILT BY _____ DATE _____			CONTRACT NO. 11131113/00		JOB ORDER NO. S-13656		STN COMMON ALARM CIRCUIT		<div>الشركة الوطنية لنقل الكهرباء</div> <div>National Grid sa</div>					
			DRAWN BY RIZ		CHECKED BY JKR		132/13.8kV GT-2 RELAY PANEL-2 +R01.2							
01 13 49			FACTORY ASBUILT		DATE STARTED 24.01.2013		DATE COMPLETED _____		S/S 8709-132/13.8KV IN AL-KHARJ CITY					
00 13 04			FOR APPROVAL		OPRG. DEPT. CTPC		ENG. DEPT. AUT-PSAC		RIYADH SAUDI ARABIA					
REV. NO.			DATE		DESCRIPTION				INDEX	PLANT NO.	DRAWING NUMBER	SHEET NO.		REV. NO.
									-	C421	CD-322931	SHT 499	CONT. 501	01

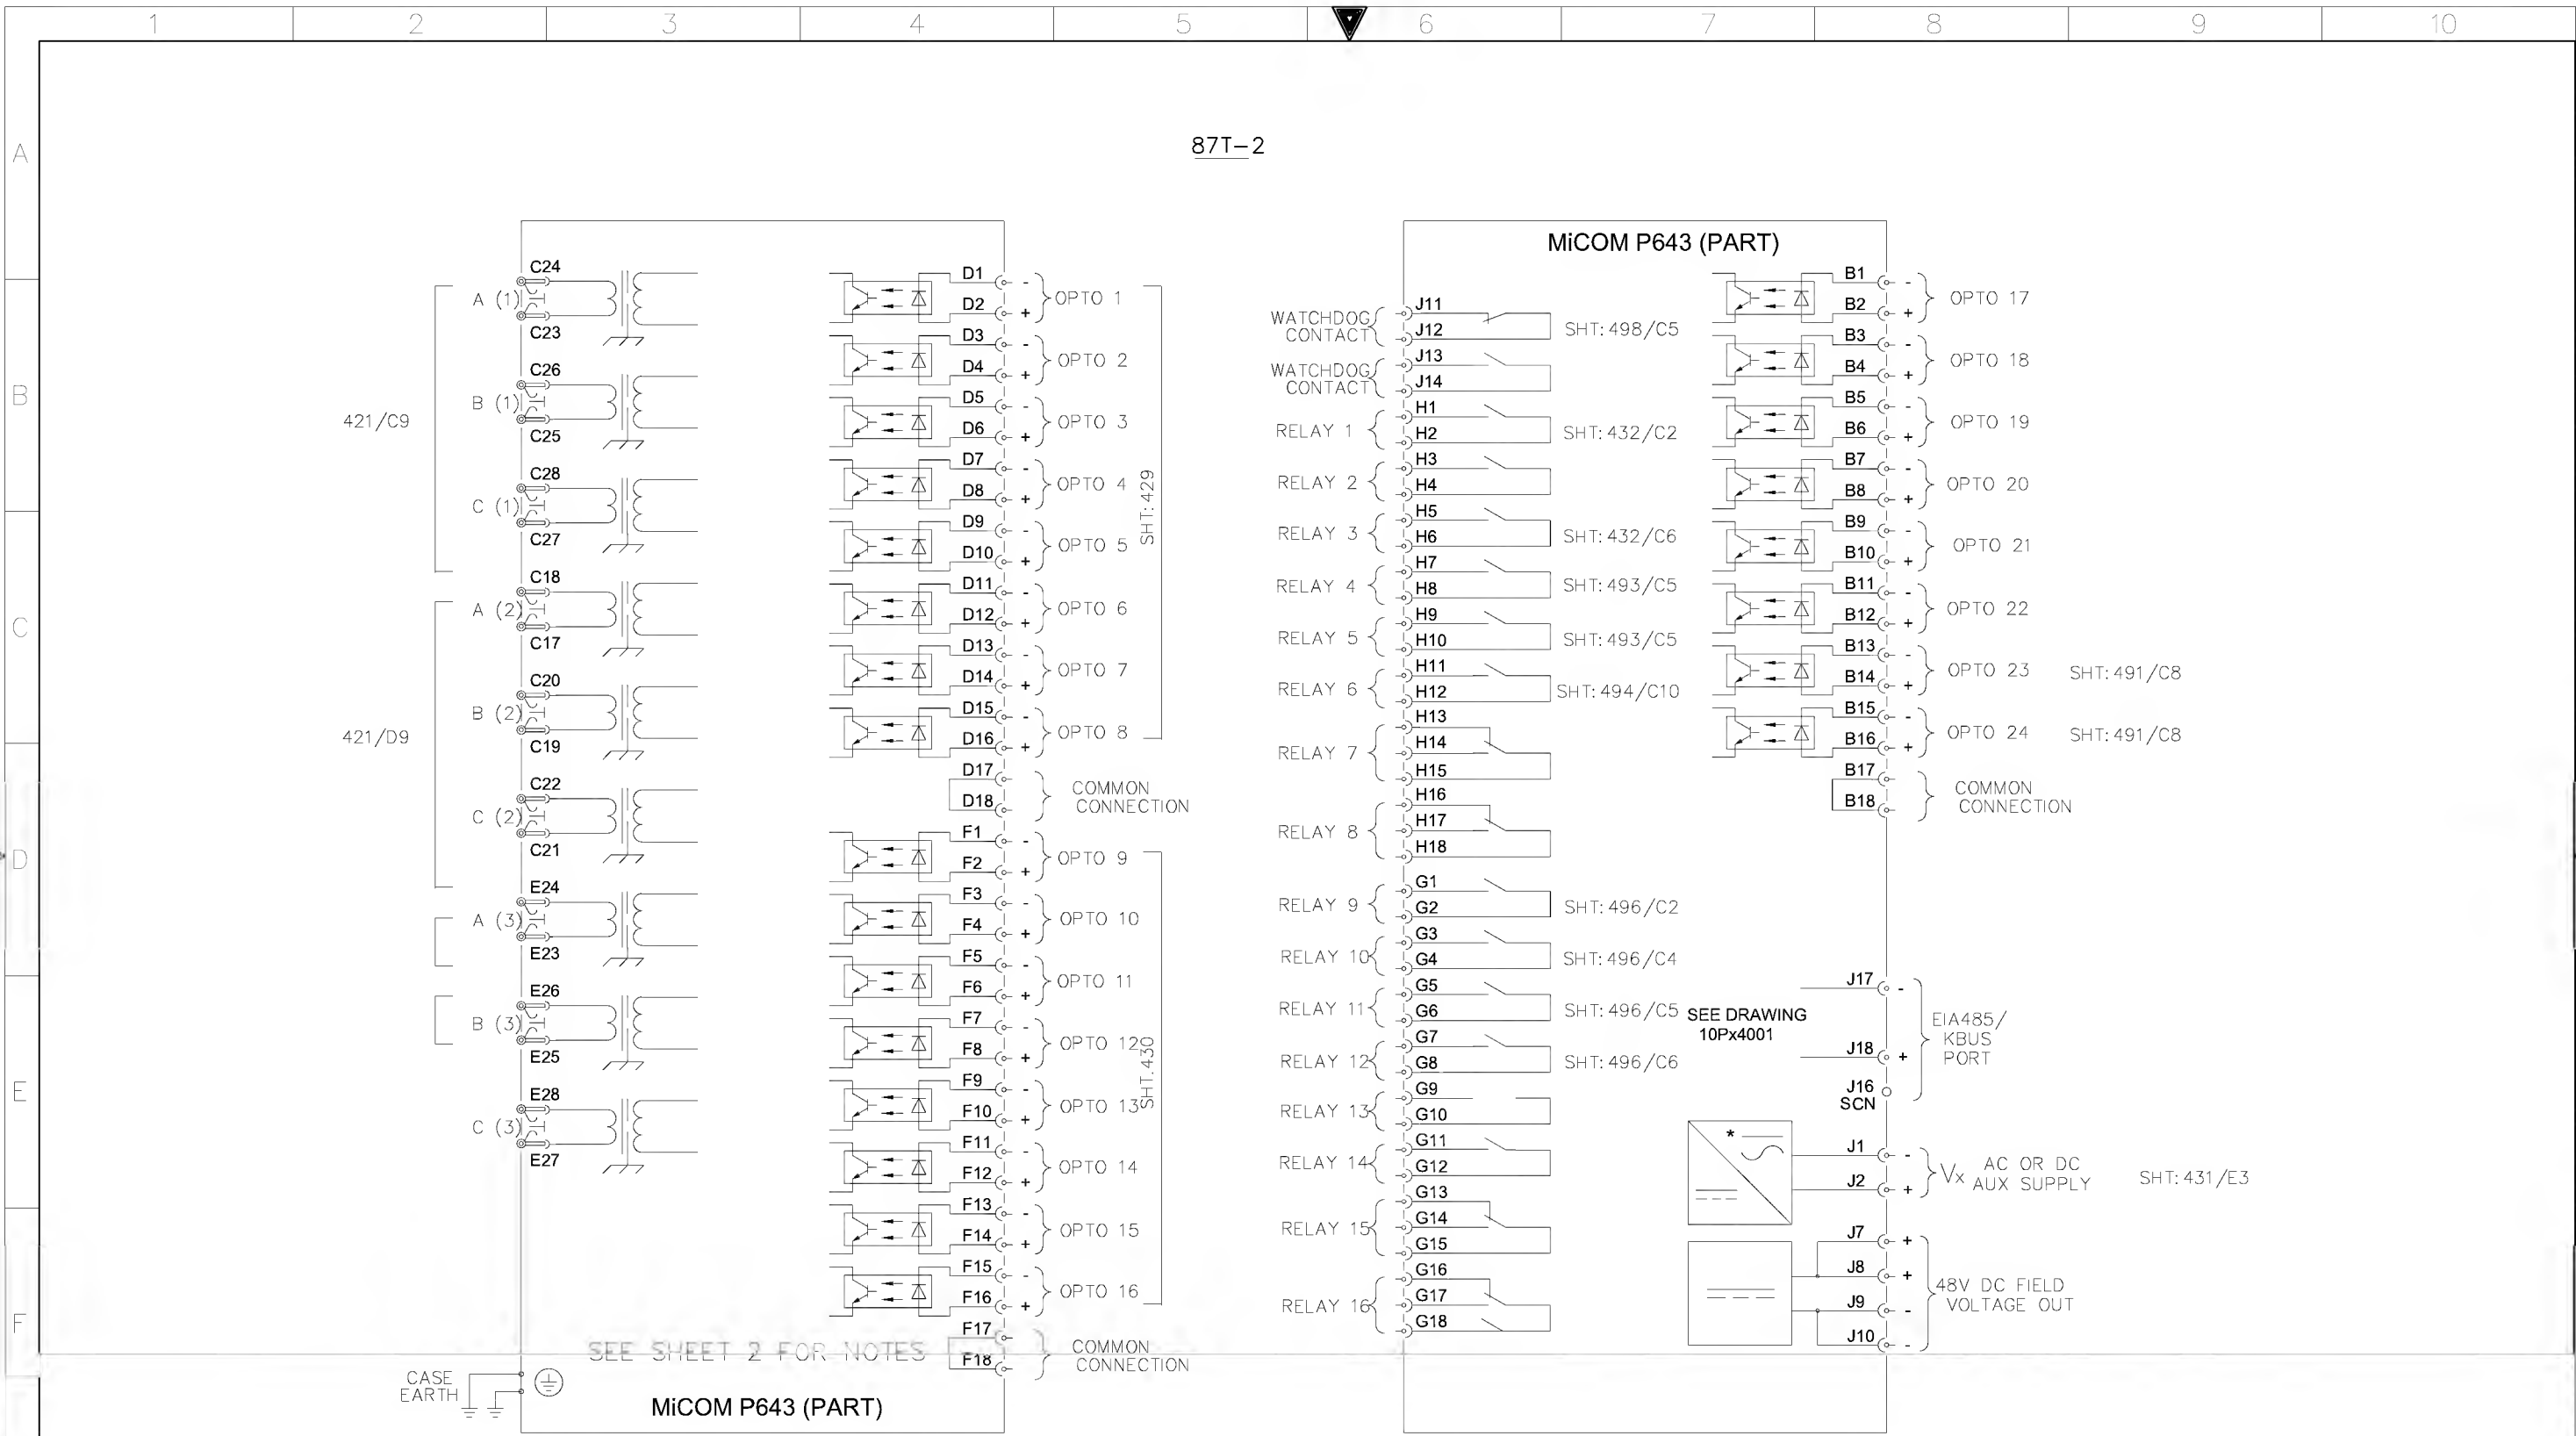

AS-BUILT BY _____ DATE _____			CONTRACT NO. 11131113/00		JOB ORDER NO. S-13656		BLOCK REFERENCE		الشركة الوطنية لنقل الكهرباء		نقل الكهرباء	
DRAWN BY RIZ CHECKED BY JKR			DATE STARTED 24.01.2013		DATE COMPLETED _____		132/13.8kV GT-2 RELAY PANEL-2 +R01.2		National Grid sa			
S/S 8709-132/13.8KV IN AL-KHARJ CITY			OPRG. DEPT. CTPD		ENG. DEPT. AUT-PSAC		SAUDI ARABIA		INDEX		PLANT NO.	
SAUDI ARABIA			CD-322931		SHT 501		CONT. 502		REV. NO.		REV. NO.	
01			13 49		FACTORY ASBUILT		FOR APPROVAL		01		01	
00			13 04		DATE STARTED 24.01.2013		DATE COMPLETED _____		01		01	
REV. NO.			DATE		DESCRIPTION		OPRG. DEPT. CTPD		ENG. DEPT. AUT-PSAC		SHT 501	

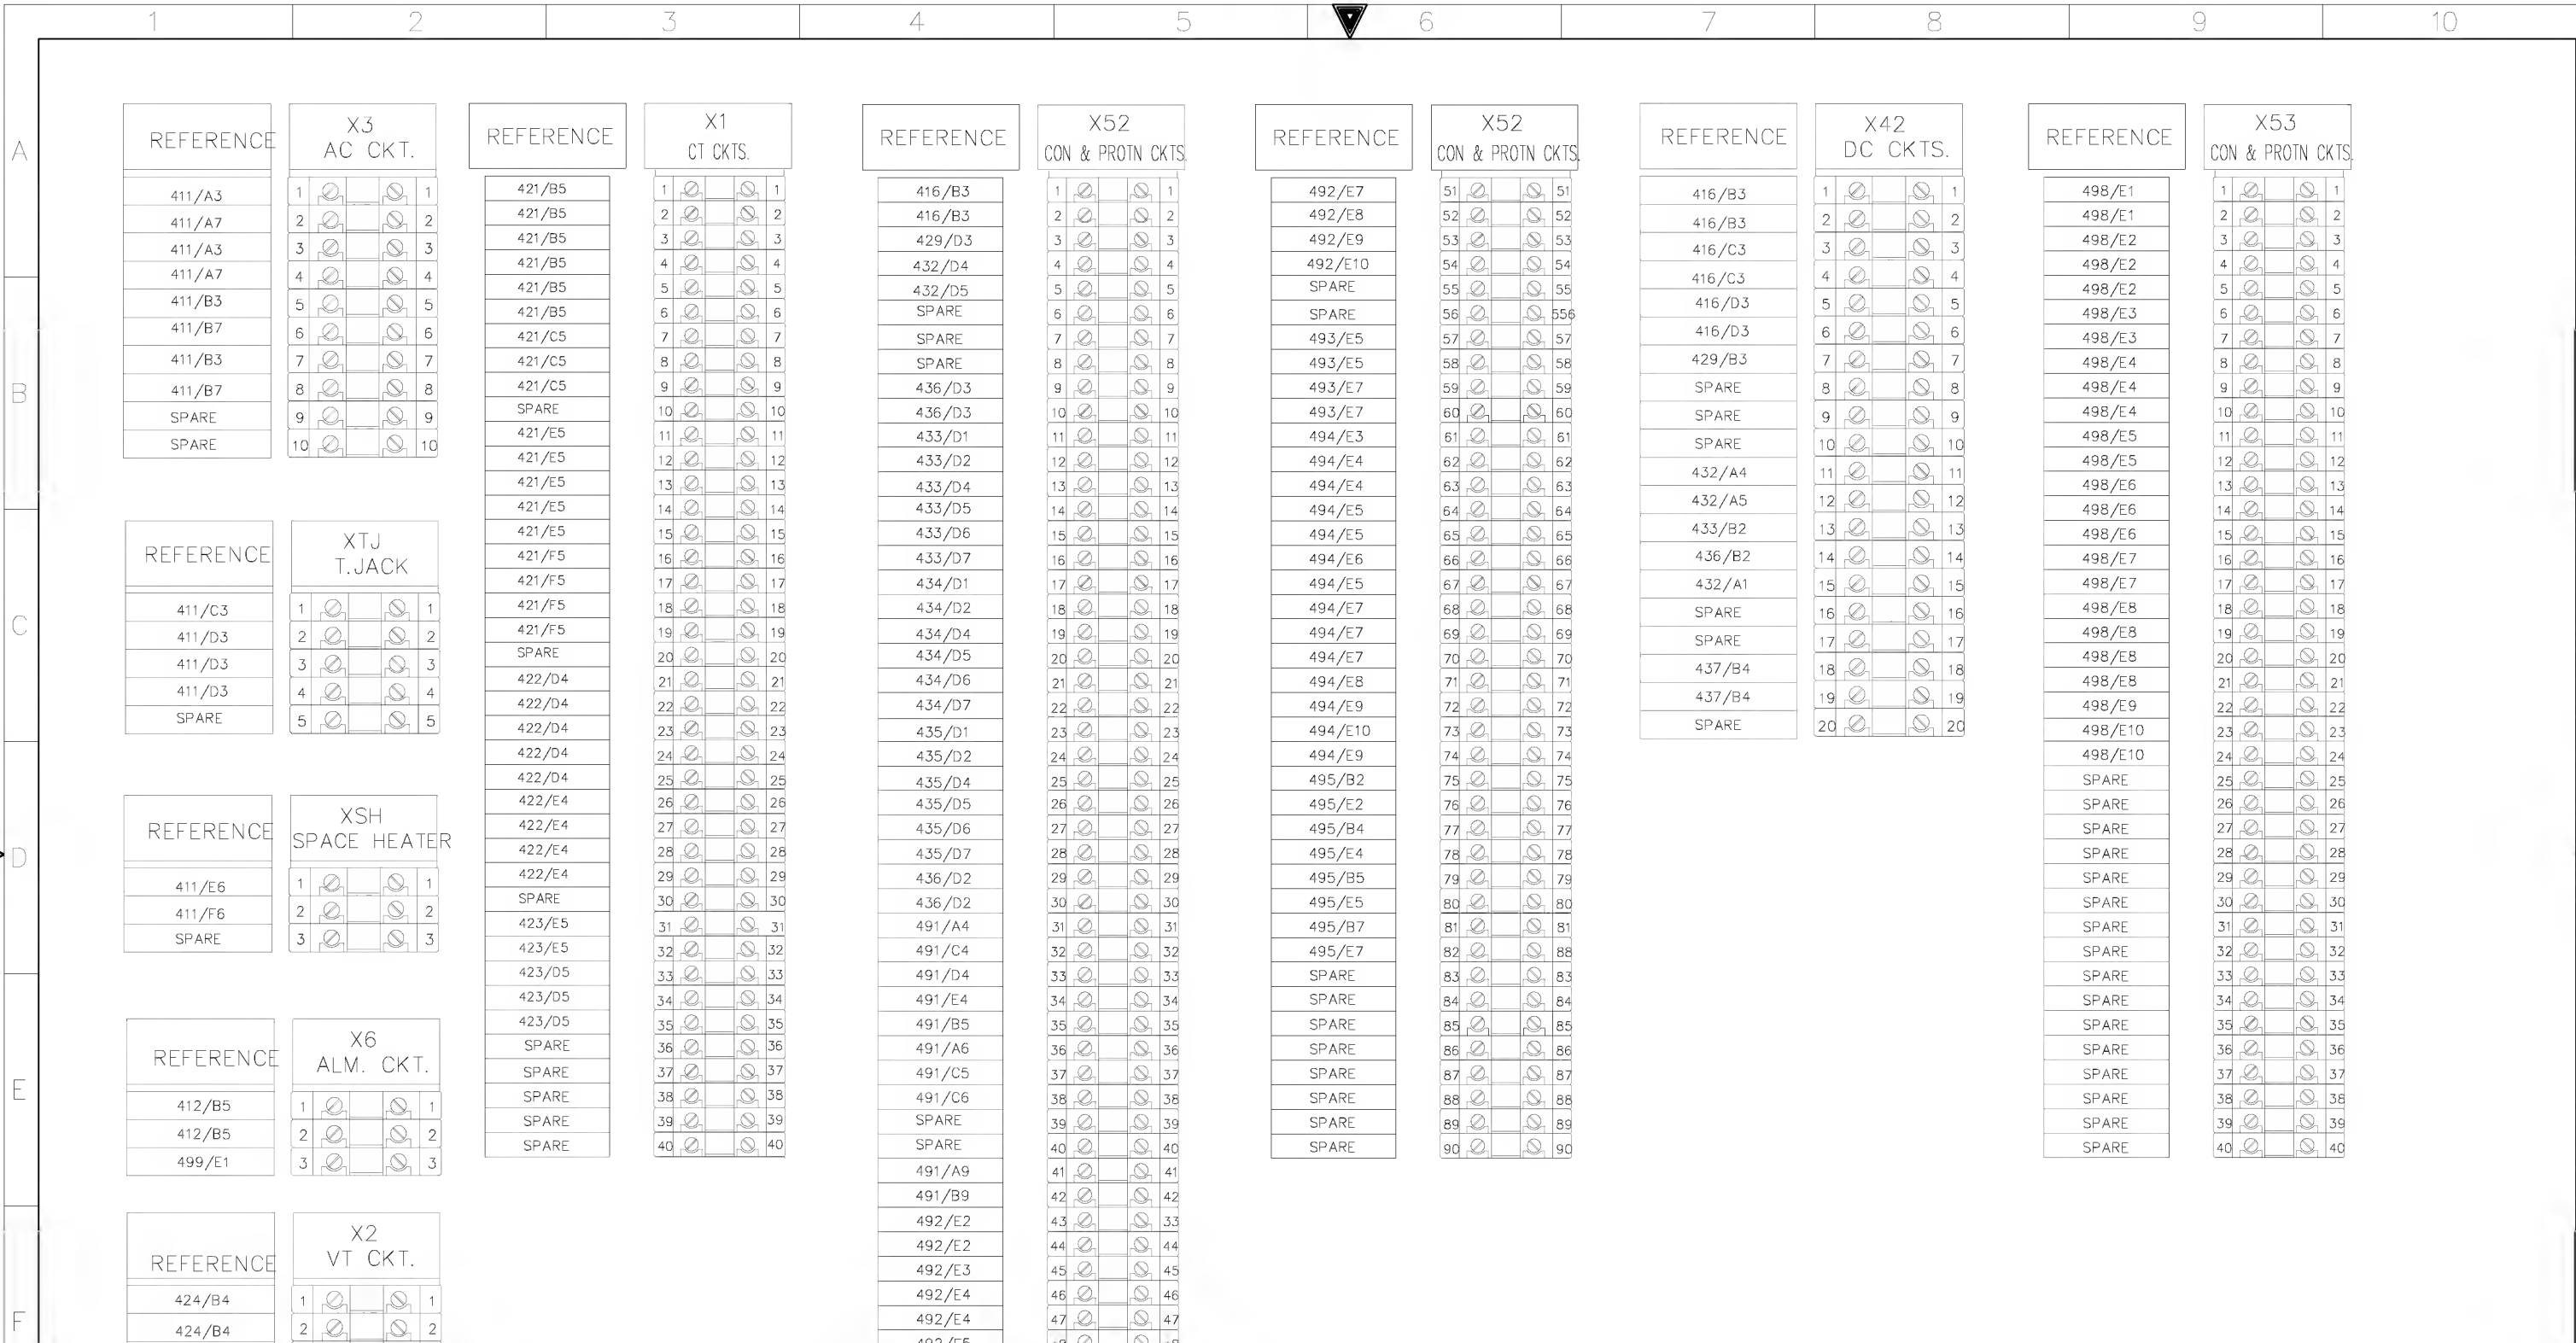

AS-BUILT BY _____ DATE _____			CONTRACT NO. 11131113/00		JOB ORDER NO. S-13656		TERMINAL BLOCK REFERENCE		<div>نقل الكهرباء الشركة الوطنية لنقل الكهرباء National Grid sa</div>	
DRAWN BY RIZ CHECKED BY JKR			DATE STARTED 24.01.2013 DATE COMPLETED _____		S/S 8709-132/13.8KV IN AL-KHARJ CITY					
REV. NO. DATE DESCRIPTION			OPRG. DEPT. CTPD ENG. DEPT. AUT-PSAC		SAUDI ARABIA		INDEX PLANT NO. DRAWING NUMBER SHEET NO. REV. NO.			
01 13 49 FACTORY ASBUILT			00 13 04 FOR APPROVAL		- C421 CD-322931		506507 01			

DMS VECTOR

NG/D2-D (2012/01) NGD200

	1	2	3	4	5	6	7	8	9	10
A										
B										
C										
D										
E										
F										

REFERENCE

414/B3
414/B4
498/E1
498/E2
498/E2
498/E3
498/E3
498/E4
498/E4
SPARE
SPARE
X62
ALARM CKT

1				1
2				2
3				3
4				4
5				5
6				6
7				7
8				8
9				9
10				10
11				11
12				12
13				13
14				14
15				15
16				16
17				17
18				18
19				19
20				20

REFERENCE

499/C6
499/B6
499/C7
499/B7
499/C8
499/B8
499/C8
499/B8
499/C8
499/B8
499/C9
499/B9
SPARE
SPARE
X92
SPARE

1				1
2				2
3				3
4				4
5				5
6				6
7				7
8				8
9				9
10				10
11				11
12				12
13				13
14				14
15				15
16				16
17				17
18				18
19				19
20				20
21				21
22				22
23				23
24				24
25				20

AS-BUILT BY _____ DATE _____			CONTRACT NO. 11131113/00	JOB ORDER NO. S-13656
01	13 49	FACTORY ASBUILT	DRAWN BY RIZ	CHECKED BY JKR
00	13 04	FOR APPROVAL	DATE STARTED 24.01.2013	DATE COMPLETED _____
REV. NO.	DATE	DESCRIPTION	OPRG. DEPT. CTPD	ENG. DEPT. AUT-PSAC

TERMINAL BLOCK REFERENCE	
132/13.8kV GT-2 RELAY PANEL-2 +R01.2	
S/S 8709-132/13.8KV IN AL-KHARJ CITY	
RIYADH	SAUDI ARABIA

الشركة الوطنية لنقل الكهرباء				نقل الكهرباء		
				National Grid SA		
INDEX	PLANT NO.	DRAWING NUMBER		SHEET NO.		REV. NO.
-	C421	CD-322931		SHT	CONT.	01
				507	NIL	